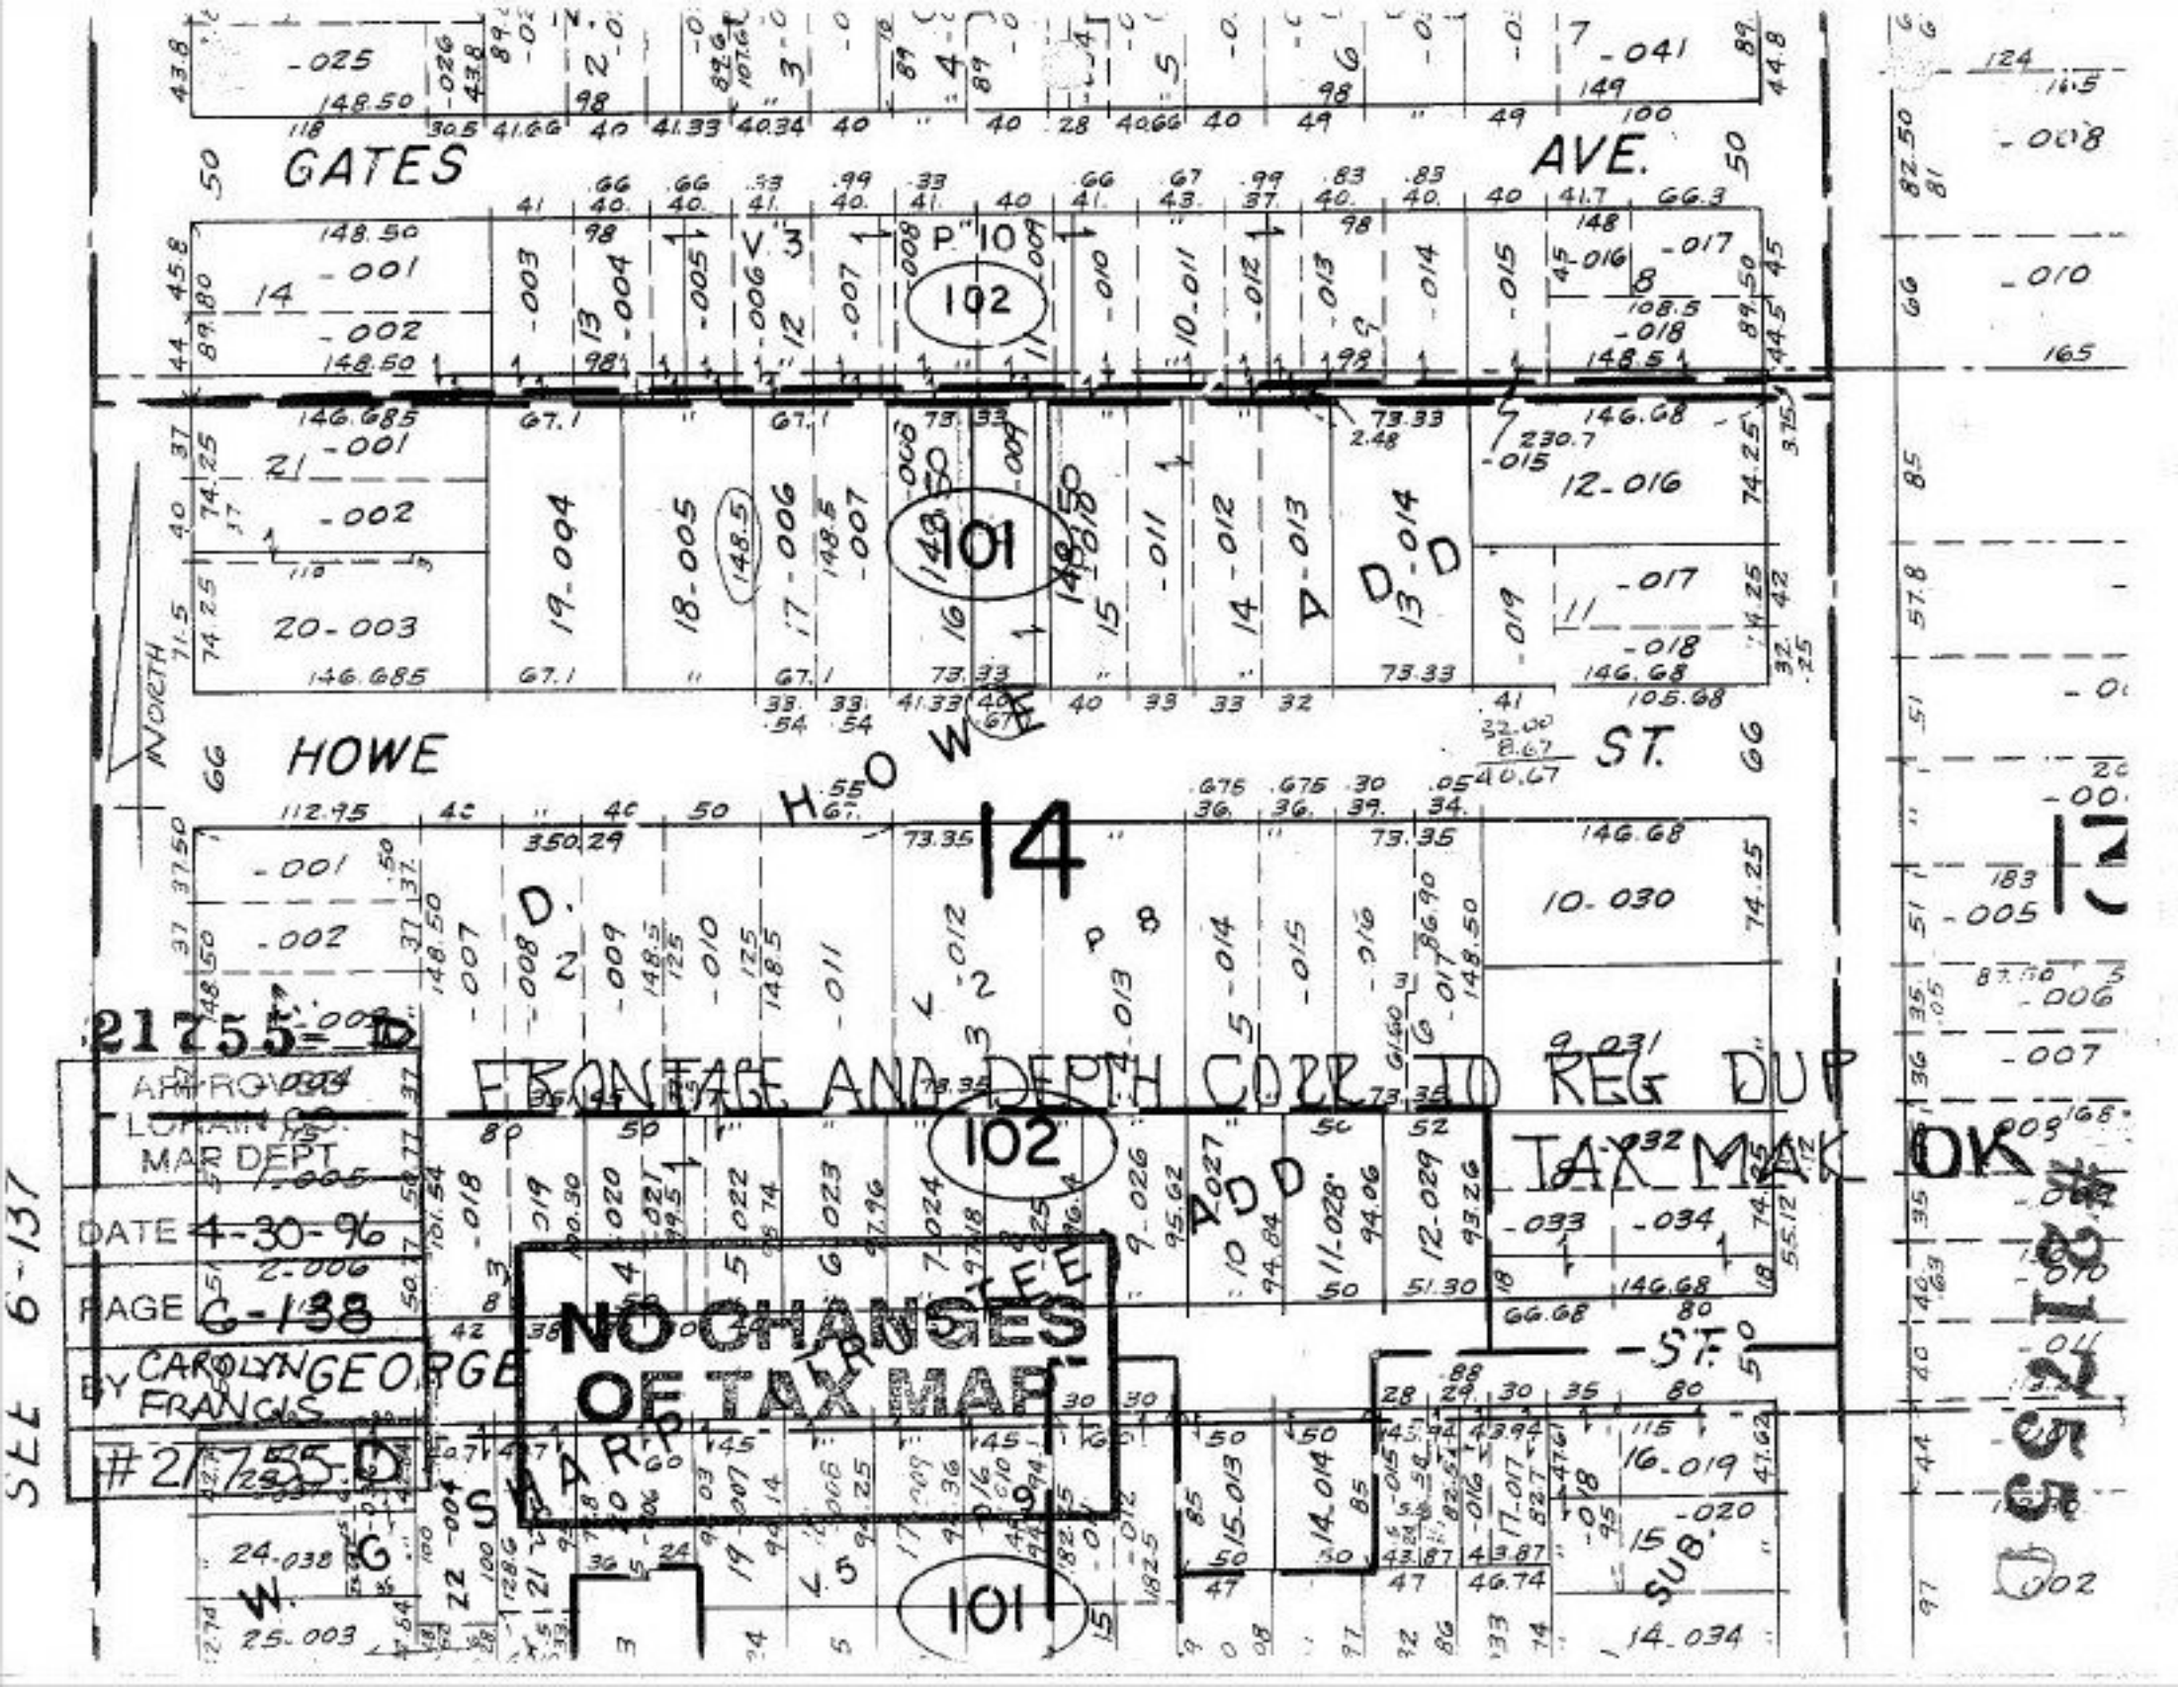
GATES AVE.
HOWE ST.
NORTH
HOWARD
P. 10
102
101
14
ADD
FRONTAGE AND DEPTH CORR TO REG DUP
NO CHANGES OF TAX MAP
TAX MAP OK
21755-D
APPROVED
MAP DEPT.
DATE 4-30-96
PAGE C-138
BY CAROLYN GEORGE FRANCIS
#21755-D
SEE 6-137