#21756-D

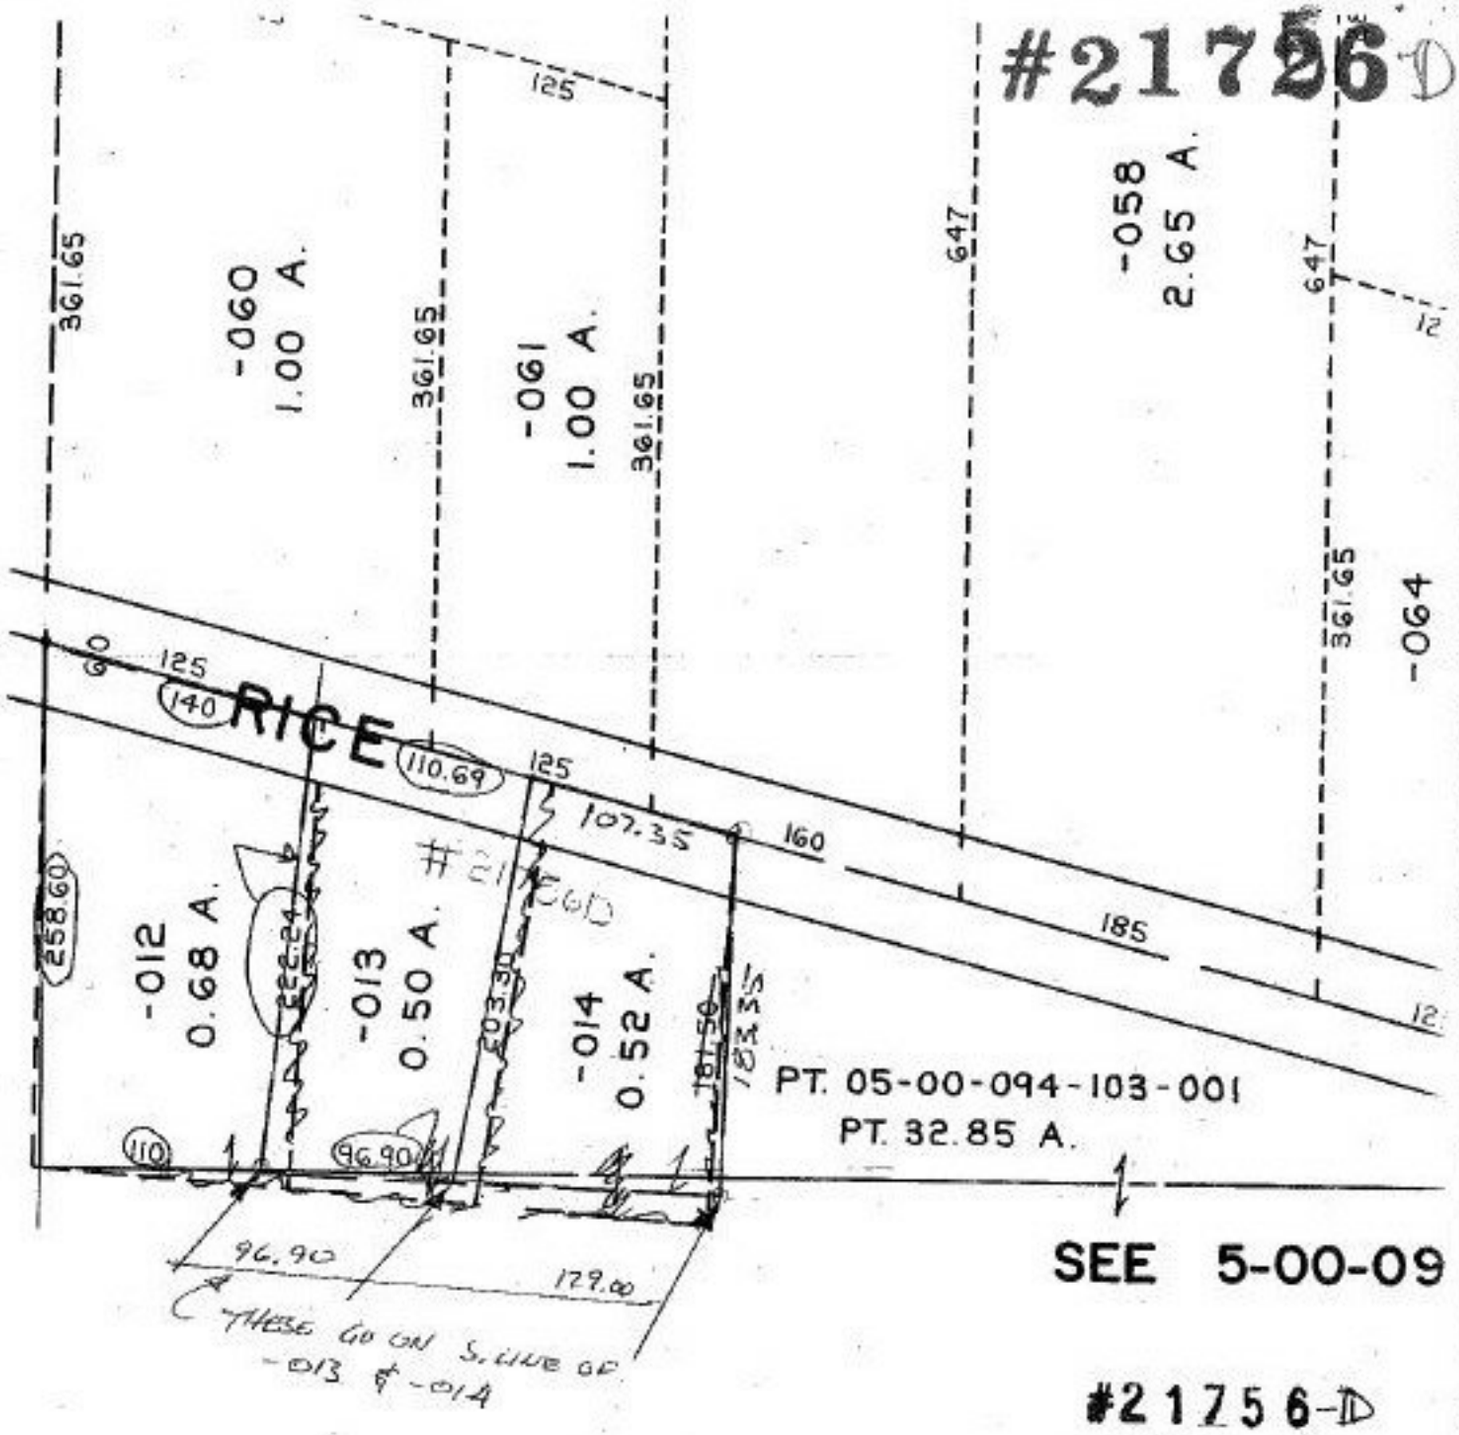

SEE 5-00-09

#21756-D

DEED CK. & MAP CORR. CK'D 3/14/97

APPROVED
LORAIN CO.
MAP DEPT.
DATE 5-1-96
5-00-09
C.E. FRANCK
21756-D

AMHERST TWP

SCALE: 1" = 100'