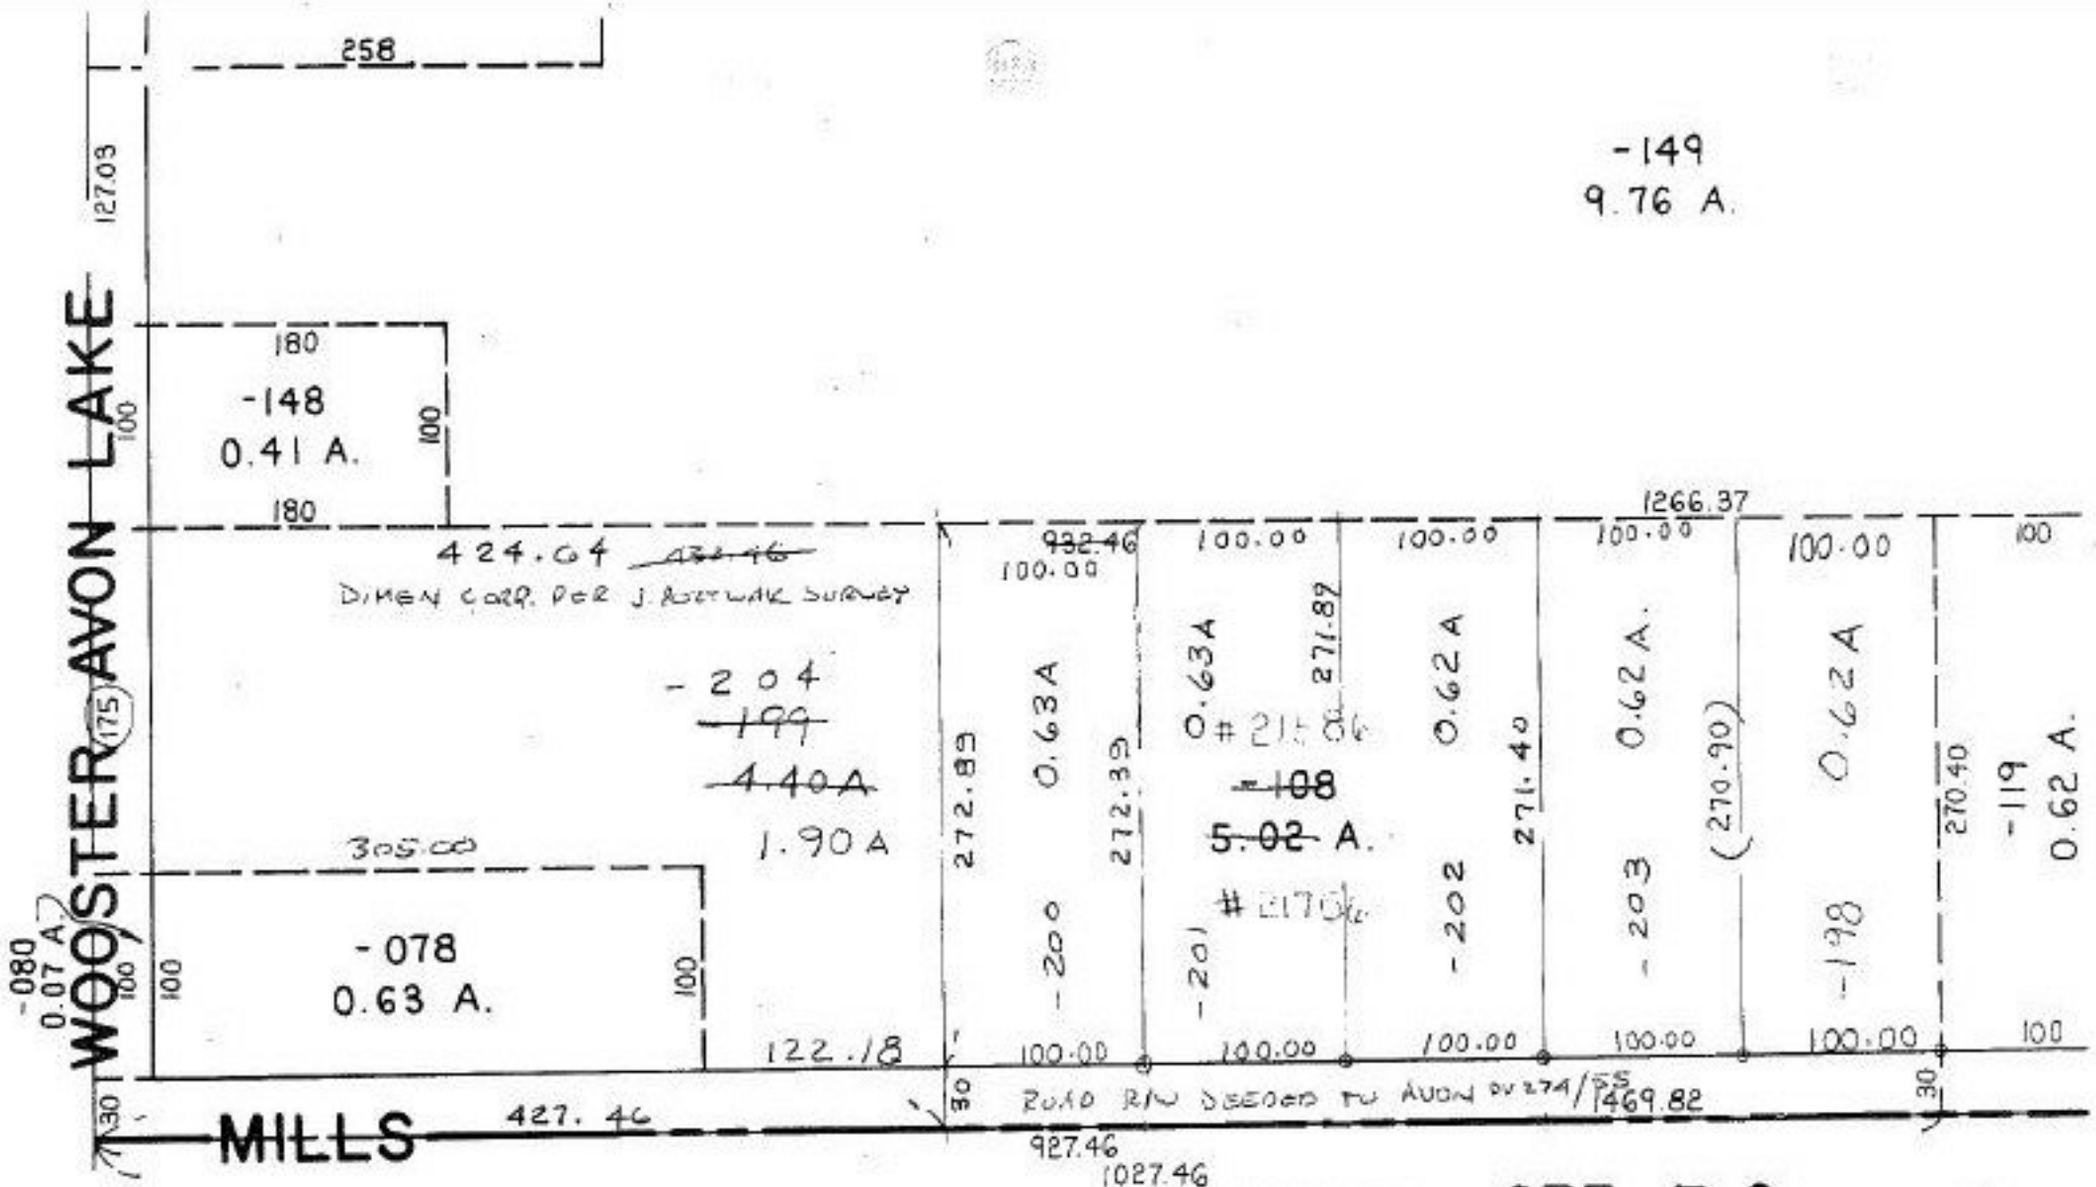

W 1/2 SE 1/4 SEC. ~~13~~

P.P.NO. 04-00-013-000 CLOSURE:1, 2 0.63ac 0.04:10,000
PRIOR INST:. O.R. 1201/443 3. 0.62ac. 0.10:10,00
4. 0.62ac. 0.04:10,000

SURVEYED BY: JOHN POZYWAK REG. SURVEYOR