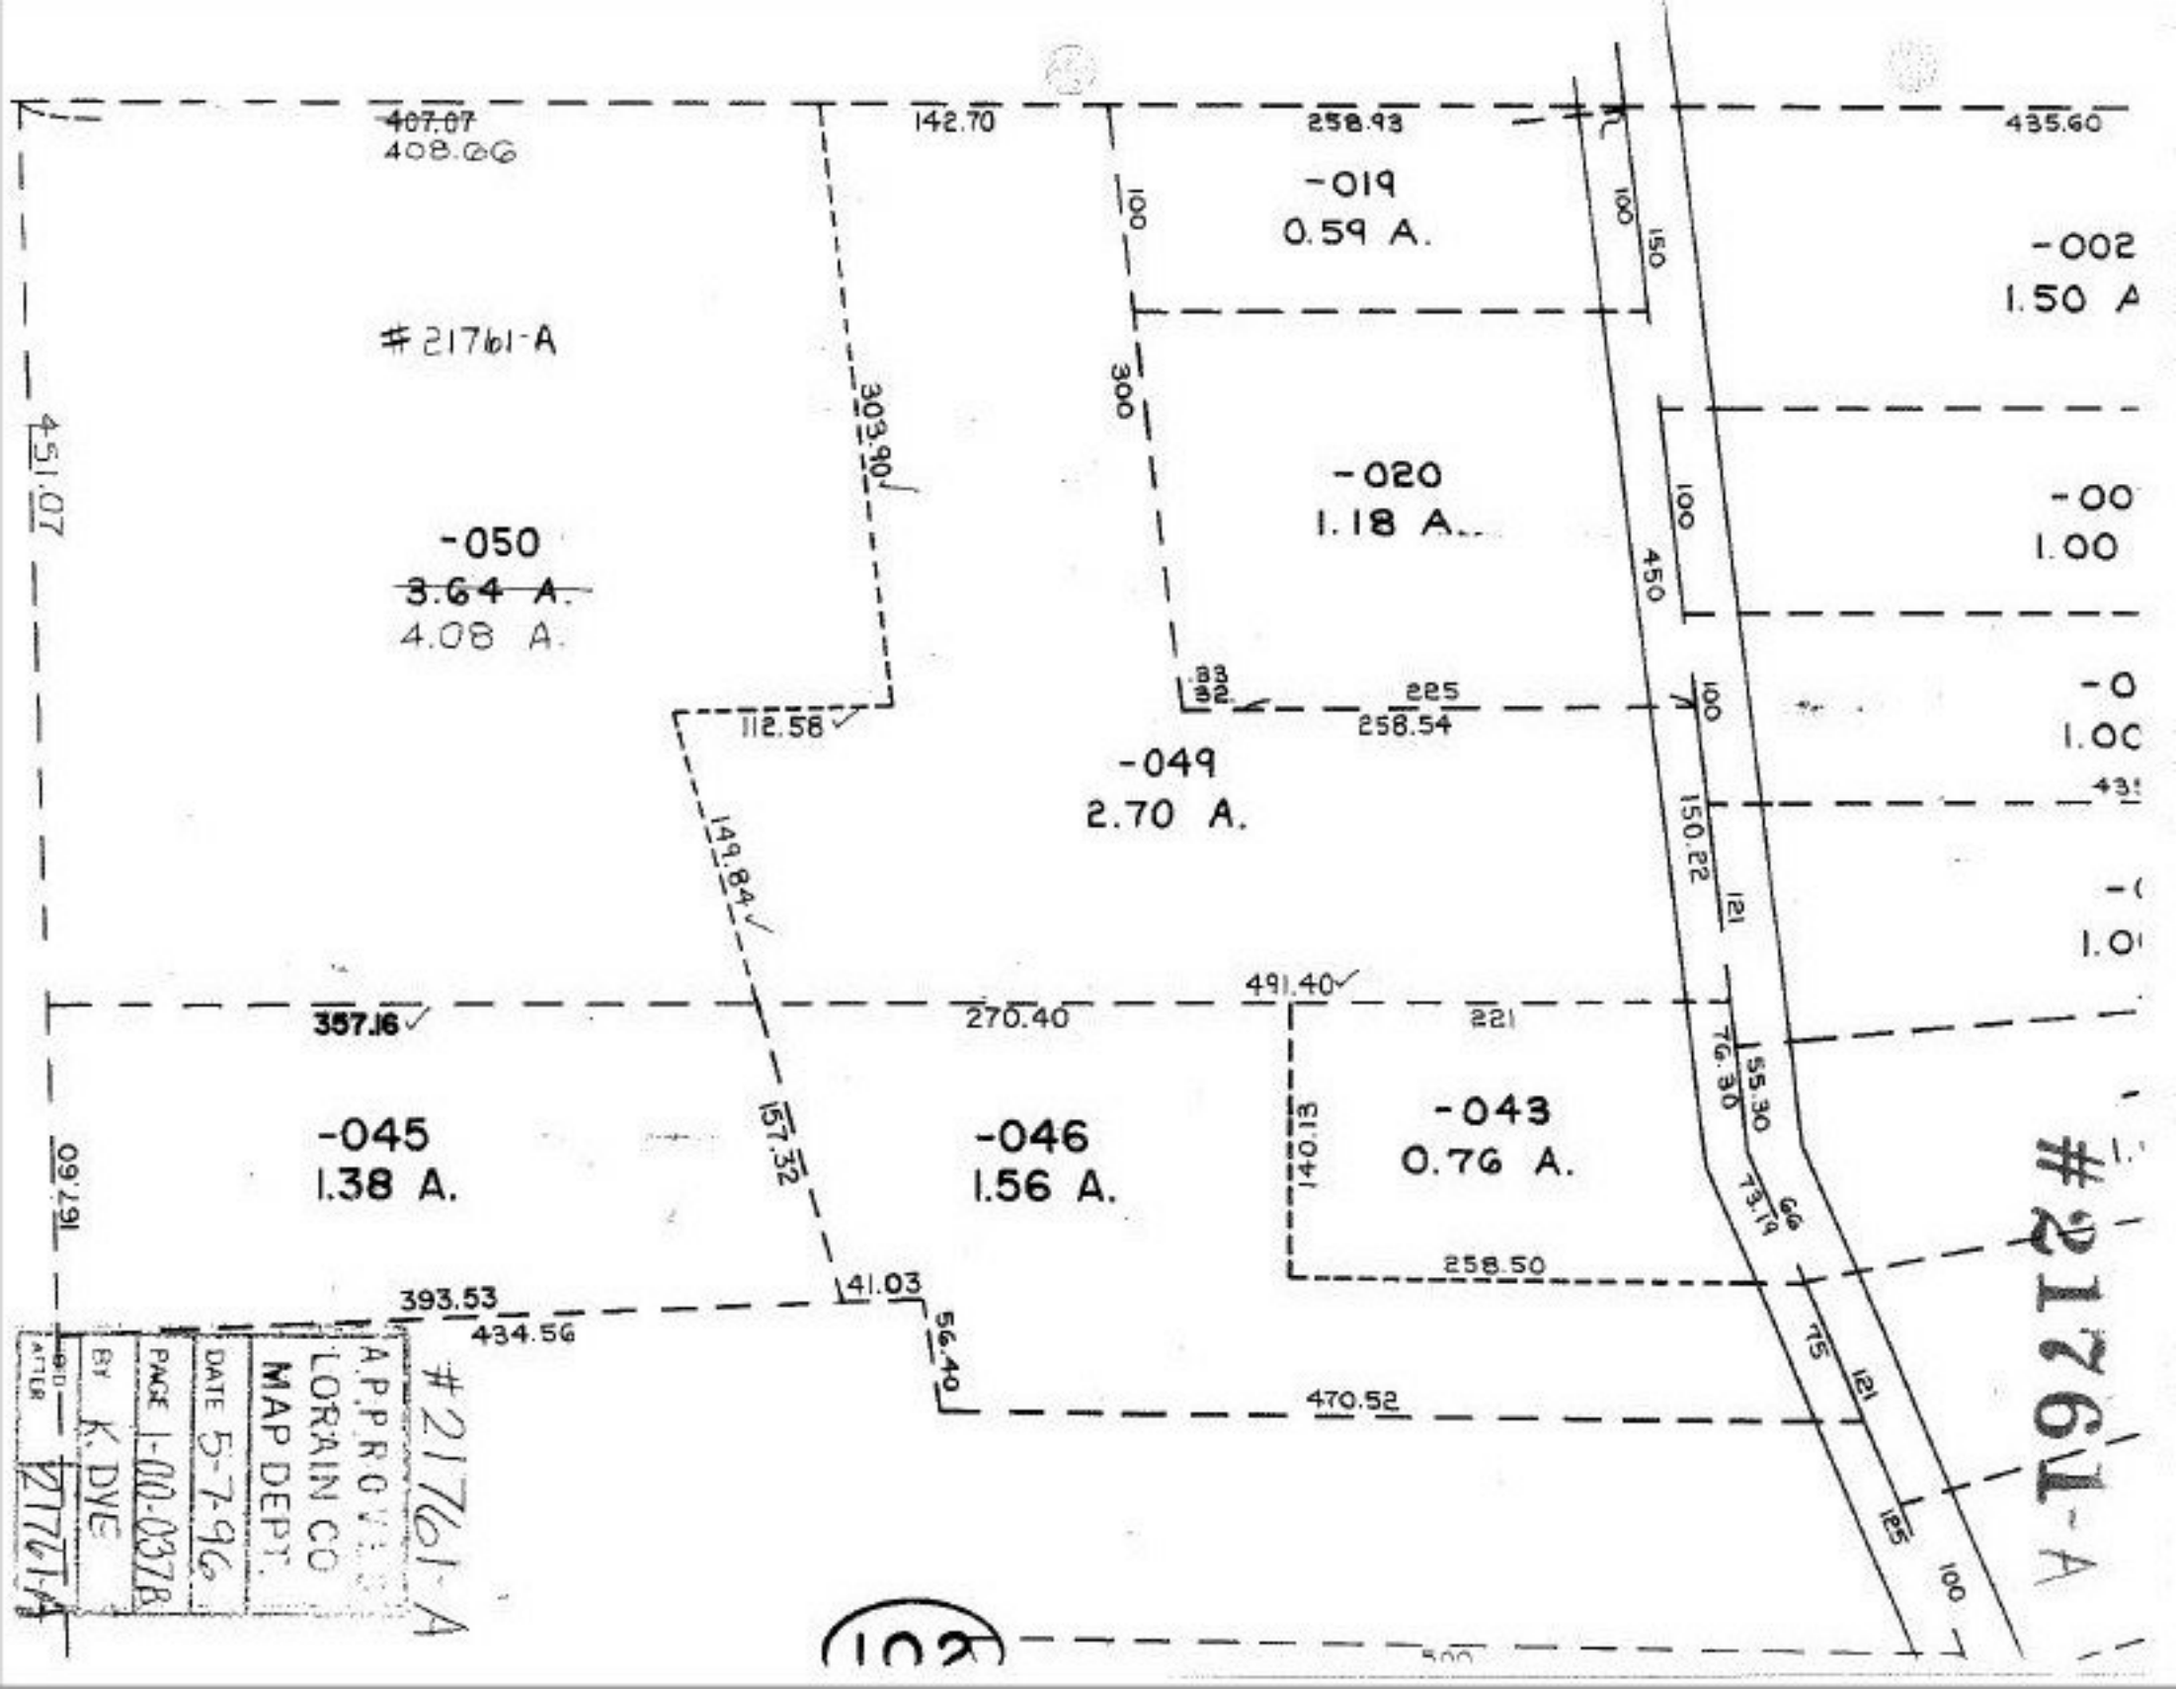
407.07
408.06
142.70
258.93
435.60
-019
0.59 A.
100
150
-002
1.50 A
#21761-A
300
303.90
-020
1.18 A.
100
450
-00
1.00
-050
3.64 A.
4.08 A.
451.07
112.58
88
82
225
258.54
100
-049
2.70 A.
150.22
121
-0
1.00
149.84
491.40
357.16
270.40
221
76.30
55.30
73.19
66
-045
1.38 A.
-046
1.56 A.
-043
0.76 A.
140.13
157.32
09.791
258.50
393.53
434.56
141.03
56.40
470.52
75
121
125
100
#21761-A
APPROVED
LORAIN CO
MAP DEPT.
DATE 5-7-96
PAGE 1-00-037B
BY K. DYE
ADD'D AFTER
#21761-A
102