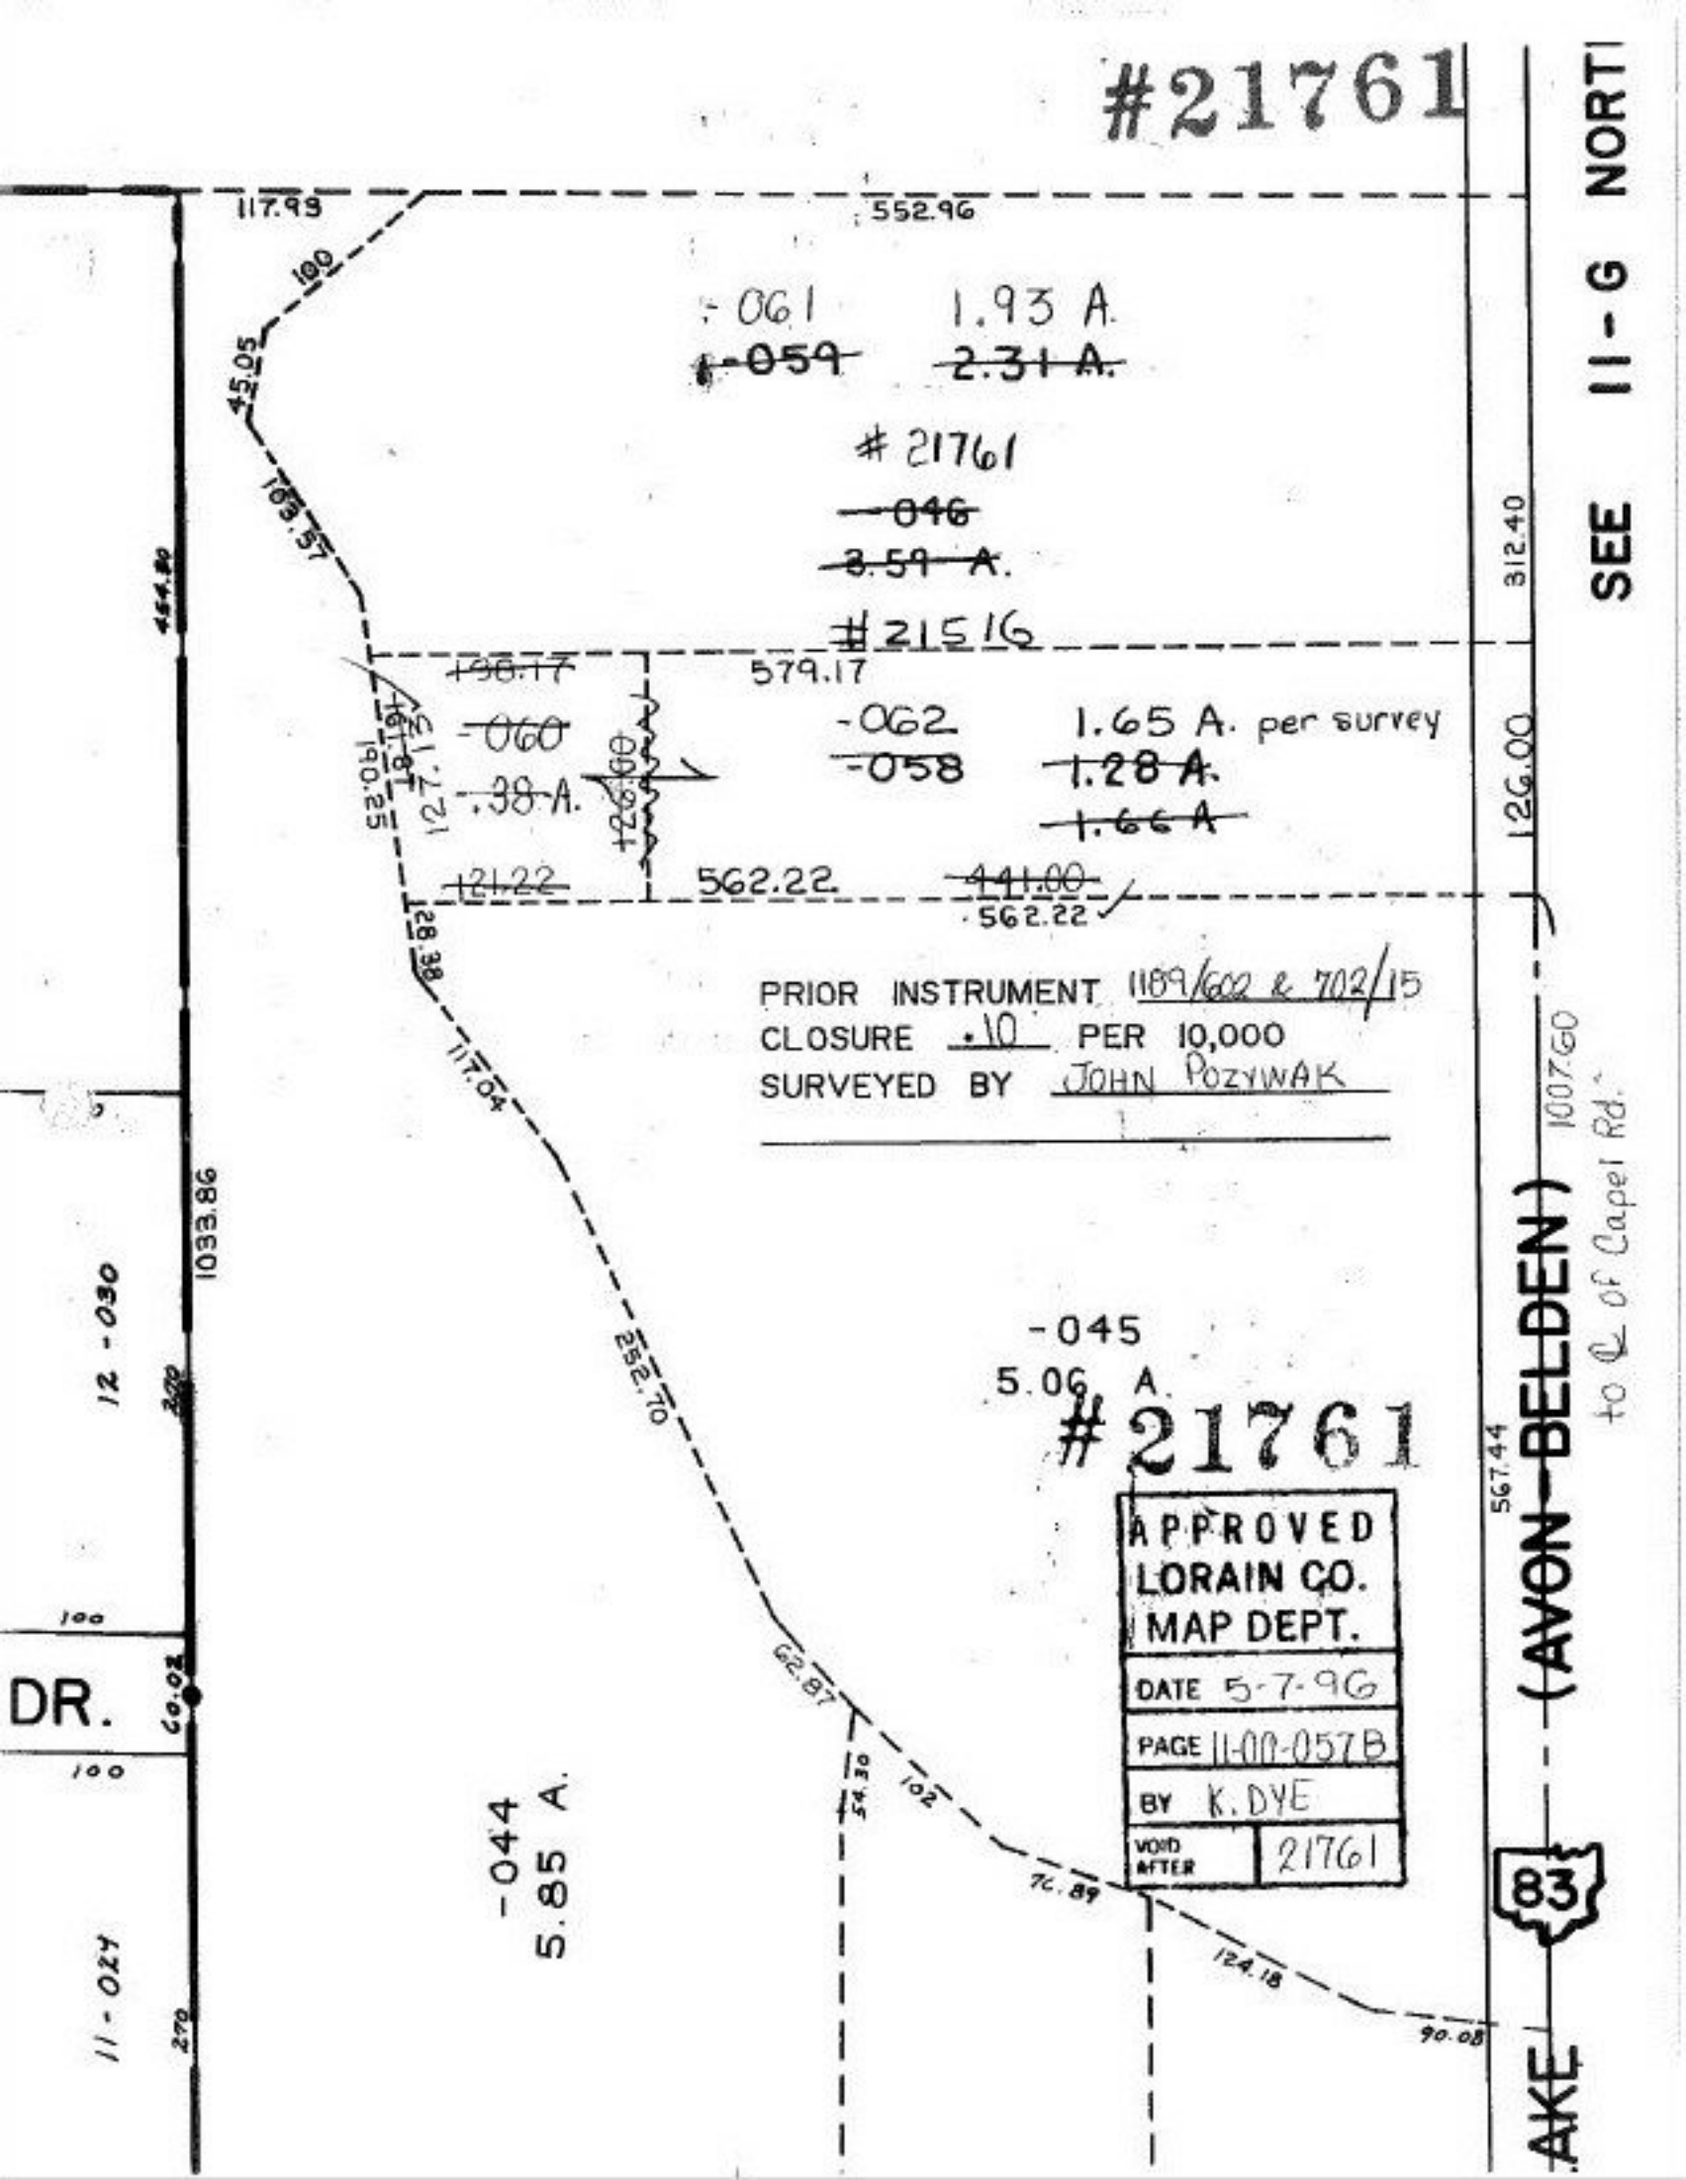
#21761
117.93
552.96
100
45.05
103.57
-061 1.93 A.
~~-059~~ ~~2.31 A.~~
#21761
~~-046~~
~~3.59 A.~~
#21516
579.17
~~198.17~~
~~-060~~
~~.38 A.~~
127.13
190.25
~~126.00~~
-062 1.65 A. per survey
~~-058~~ ~~1.28 A.~~
~~1.66 A~~
~~121.22~~
562.22
~~441.00~~
562.22
28.38
117.04
PRIOR INSTRUMENT 1189/602 & 702/15
CLOSURE .10 PER 10,000
SURVEYED BY JOHN POZYWAK
1033.86
12-030
252.70
-045
5.06 A.
#21761
APPROVED
LORAIN CO.
MAP DEPT.
DATE 5-7-96
PAGE 11-00-057B
BY K. DYE
VOID AFTER 21761
62.87
54.30
102
76.89
124.18
90.08
-044
5.85 A.
100
DR.
60.02
100
11-024
270
312.40
126.00
1007.60
567.44
SEE 11-G NORTH
(AVON-BELDEN)
to ℄ of Capel Rd.
83
AKE