#21763-D

CITY / TWP. <-> CORP. LINE <-> CITY OF ELYRIA ORD # 72-208 11-24-72

2

-037
105.88 A.

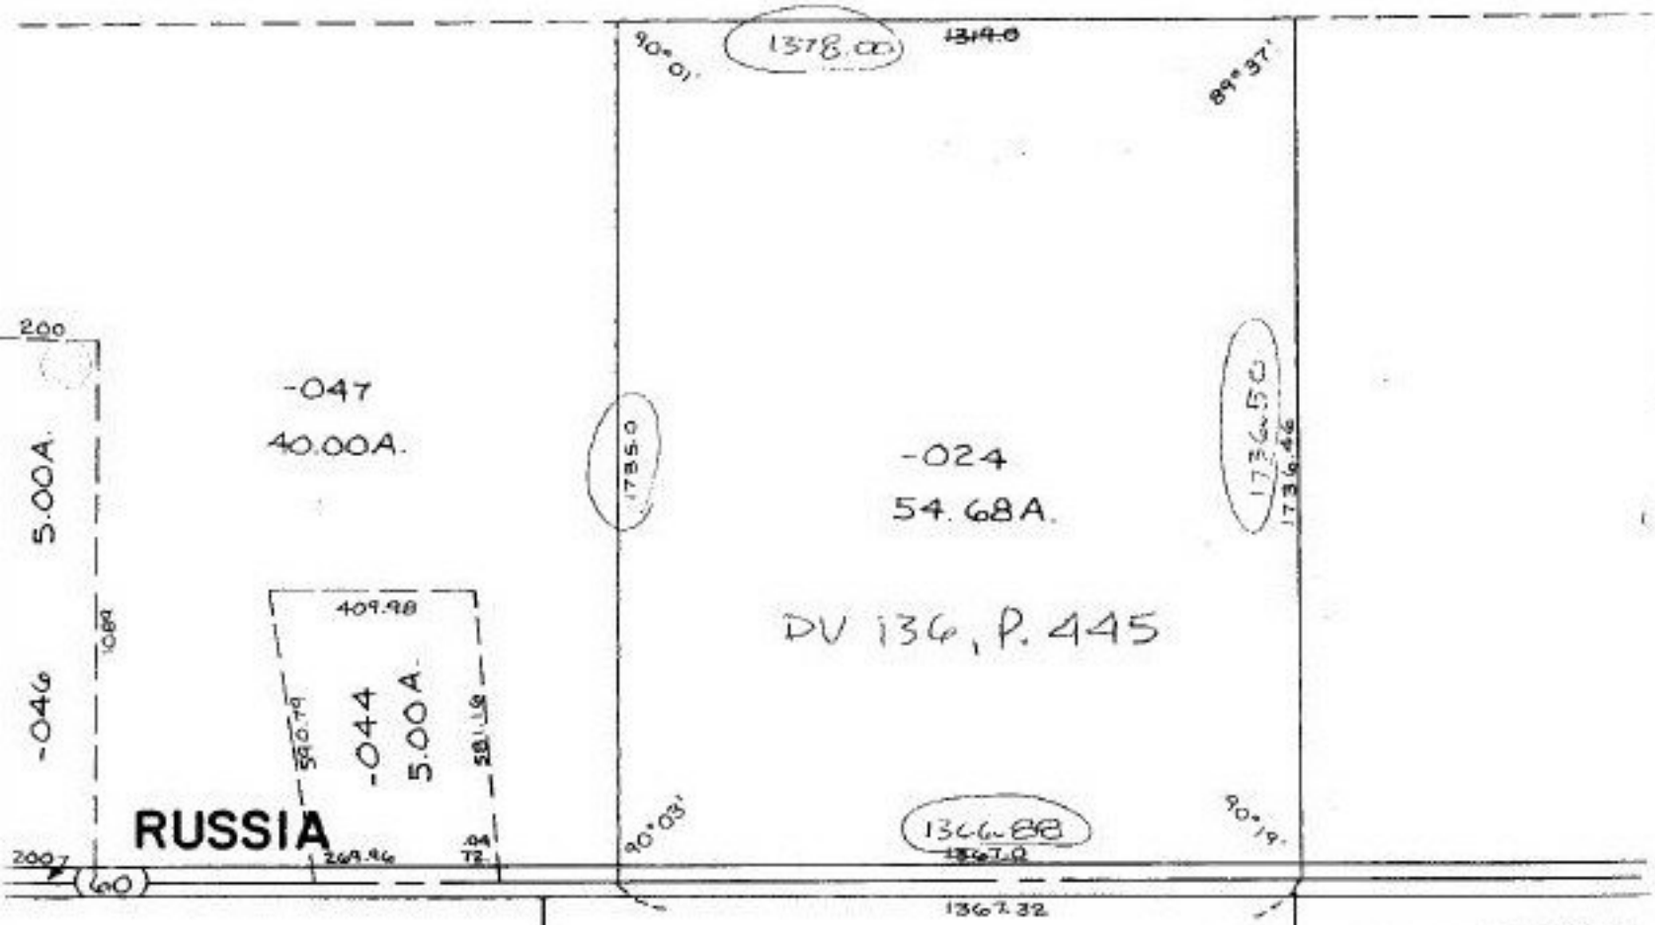

#21763-D

APPROVED
LORAIN CO.
MAP DEPT.
DATE 6-28-96
10-B
C.E. FRANCIS
21763-D

MAP CORRECTION

009-A

009-B