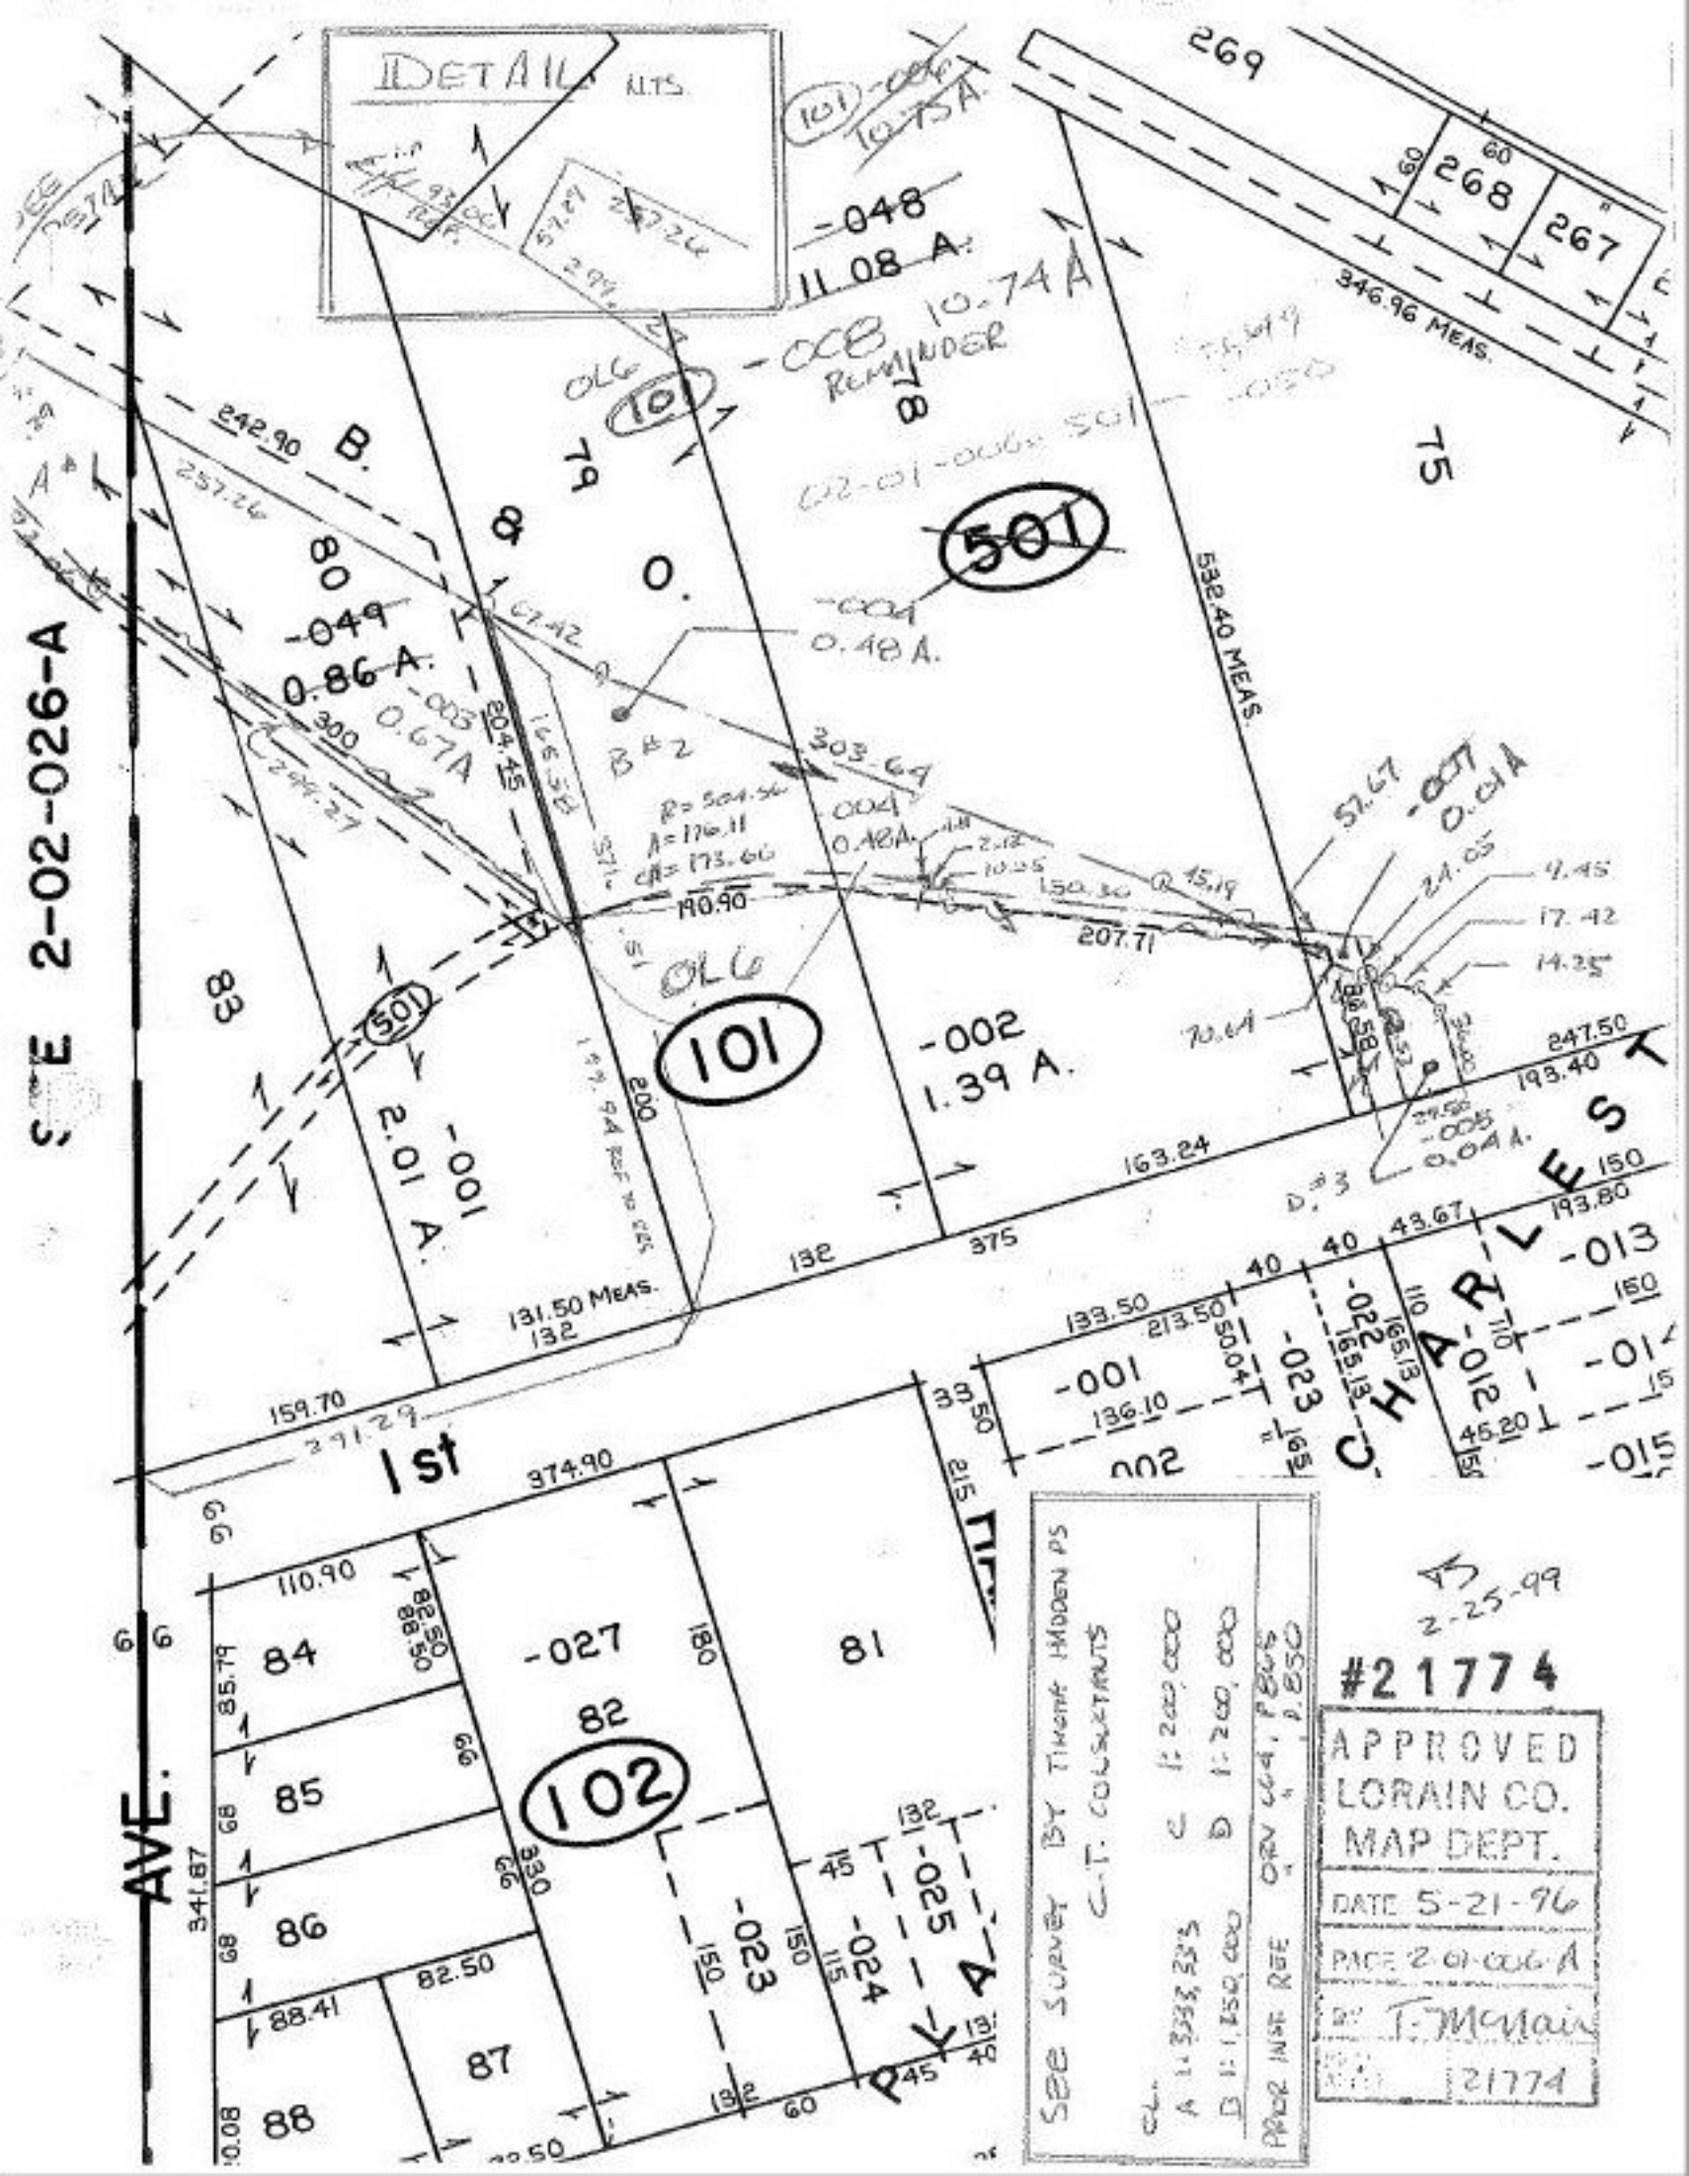

DETAIL N.T.S.
101 -006 10.75 A.
-048 11.08 A.
-008 10.74 A REMAINDER
OL6
101
501
269
268
267
346.96 MEAS.
532.40 MEAS.
242.90
257.26
B. & O.
80
79
78
75
-049 0.86 A.
-003 0.67 A
-004 0.48 A.
B #2
303.64
R=504.56
A=176.11
CH=173.66
190.90
207.71
OL6
101
-002 1.39 A.
-001 2.01 A.
83
-007 0.01 A
24.05
9.45
17.42
14.25
70.64
247.50
193.40
-005 0.04 A.
D #3
163.24
131.50 MEAS.
132
375
159.70
291.29
1st
CHARLEST
-013
-012
-015
-001
-023
-022
133.50
213.50
136.10
374.90
110.90
84
85
86
87
88
-027
82
81
102
-023
-024
-025
AVE.
341.87
SEE SURVEY BY TIMOTHY HADDEN PS
C.T. CONSULTANTS
CL.
A 1:3333,333
B 1:1,250,000
C 1:200,000
D 1:200,000
PRIOR INST. REF. ORV 664, P.865
2-25-99
#21774
APPROVED
LORAIN CO.
MAP DEPT.
DATE 5-21-96
PAGE 2-01-006-A
BY T. McNair
21774