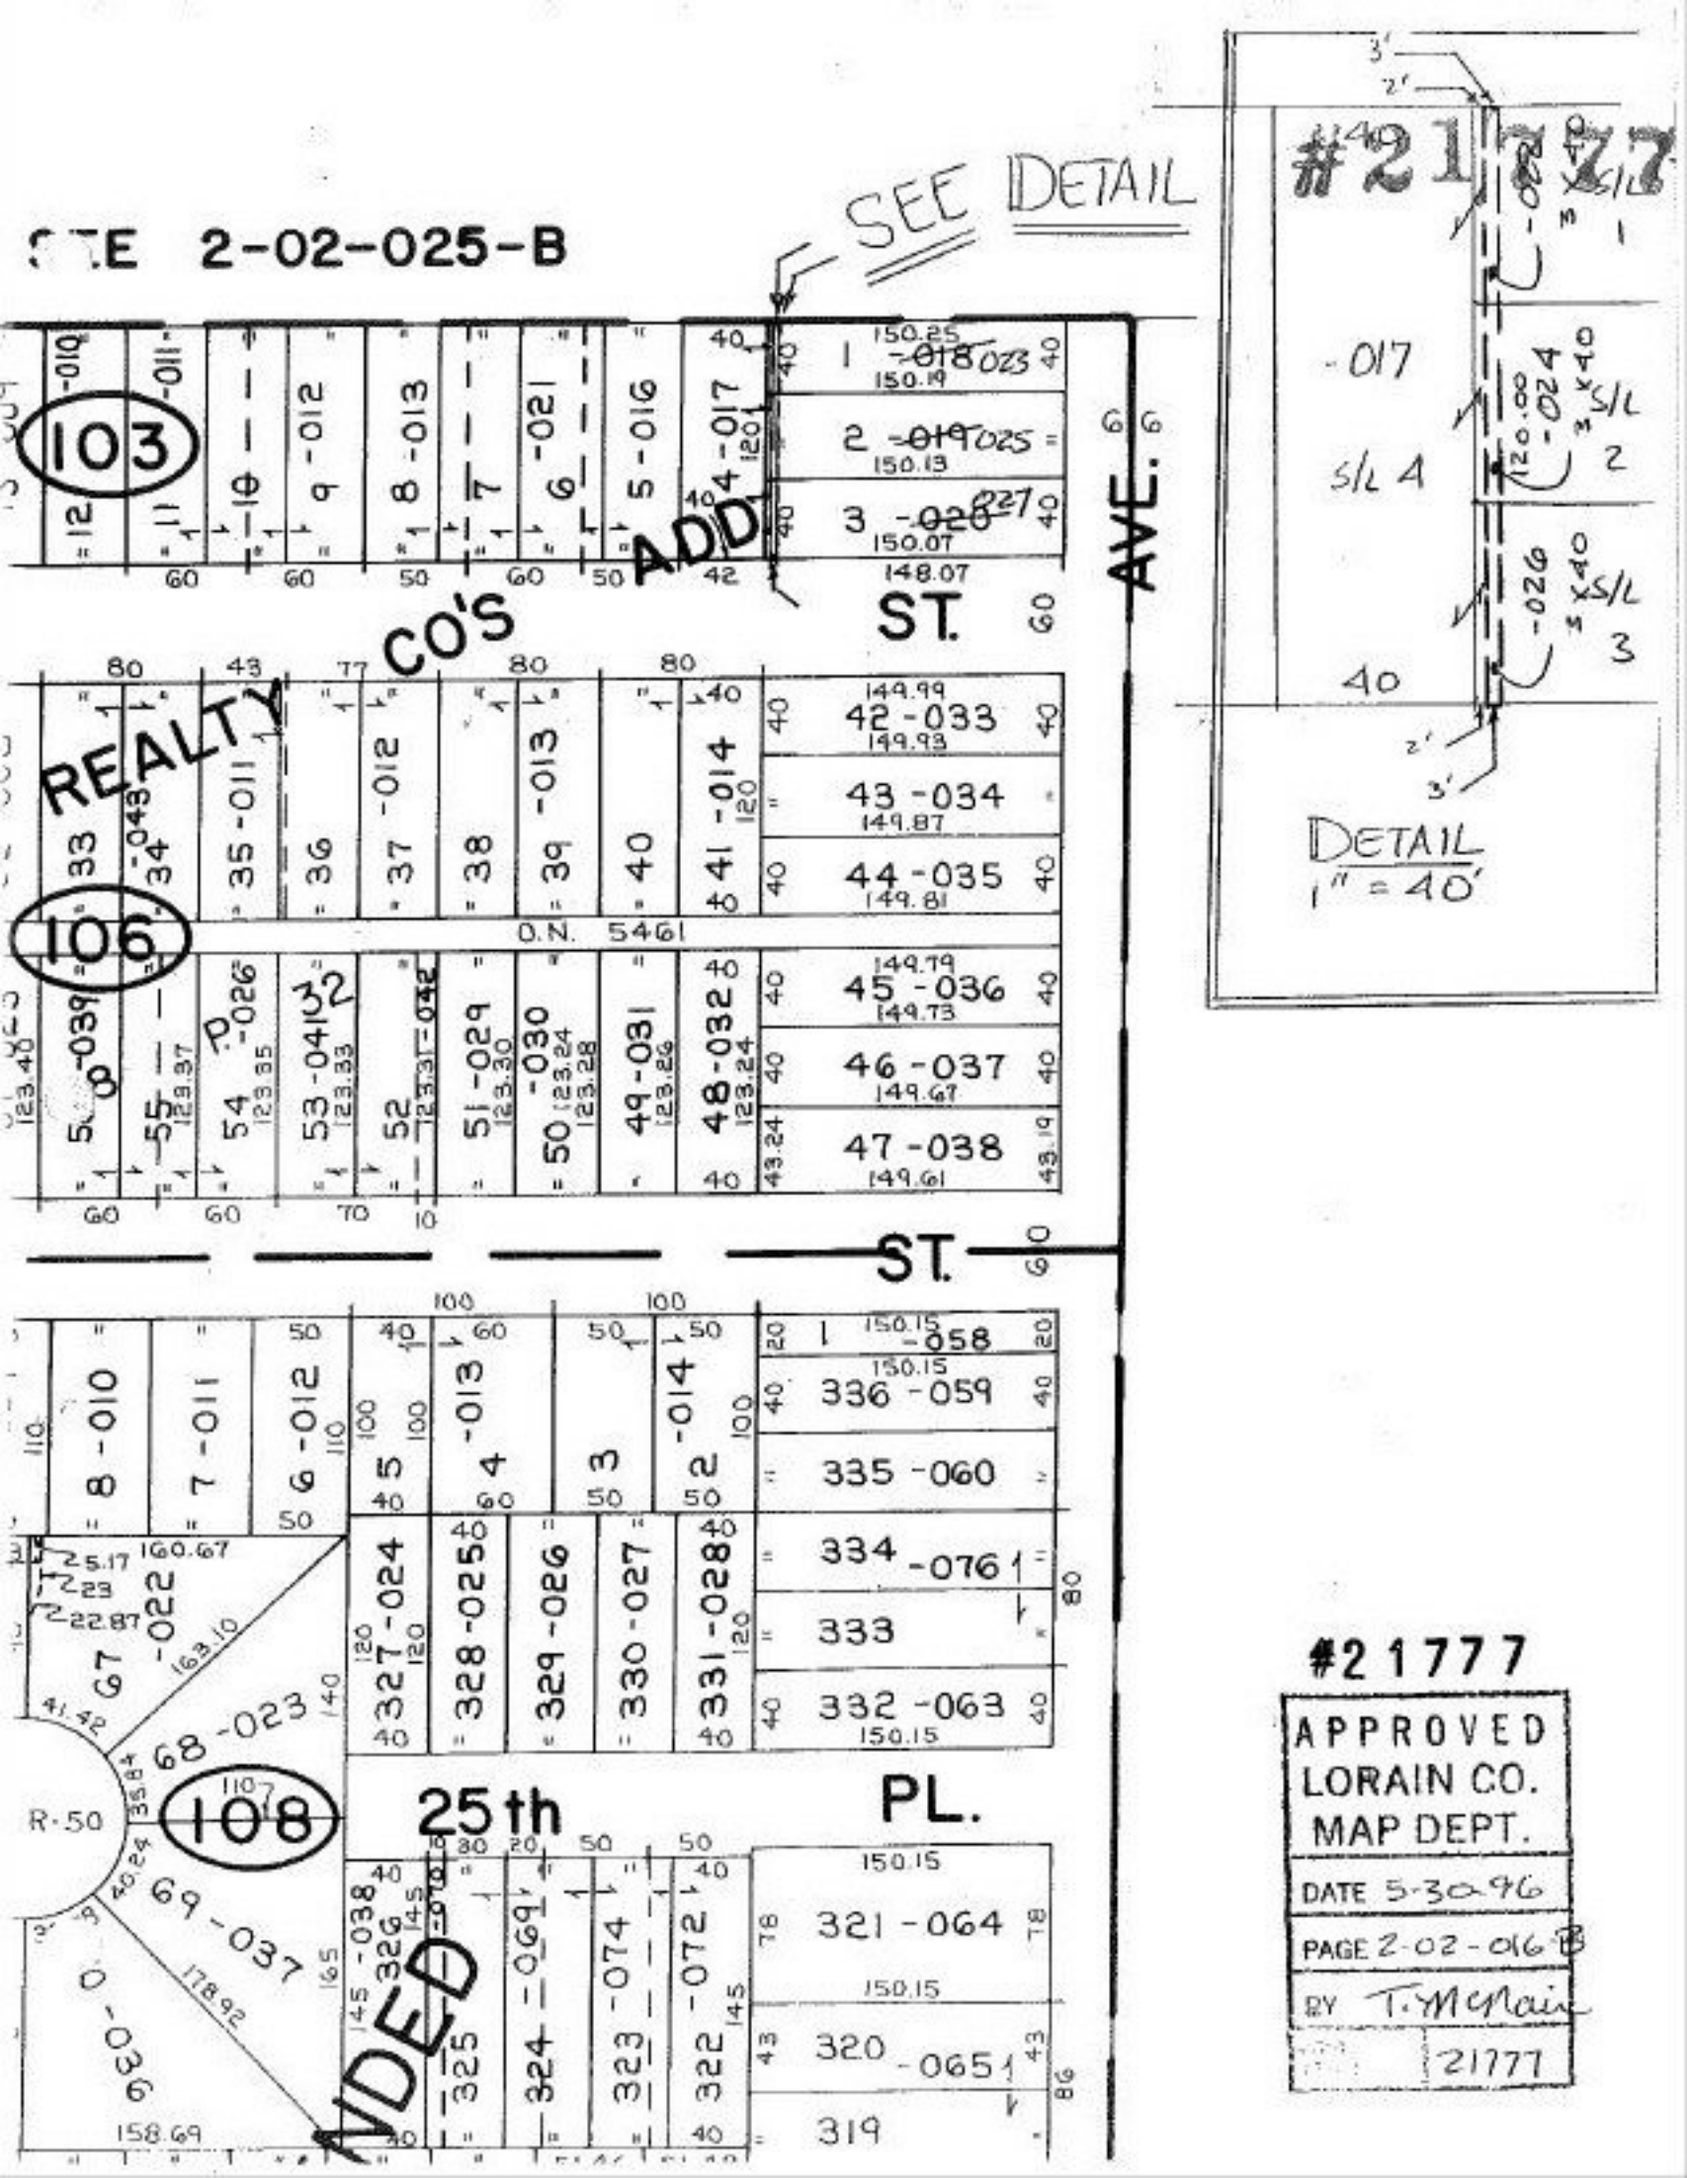

SEE DETAIL
#21777
DETAIL
1" = 40'
103
106
108
REALTY CO'S ADD
ST.
AVE.
ST.
25th PL.
O.N. 5461
R-50
#21777
APPROVED
LORAIN CO.
MAP DEPT.
DATE 5-30-96
PAGE 2-02-016-B
BY T. McNair
21777