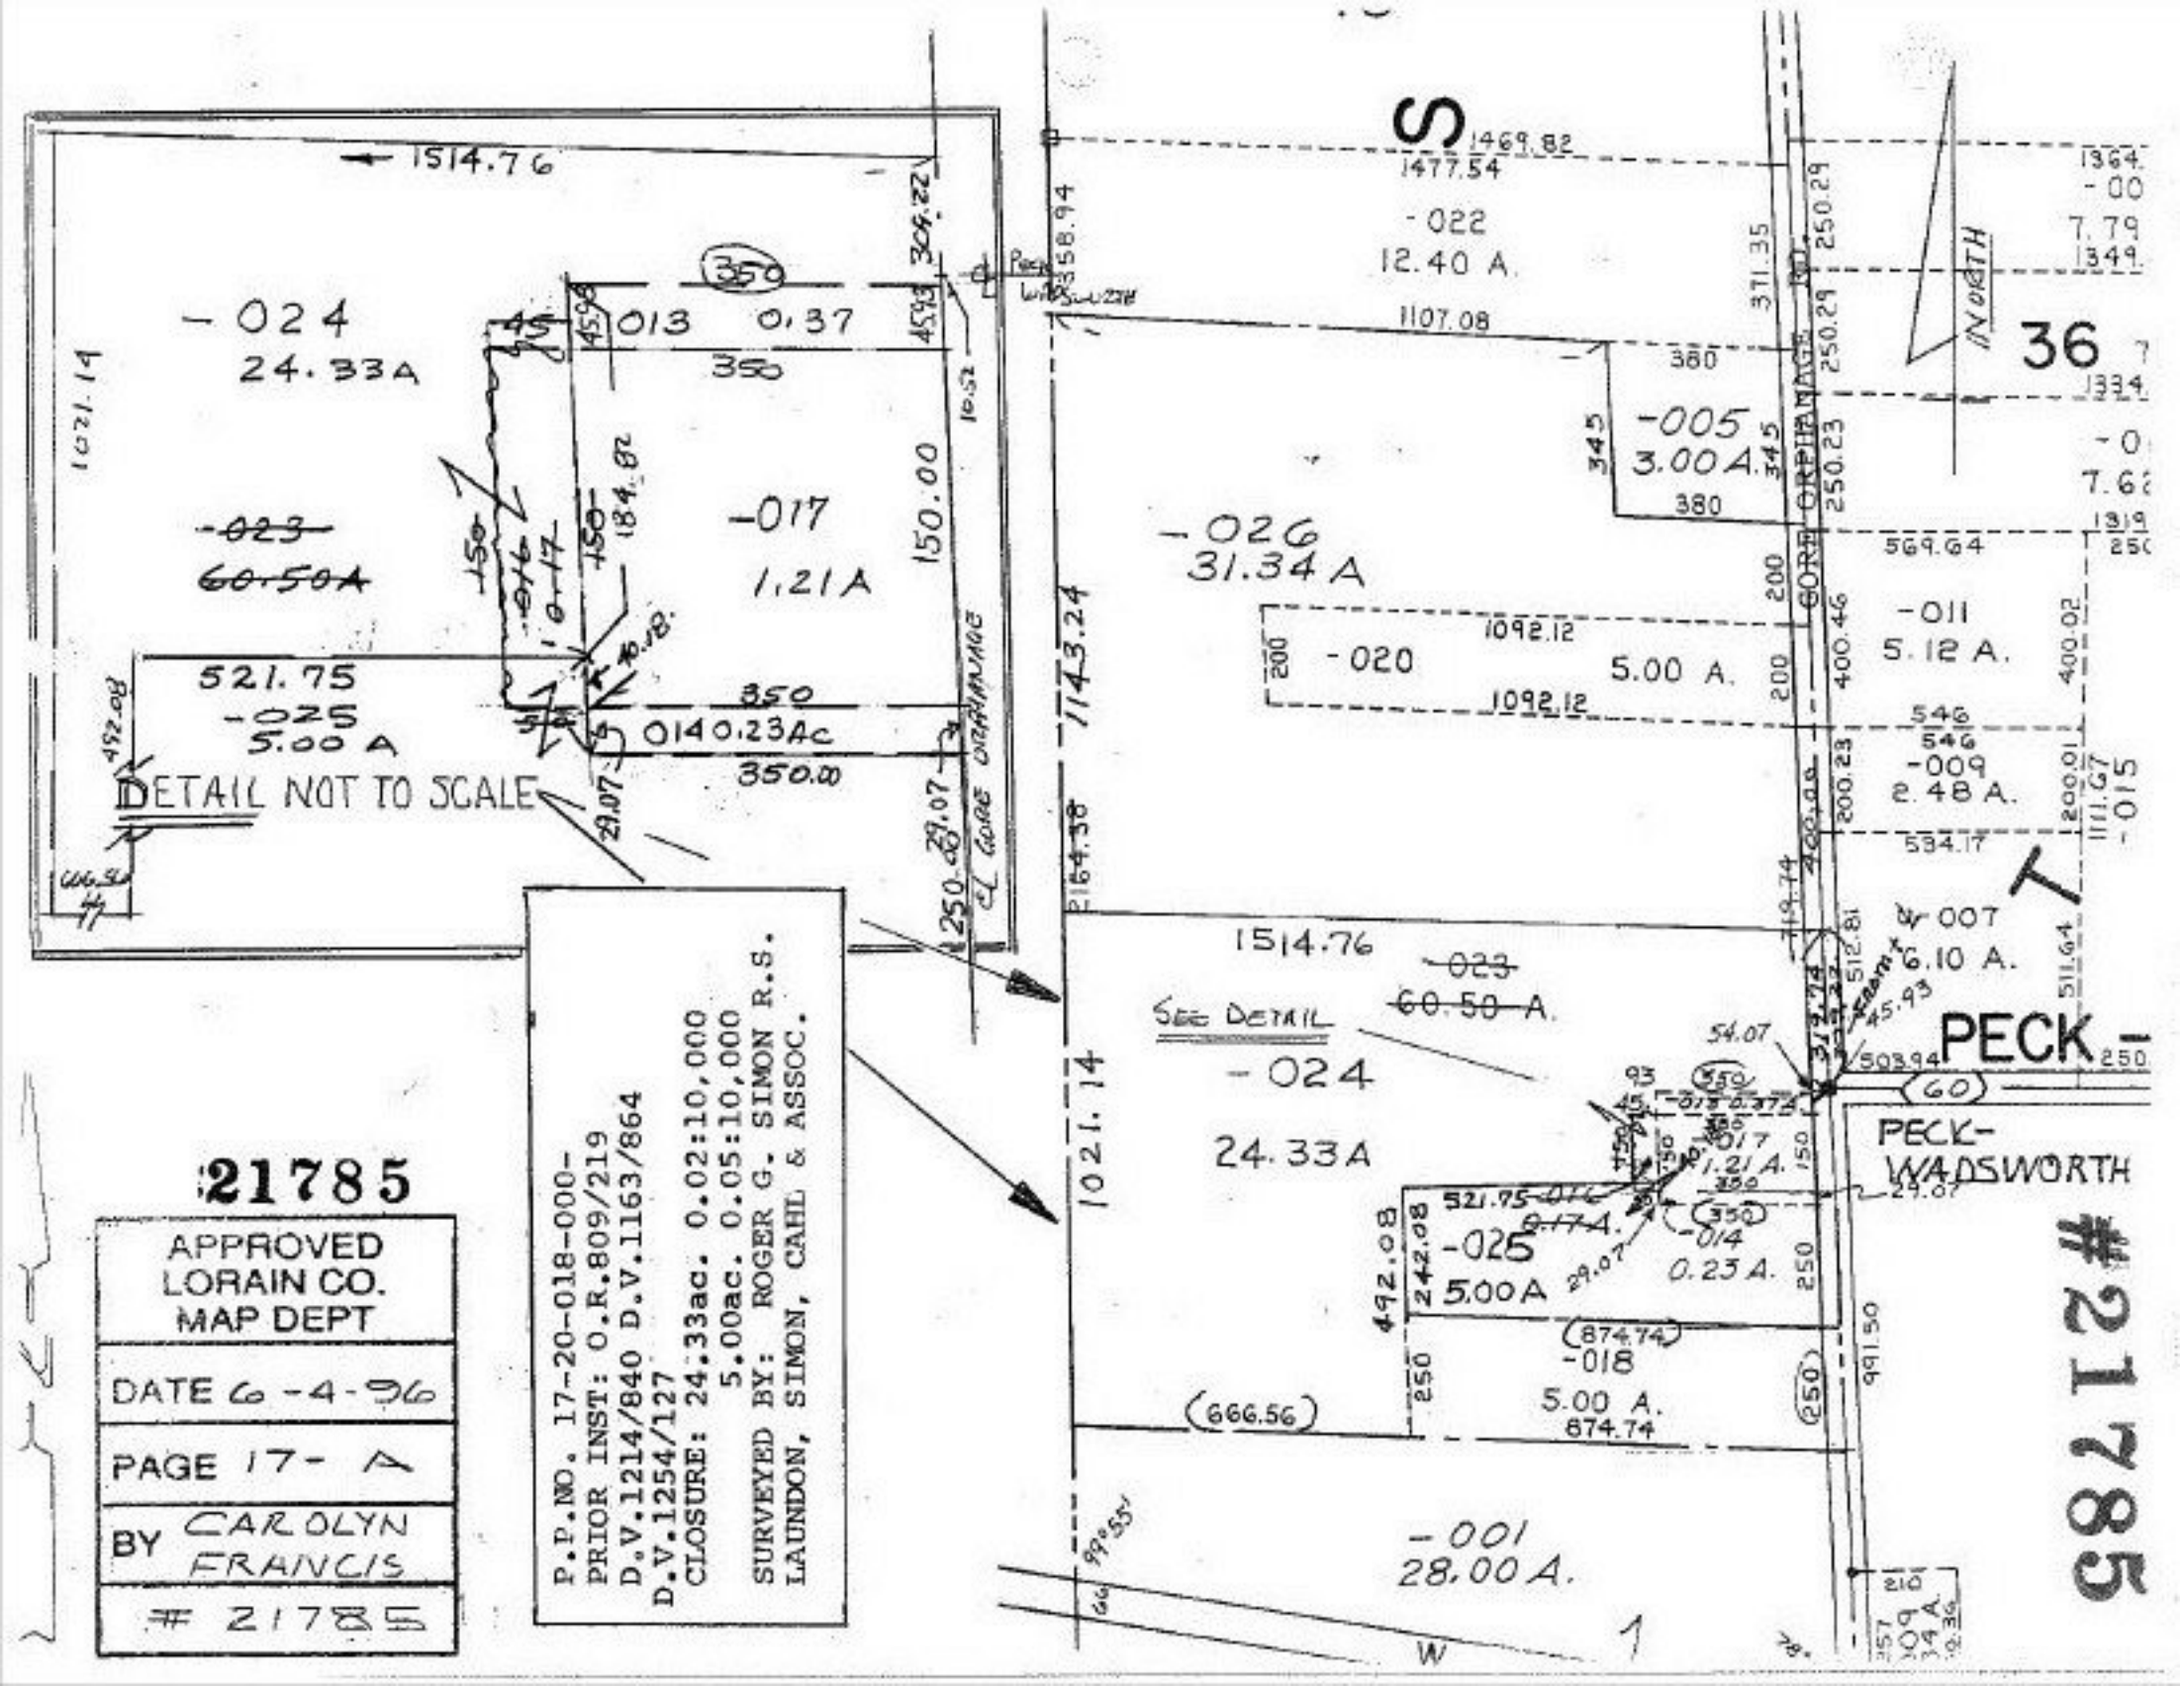
1514.76
-024
24.33A
1021.14
-023
60.50A
-025
5.00 A
521.75
492.08
DETAIL NOT TO SCALE
013 0.37
014 0.23Ac
-017
1.21A
150.00
184.82
350.00
306.22
1469.82
1477.54
-022
12.40 A.
1107.08
1358.94
1143.24
-026
31.34 A
-020
5.00 A.
1092.12
-005
3.00A.
380
345
371.35
250.29
250.23
NORTH
36
569.64
-011
5.12 A.
400.46
400.02
546
-009
2.48 A.
200.23
200.01
534.17
007
6.10 A.
512.81
511.64
PECK
60
PECK-WADSWORTH
1514.76
-023
60.50 A.
See Detail
-024
24.33A
1021.14
-017
1.21 A.
-025
5.00A
242.08
-014
0.23 A.
-018
5.00 A.
874.74
666.56
-001
28.00 A.
991.50
S 99°55' W
P.P.NO. 17-20-018-000-
PRIOR INST: O.R.809/219
D.V.1214/840 D.V.1163/864
D.V.1254/127
CLOSURE: 24.33ac. 0.02:10,000
5.00ac. 0.05:10,000
SURVEYED BY: ROGER G. SIMON R.S.
LAUNDON, SIMON, CAHL & ASSOC.
21785
APPROVED
LORAIN CO.
MAP DEPT
DATE 6-4-96
PAGE 17-A
BY CAROLYN FRANCIS
21785
21785 #