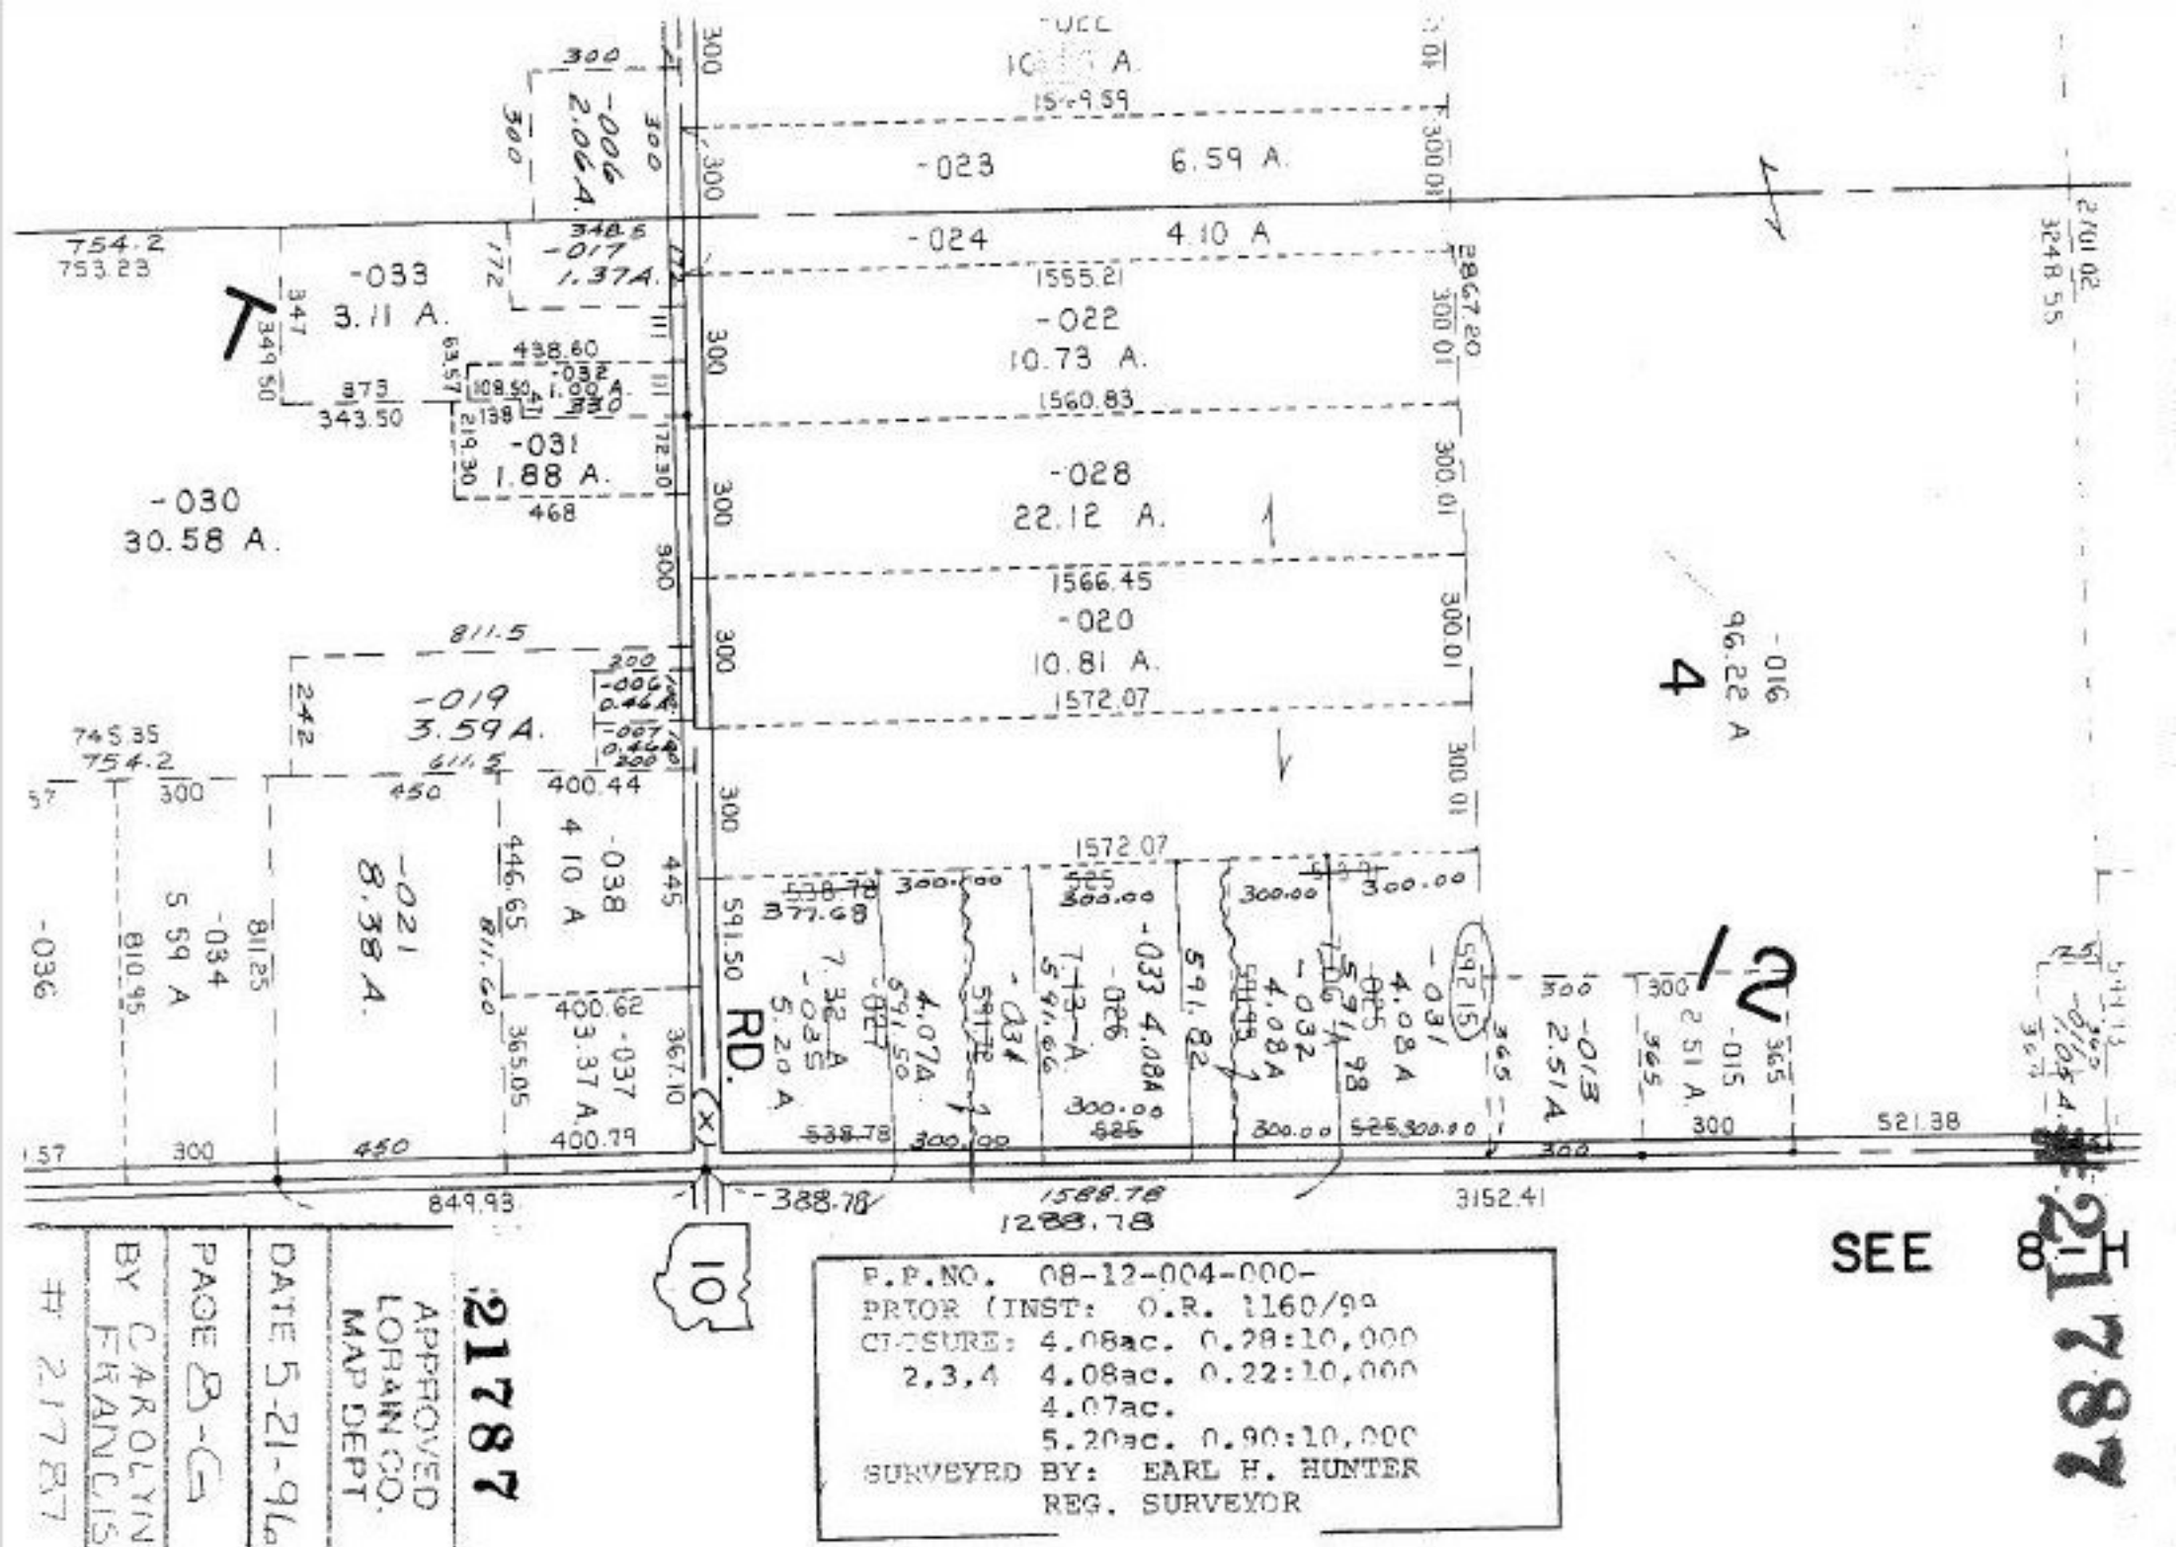

P.P.NO.	08-12-004-000-
PRIOR INST:	O.R. 1160/99
CLOSURE:	4.08ac. 0.28:10,000
2,3,4	4.08ac. 0.22:10,000
	4.07ac.
	5.20ac. 0.90:10,000
SURVEYED BY:	EARL H. HUNTER
	REG. SURVEYOR

APPROVED
LORAIN CO.
MAP DEPT

DATE 5-21-96


BY CAROLYN FRANCIS

21787

21787