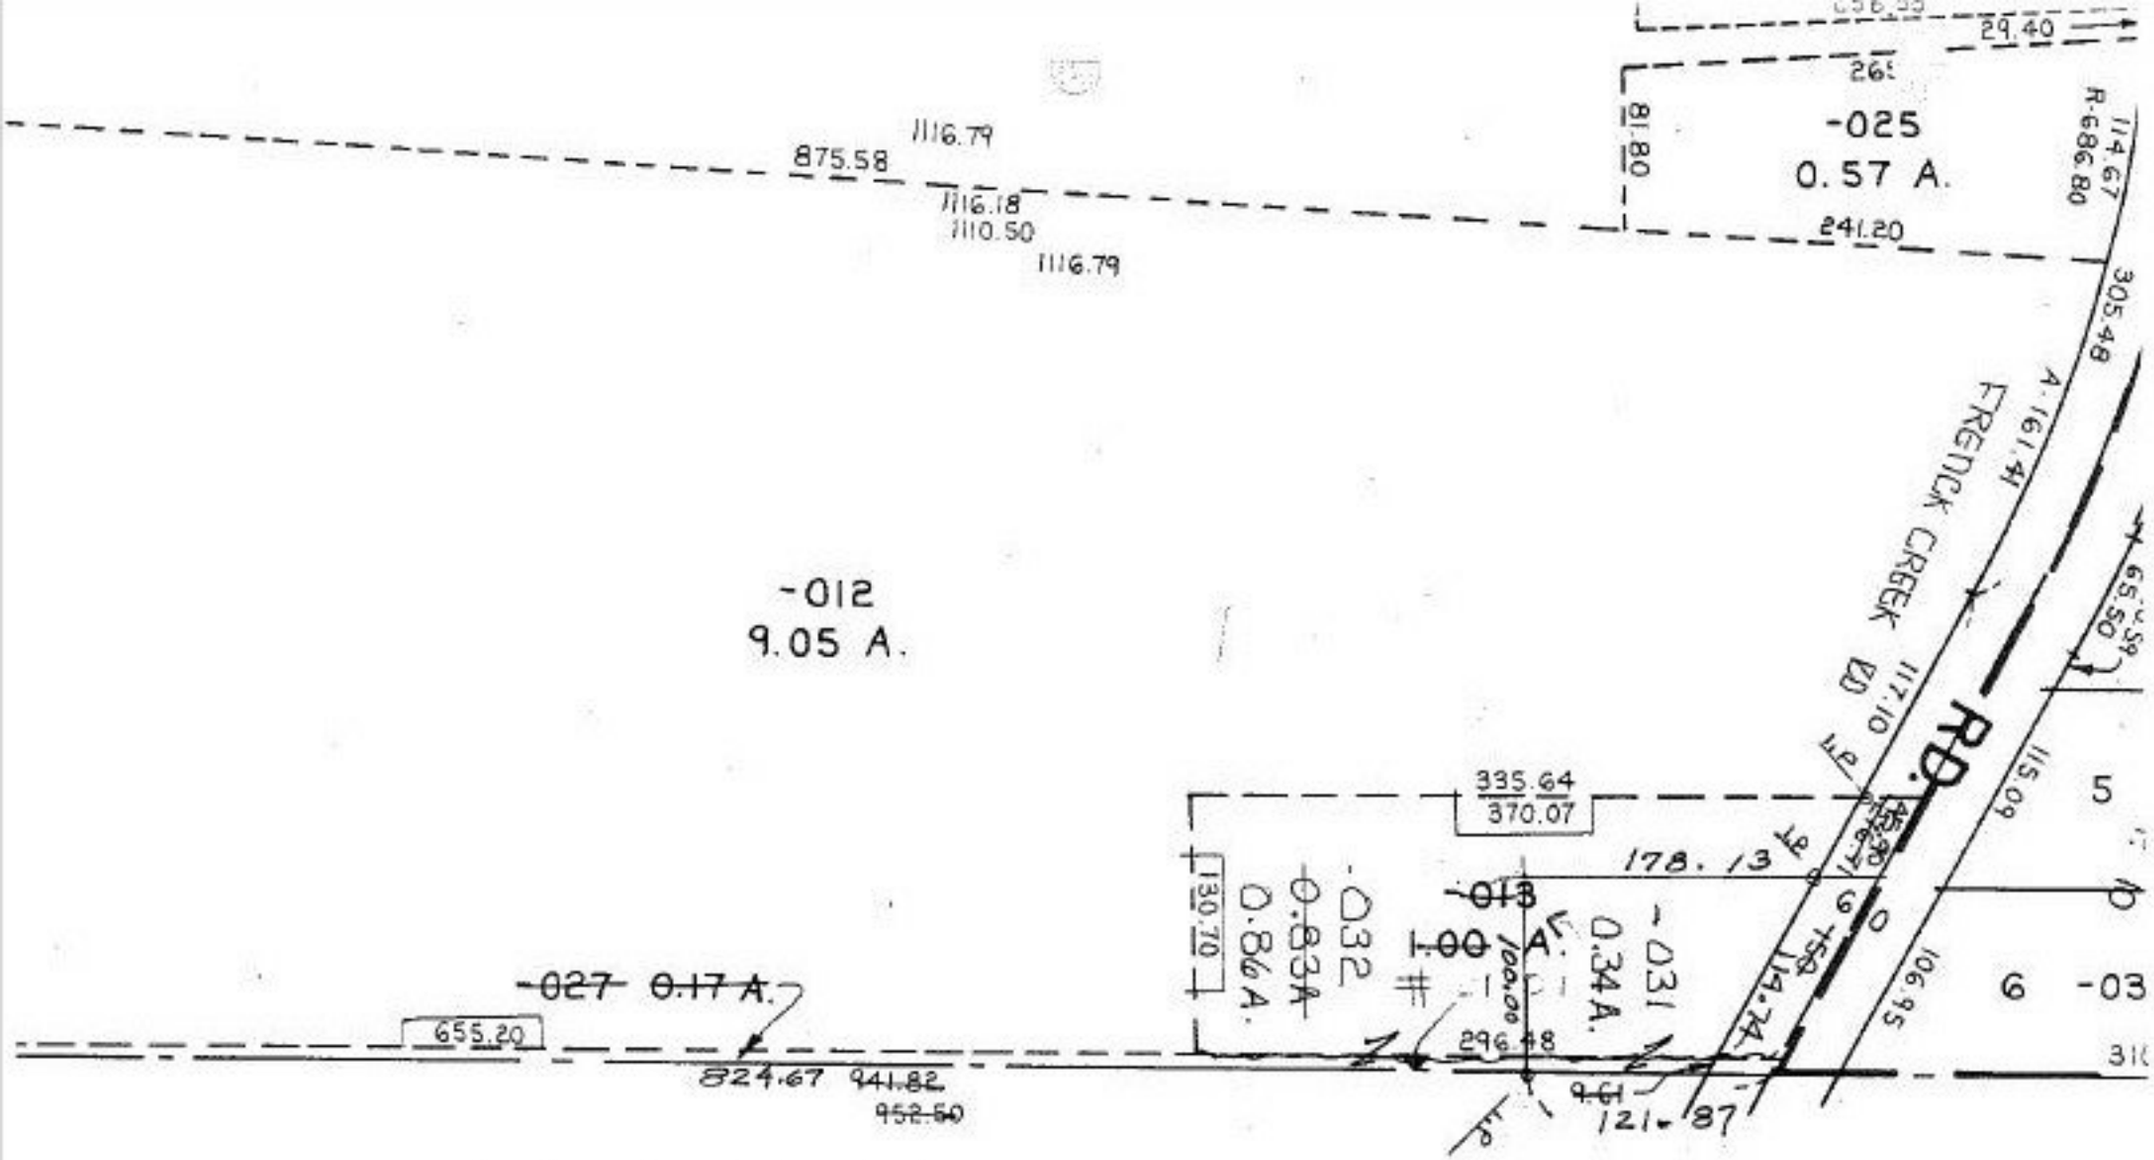

APPROVED LORAIN CO. MAP DEPT	DATE 6-5-96	PAGE 4-00-003 H	BY CAROLYN FRANCIS	# 21789

21789

P.P.NO. 04-00-003-103-
PRIOR INST: O.R. 1117/547
O.R. 1271/260
CLOSURE: 0.34ac. 0.04:10,000
0.86ac. 0.03:10,000
SURVEYED BY: RALPH W.
REG. SURVEYOR GROMLEY

#21789