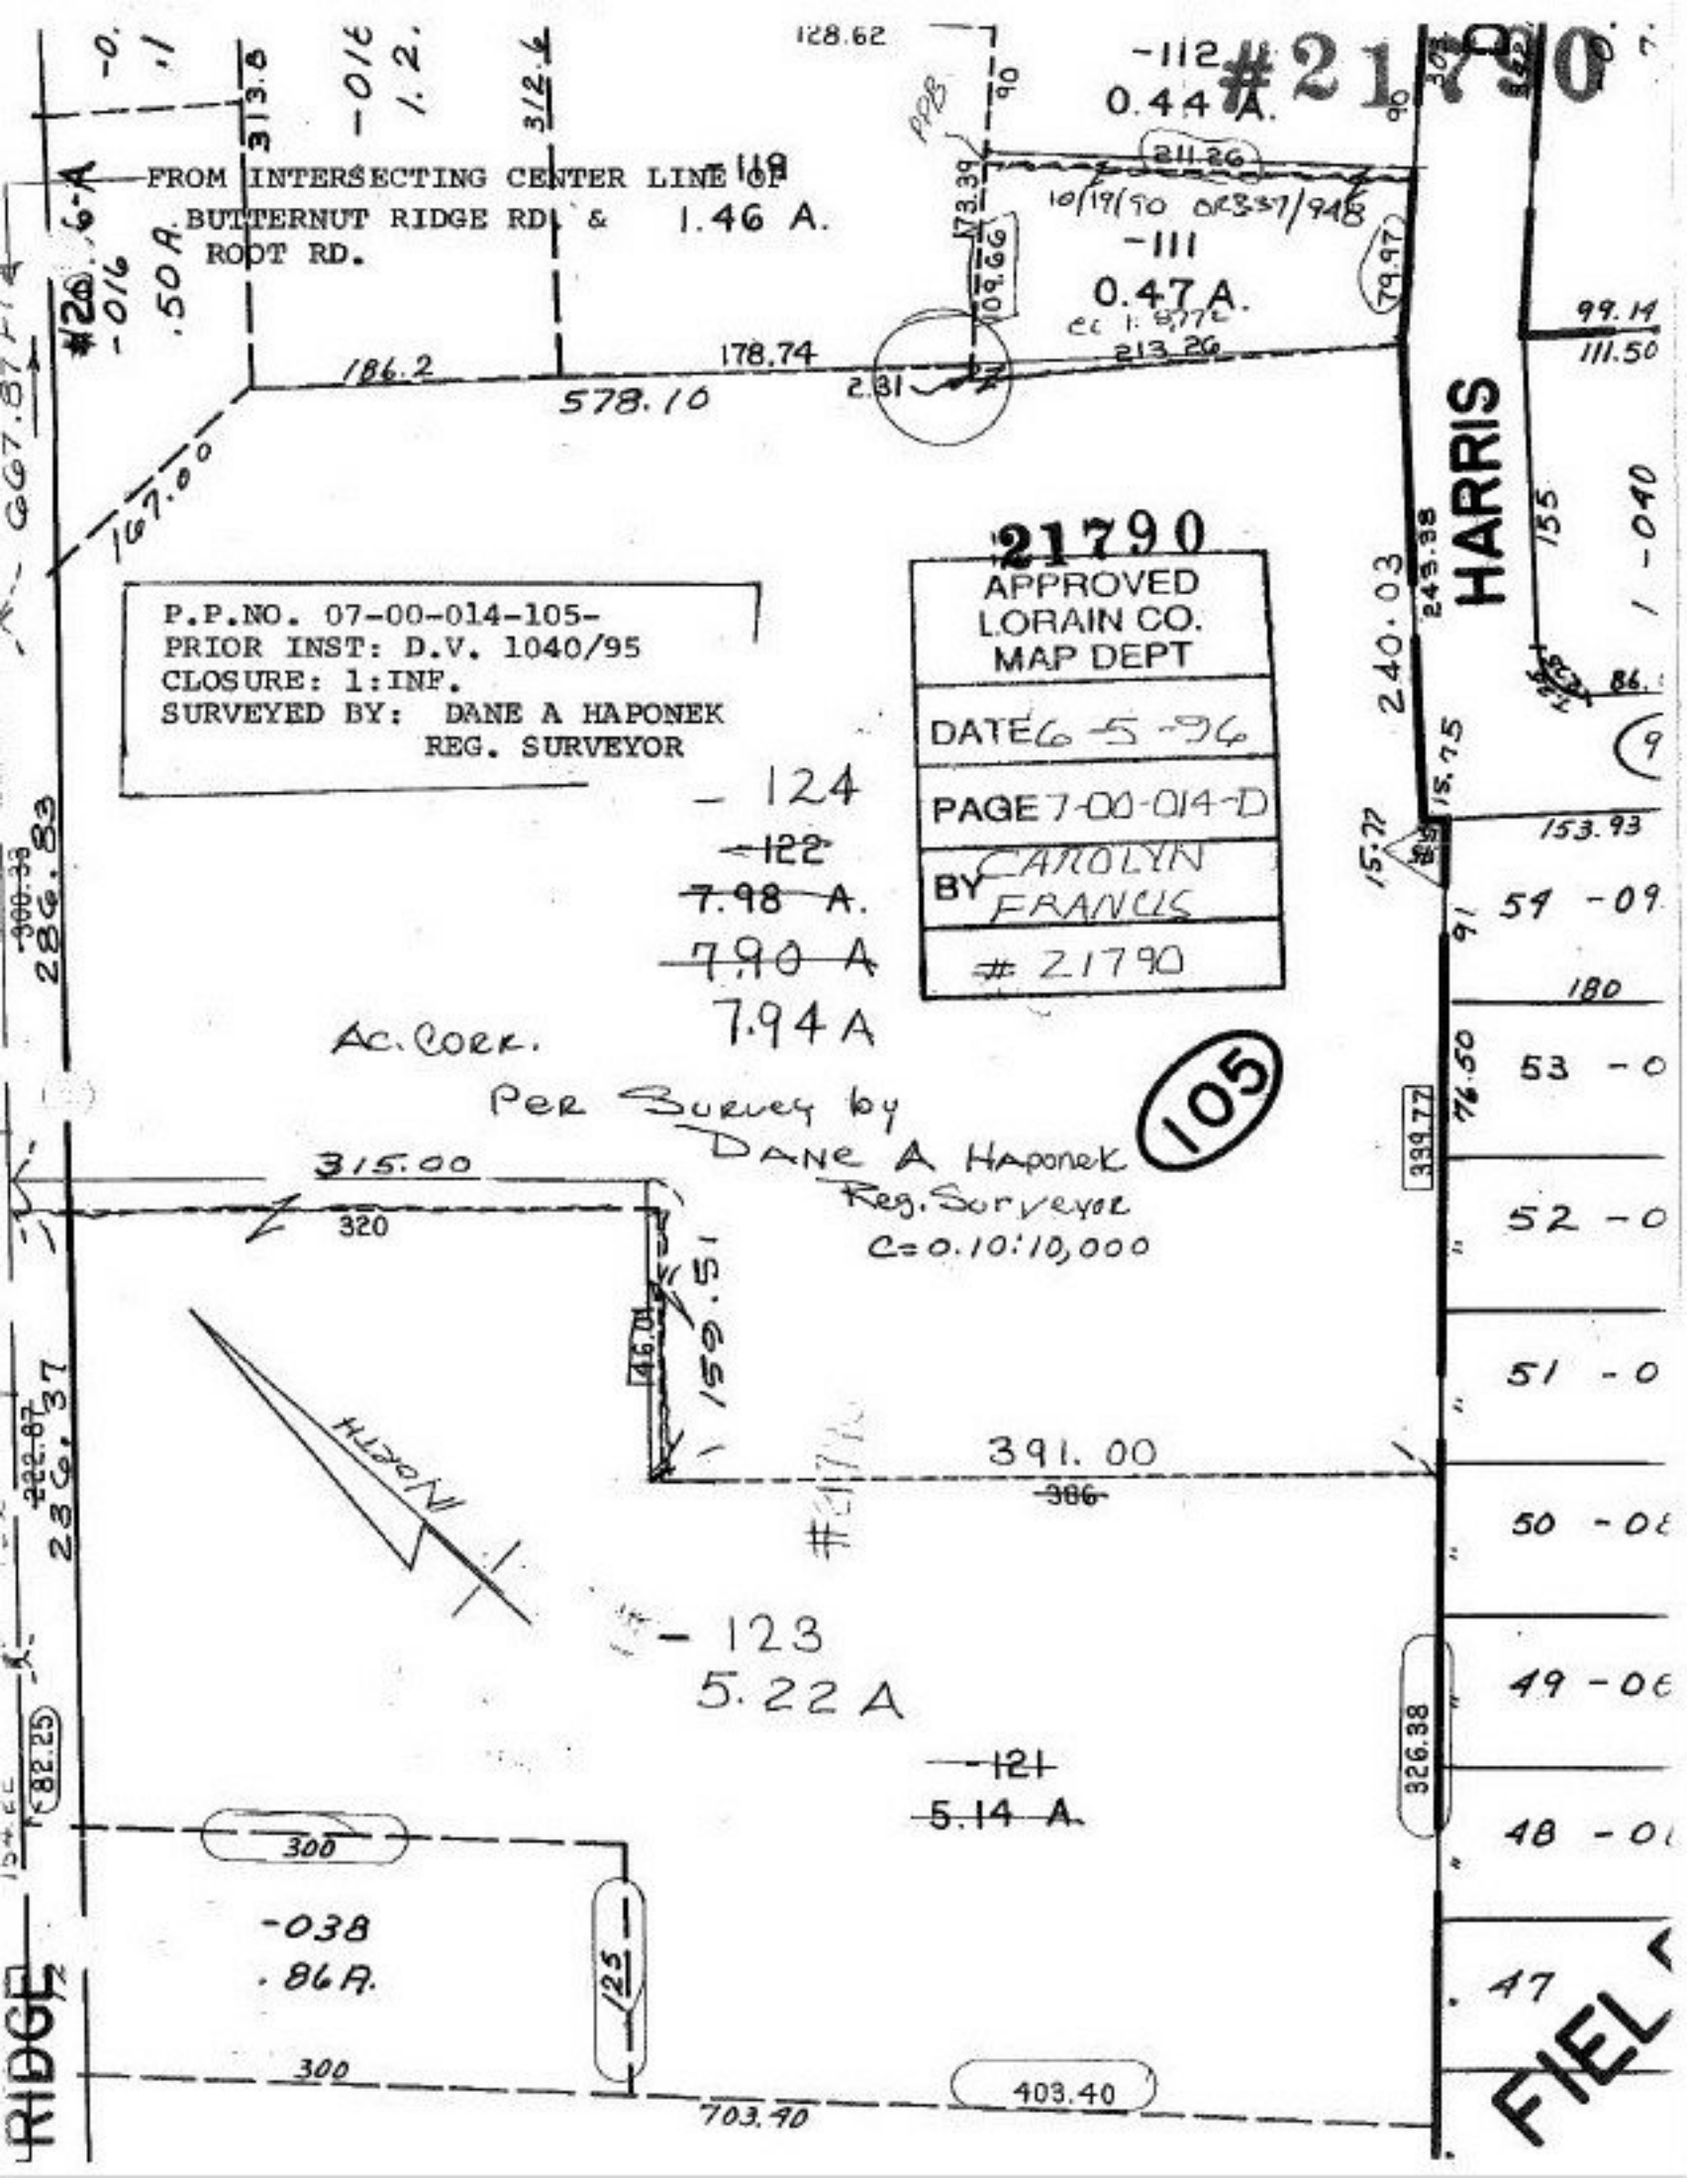
#21790
FROM INTERSECTING CENTER LINE OF BUTTERNUT RIDGE RD. & ROOT RD.
1.46 A.
-112
0.44 A.
-111
0.47 A.
10/19/90 OR357/948
-016
.50 A.
#20
-016
1.2.
313.6
312.6
128.62
211.26
173.39
109.66
79.97
99.14
111.50
186.2
178.74
213.26
578.10
2.31
167.00
607.87
240.03
243.38
HARRIS
155
1-040
P.P.NO. 07-00-014-105-
PRIOR INST: D.V. 1040/95
CLOSURE: 1:INF.
SURVEYED BY: DANE A HAPONEK
REG. SURVEYOR
21790
APPROVED
LORAIN CO.
MAP DEPT
DATE 6-5-96
PAGE 7-00-014-D
BY CAROLYN FRANCIS
21790
-124
-122
7.98 A.
7.90 A
7.94 A
AC. CORR.
Per Survey by
DANE A Haponek
Reg. Surveyor
C=0.10:10,000
105
315.00
320
150.51
45.01
391.00
386
NORTH
-123
5.22 A
-121
5.14 A.
300.36
286.83
22.87
236.37
82.25
300
-038
.86 A.
125
300
703.40
403.40
326.38
339.77
76.50
153.93
15.75
15.77
180
91
53 -0
52 -0
51 -0
50 -0
49 -0
48 -0
47
RIDGE
FIEL