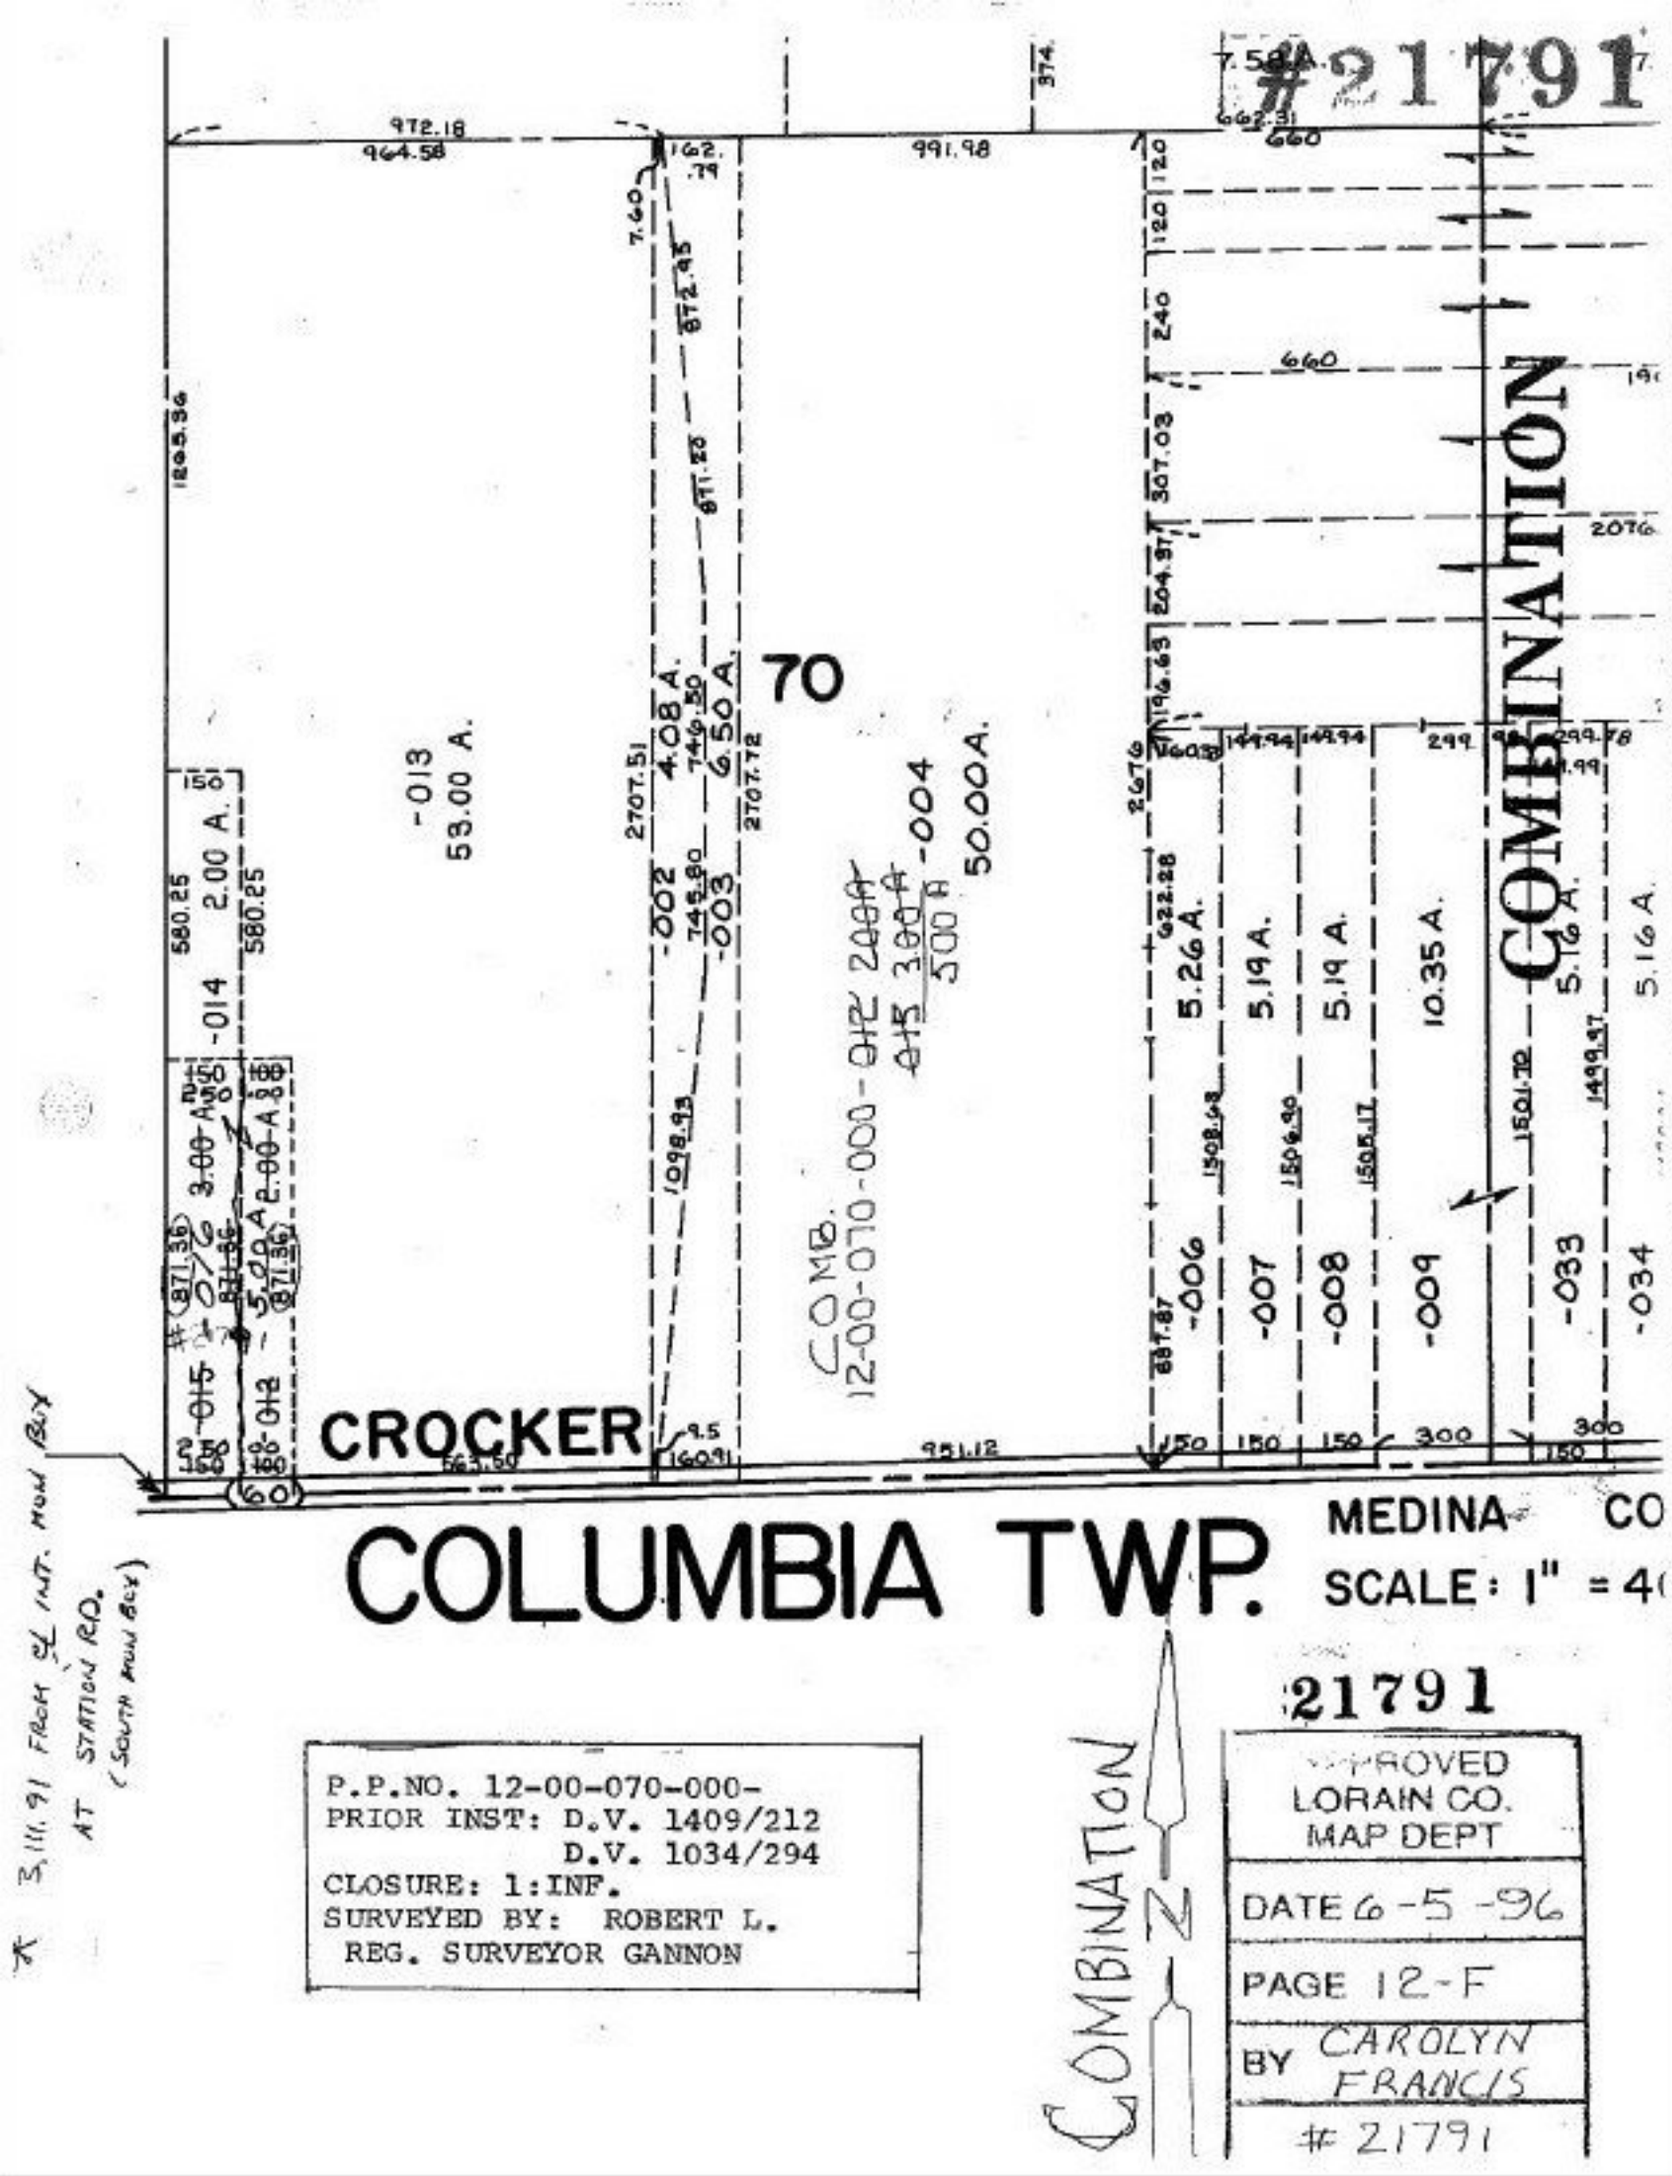

3.111.91 FROM ℄ INT. MOM RD.
AT STATION RD.
(SOUTH MOM RD.)

P.P.NO. 12-00-070-000-
PRIOR INST: D.V. 1409/212
D.V. 1034/294
CLOSURE: 1:INF.
SURVEYED BY: ROBERT L.
REG. SURVEYOR GANNON

21791

APPROVED
LORAIN CO.
MAP DEPT

DATE 6-5-96

PAGE 12-F

BY CAROLYN FRANCIS

#21791