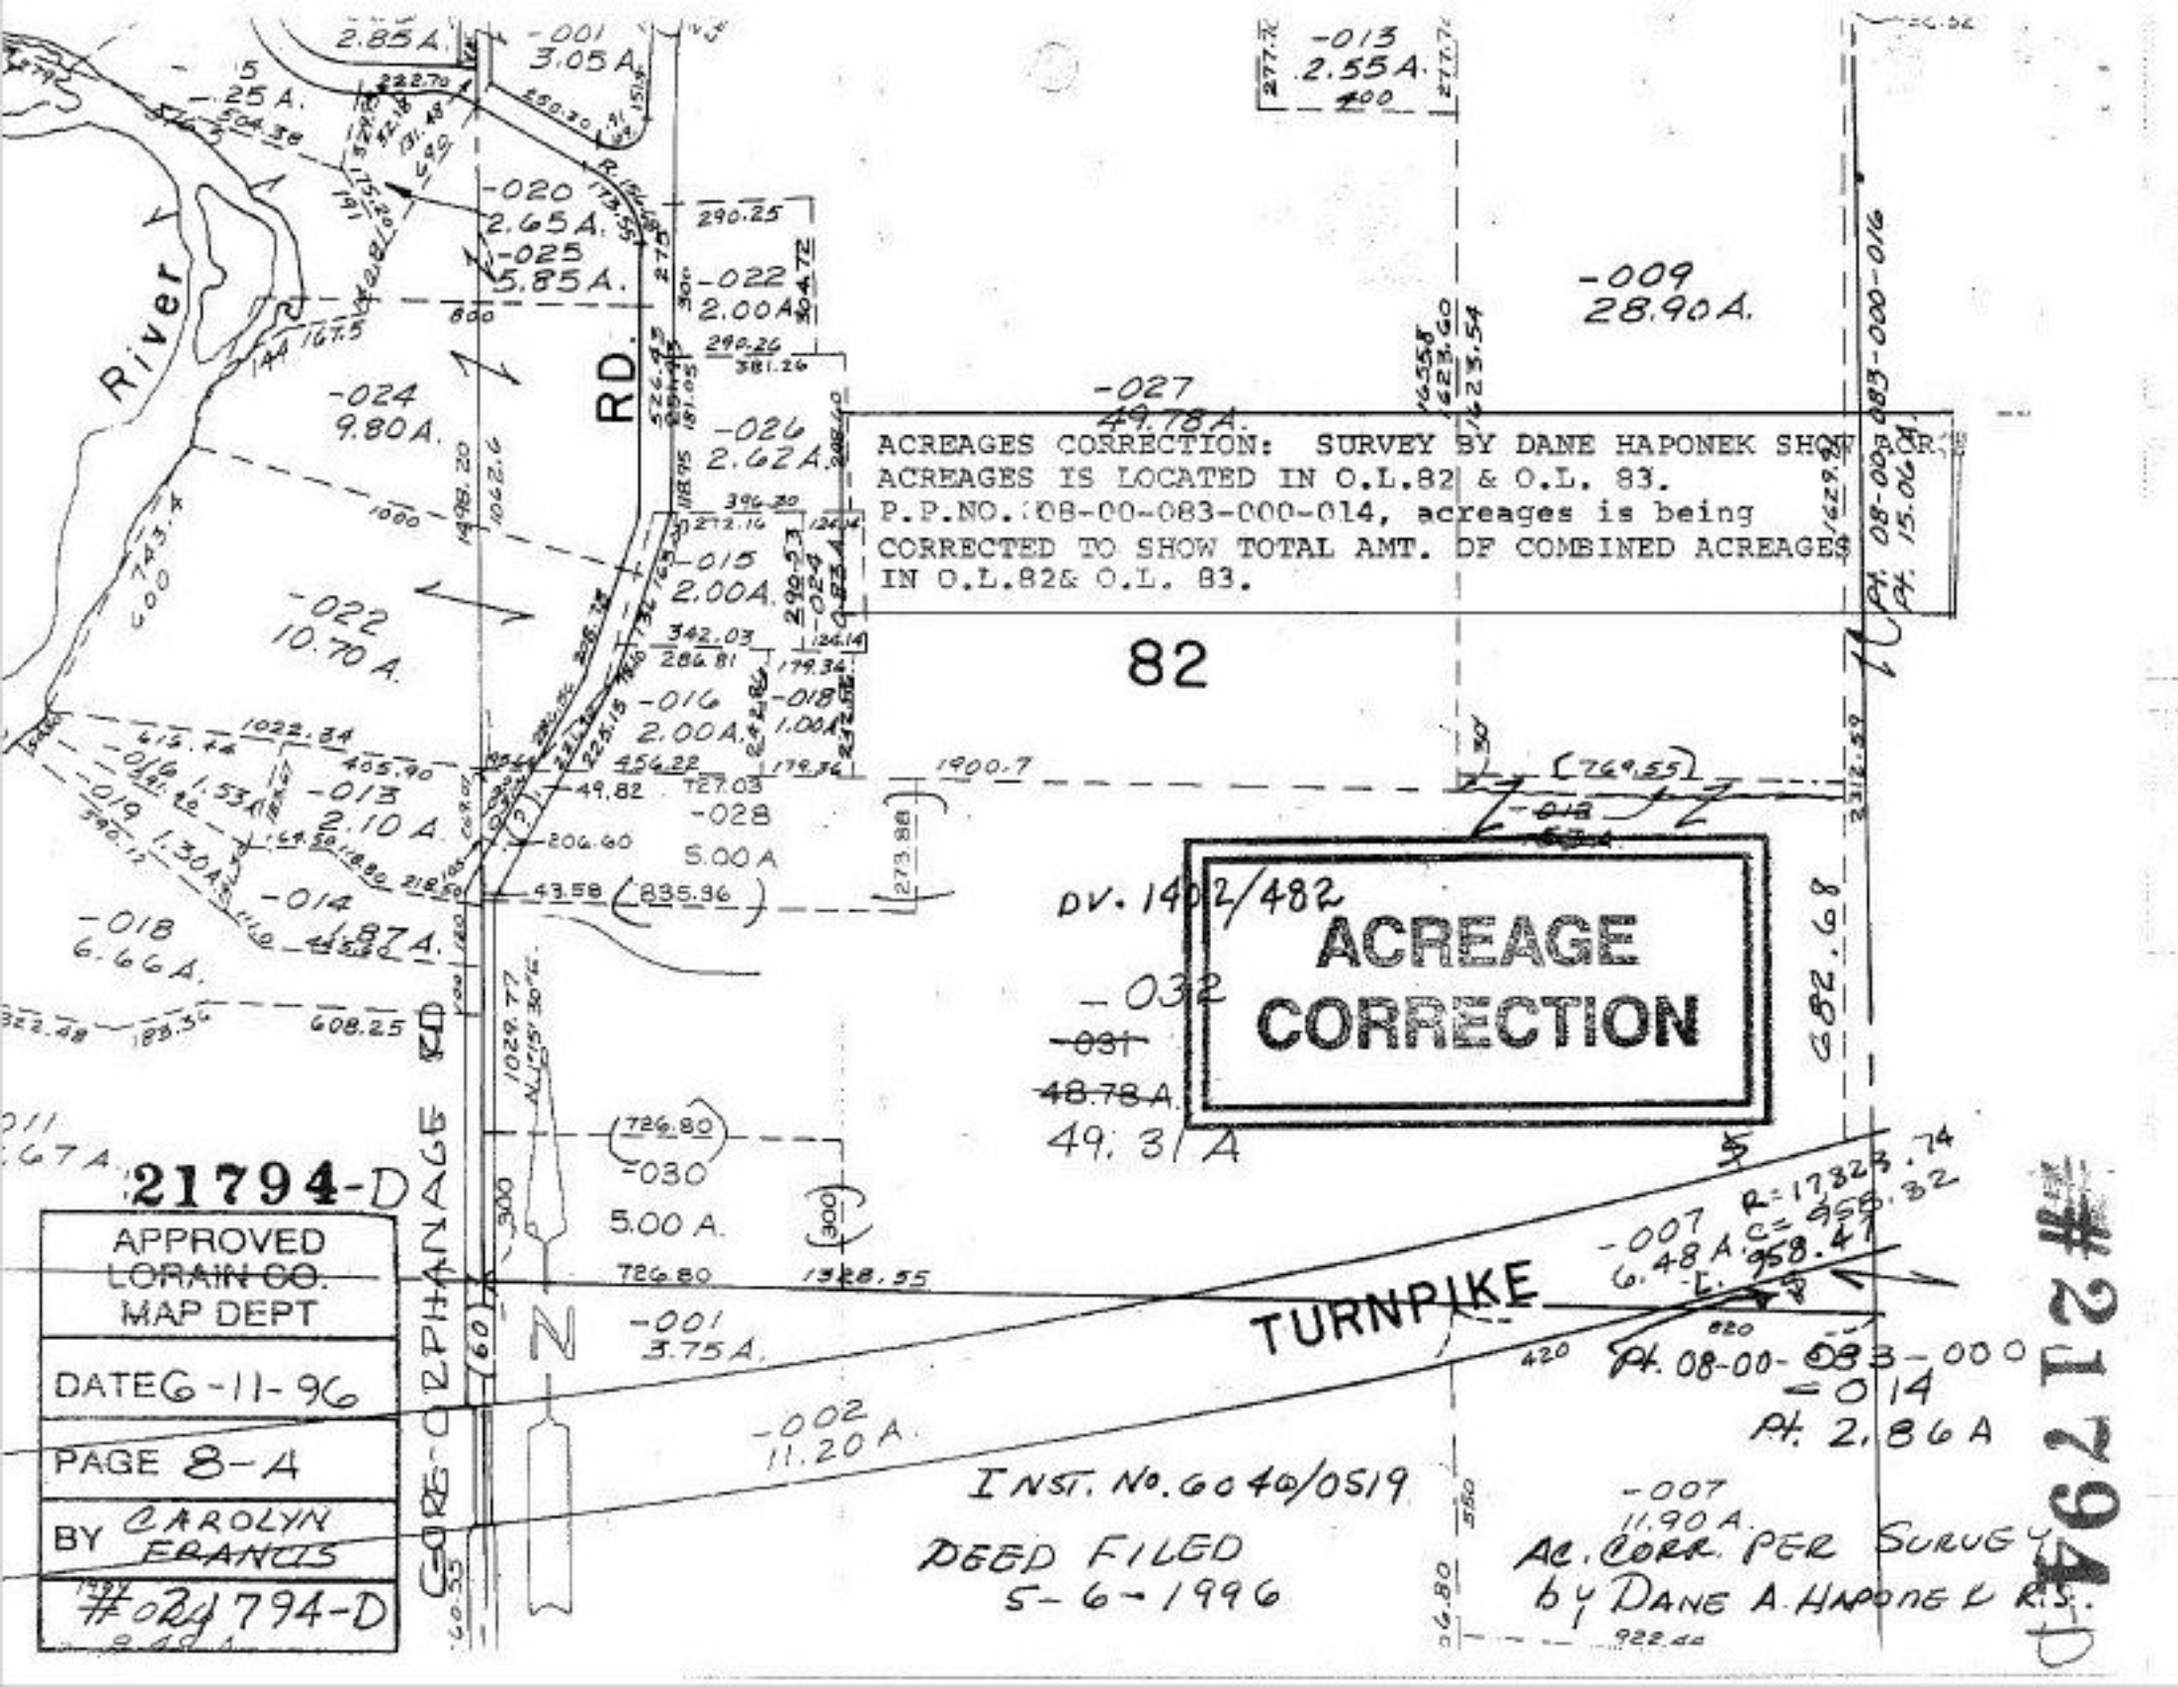
River
RD.
82
ACREAGES CORRECTION: SURVEY BY DANE HAPONEK SHOW CR ACREAGES IS LOCATED IN O.L.82 & O.L. 83. P.P.NO. 08-00-083-000-014, acreages is being CORRECTED TO SHOW TOTAL AMT. OF COMBINED ACREAGES IN O.L.82& O.L. 83.
ACREAGE CORRECTION
DV. 1402/482
-032
-031
48.78A.
49.31A
-027
49.78A.
-009
28.90A.
-022
10.70A.
-024
9.80A.
-025
5.85A.
-020
2.65A.
-001
3.05A.
2.85A.
-022
2.00A
-026
2.62A.
-015
2.00A.
-016
2.00A.
-018
1.00A.
-013
2.10A.
-014
4.87A.
-018
6.66A.
-028
5.00A
-030
5.00A.
-001
3.75A.
-002
11.20A.
-007
6.48A.
-007
11.90A.
Pt. 08-00-083-000-016
Pt. 15.06A.
Pt. 08-00-083-000-014
Pt. 2.86A
GORE-ORPHANAGE RD
TURNPIKE
INST. NO. 6040/0519
DEED FILED 5-6-1996
AC. CORR. PER SURVEY by DANE A. HAPONEK R.S.
21794-D
APPROVED LORAIN CO. MAP DEPT
DATE 6-11-96
PAGE 8-A
BY CAROLYN FRANCIS
#021794-D
21794-D