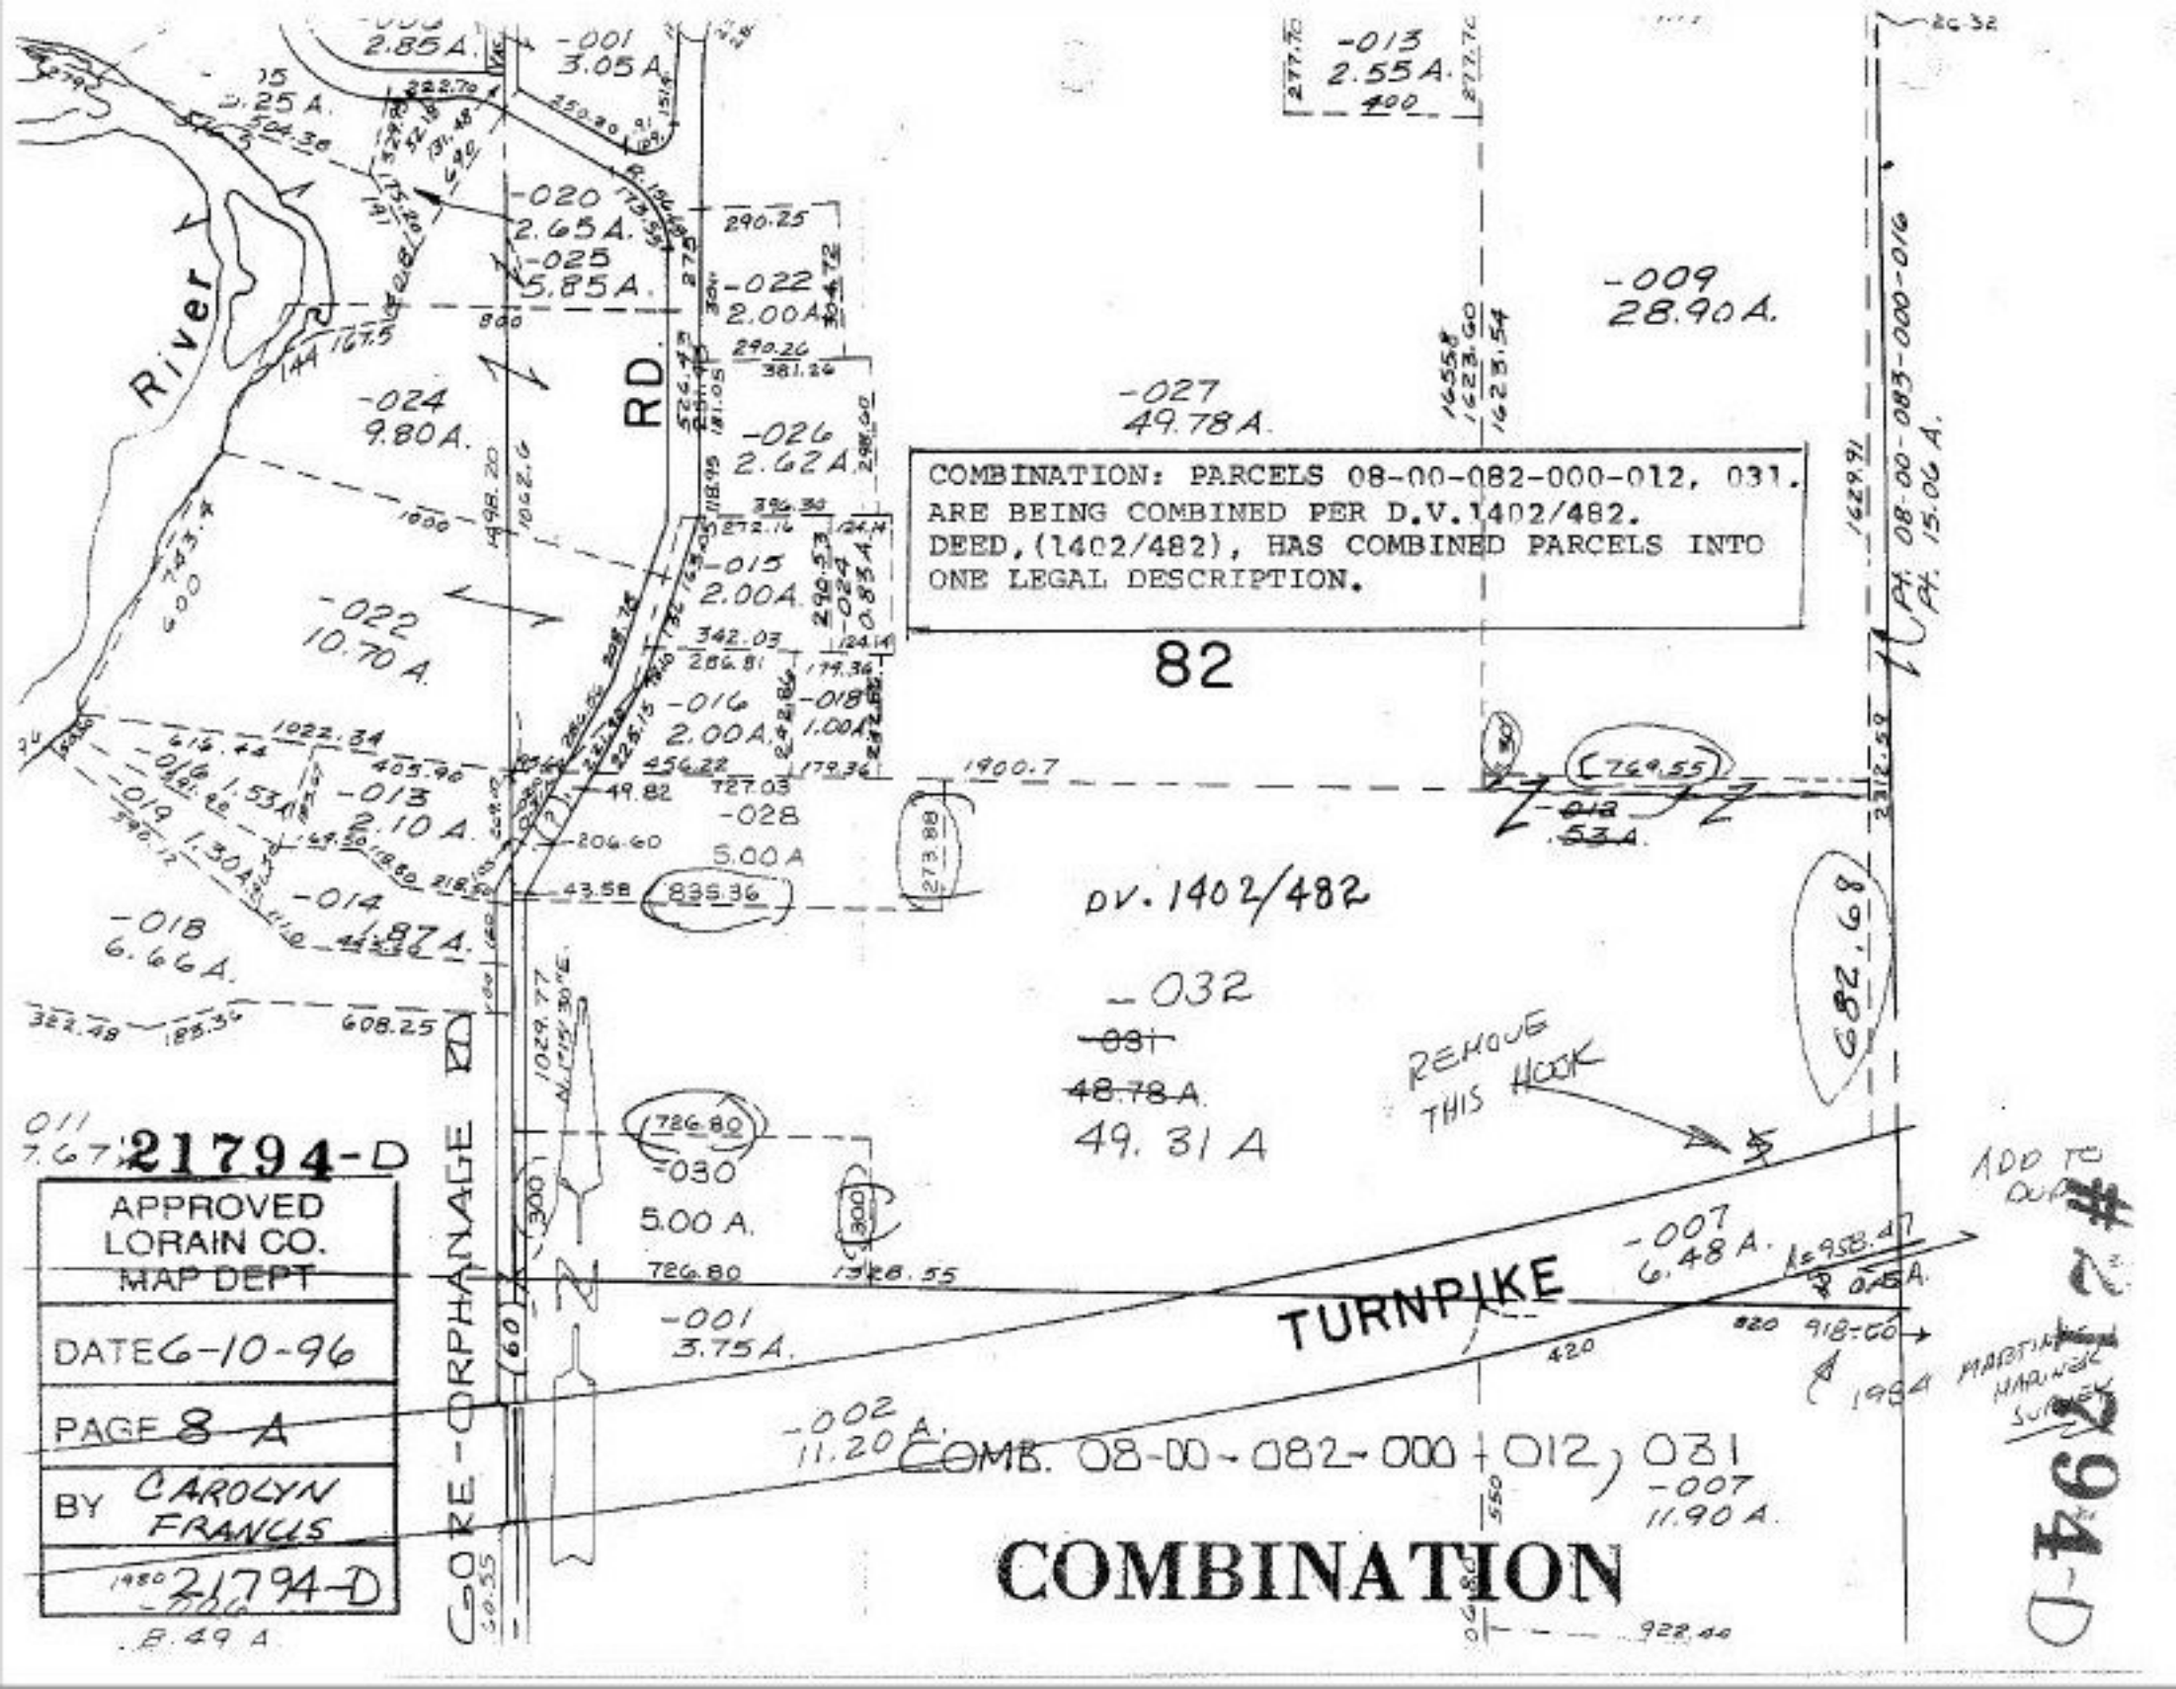
COMBINATION: PARCELS 08-00-082-000-012, 031. ARE BEING COMBINED PER D.V.1402/482. DEED,(1402/482), HAS COMBINED PARCELS INTO ONE LEGAL DESCRIPTION.
82
DV. 1402/482
-032
~~-031~~
~~48.78 A.~~
49.31 A
REMOVE THIS HOOK
-009
28.90 A.
-027
49.78 A.
-013
2.55 A.
-001
3.05 A.
-020
2.65 A.
-025
5.85 A.
-022
2.00 A.
-024
9.80 A.
-026
2.62 A.
-015
2.00 A.
-022
10.70 A.
-016
2.00 A.
-018
1.00 A.
-013
2.10 A.
-028
5.00 A
-014
1.87 A.
-018
6.66 A.
-030
5.00 A.
-001
3.75 A.
-002
11.20 A.
-007
6.48 A.
-007
11.90 A.
River
RD.
GORE-ORPHANAGE RD
TURNPIKE
COMB. 08-00-082-000-012, 031
COMBINATION
21794-D
APPROVED
LORAIN CO.
MAP DEPT
DATE 6-10-96
PAGE 8-A
BY CAROLYN FRANCIS
21794-D
ADD TO DUP
MARTIN HARDINGE SURVEY
#21794-D