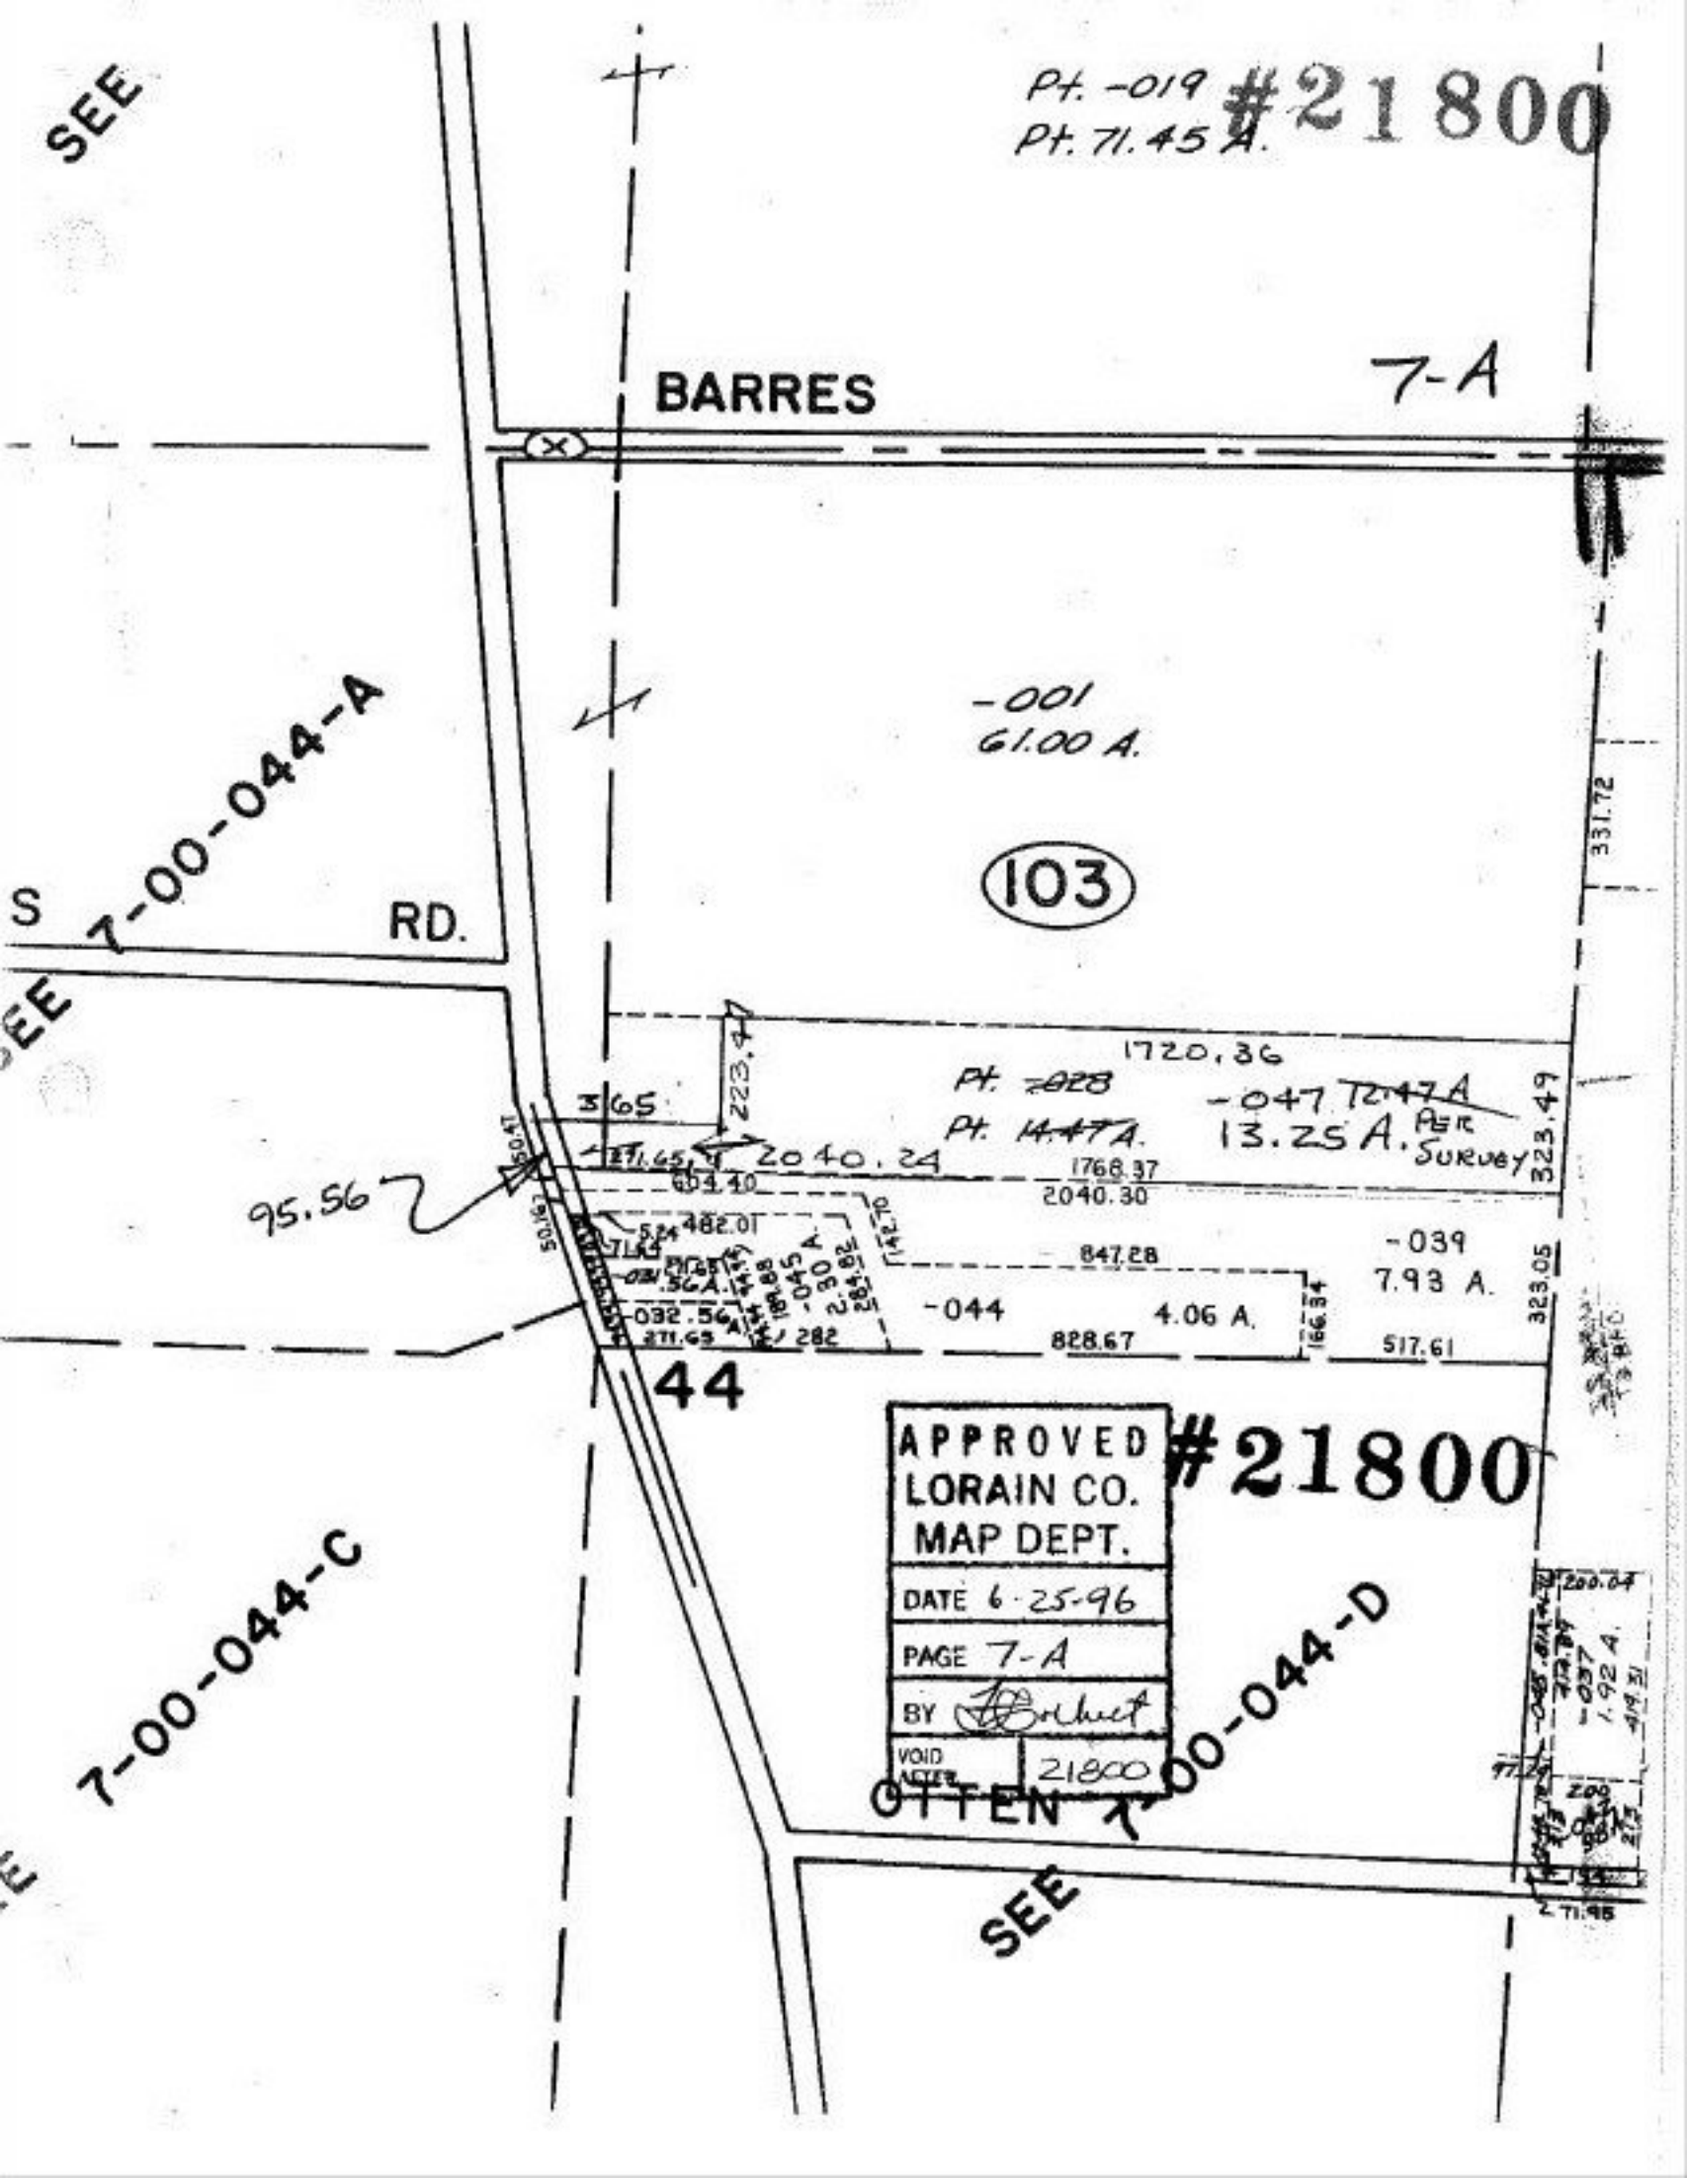

SEE
Pt. -019
Pt. 71.45 A.
#21800
BARRES
7-A
-001
61.00 A.
103
7-00-044-A
S
RD.
SEE
1720.36
Pt. -028
Pt. 14.47 A.
-047 12.47 A
13.25 A. PER SURVEY
323.49
331.72
223.47
3.65
2040.24
1768.37
2040.30
95.56
482.01
847.28
-039
7.93 A.
323.05
-044
4.06 A.
828.67
517.61
166.34
44
APPROVED
LORAIN CO.
MAP DEPT.
DATE 6-25-96
PAGE 7-A
BY
VOID AFTER 21800
#21800
7-00-044-C
7-00-044-D
OTTEN
SEE