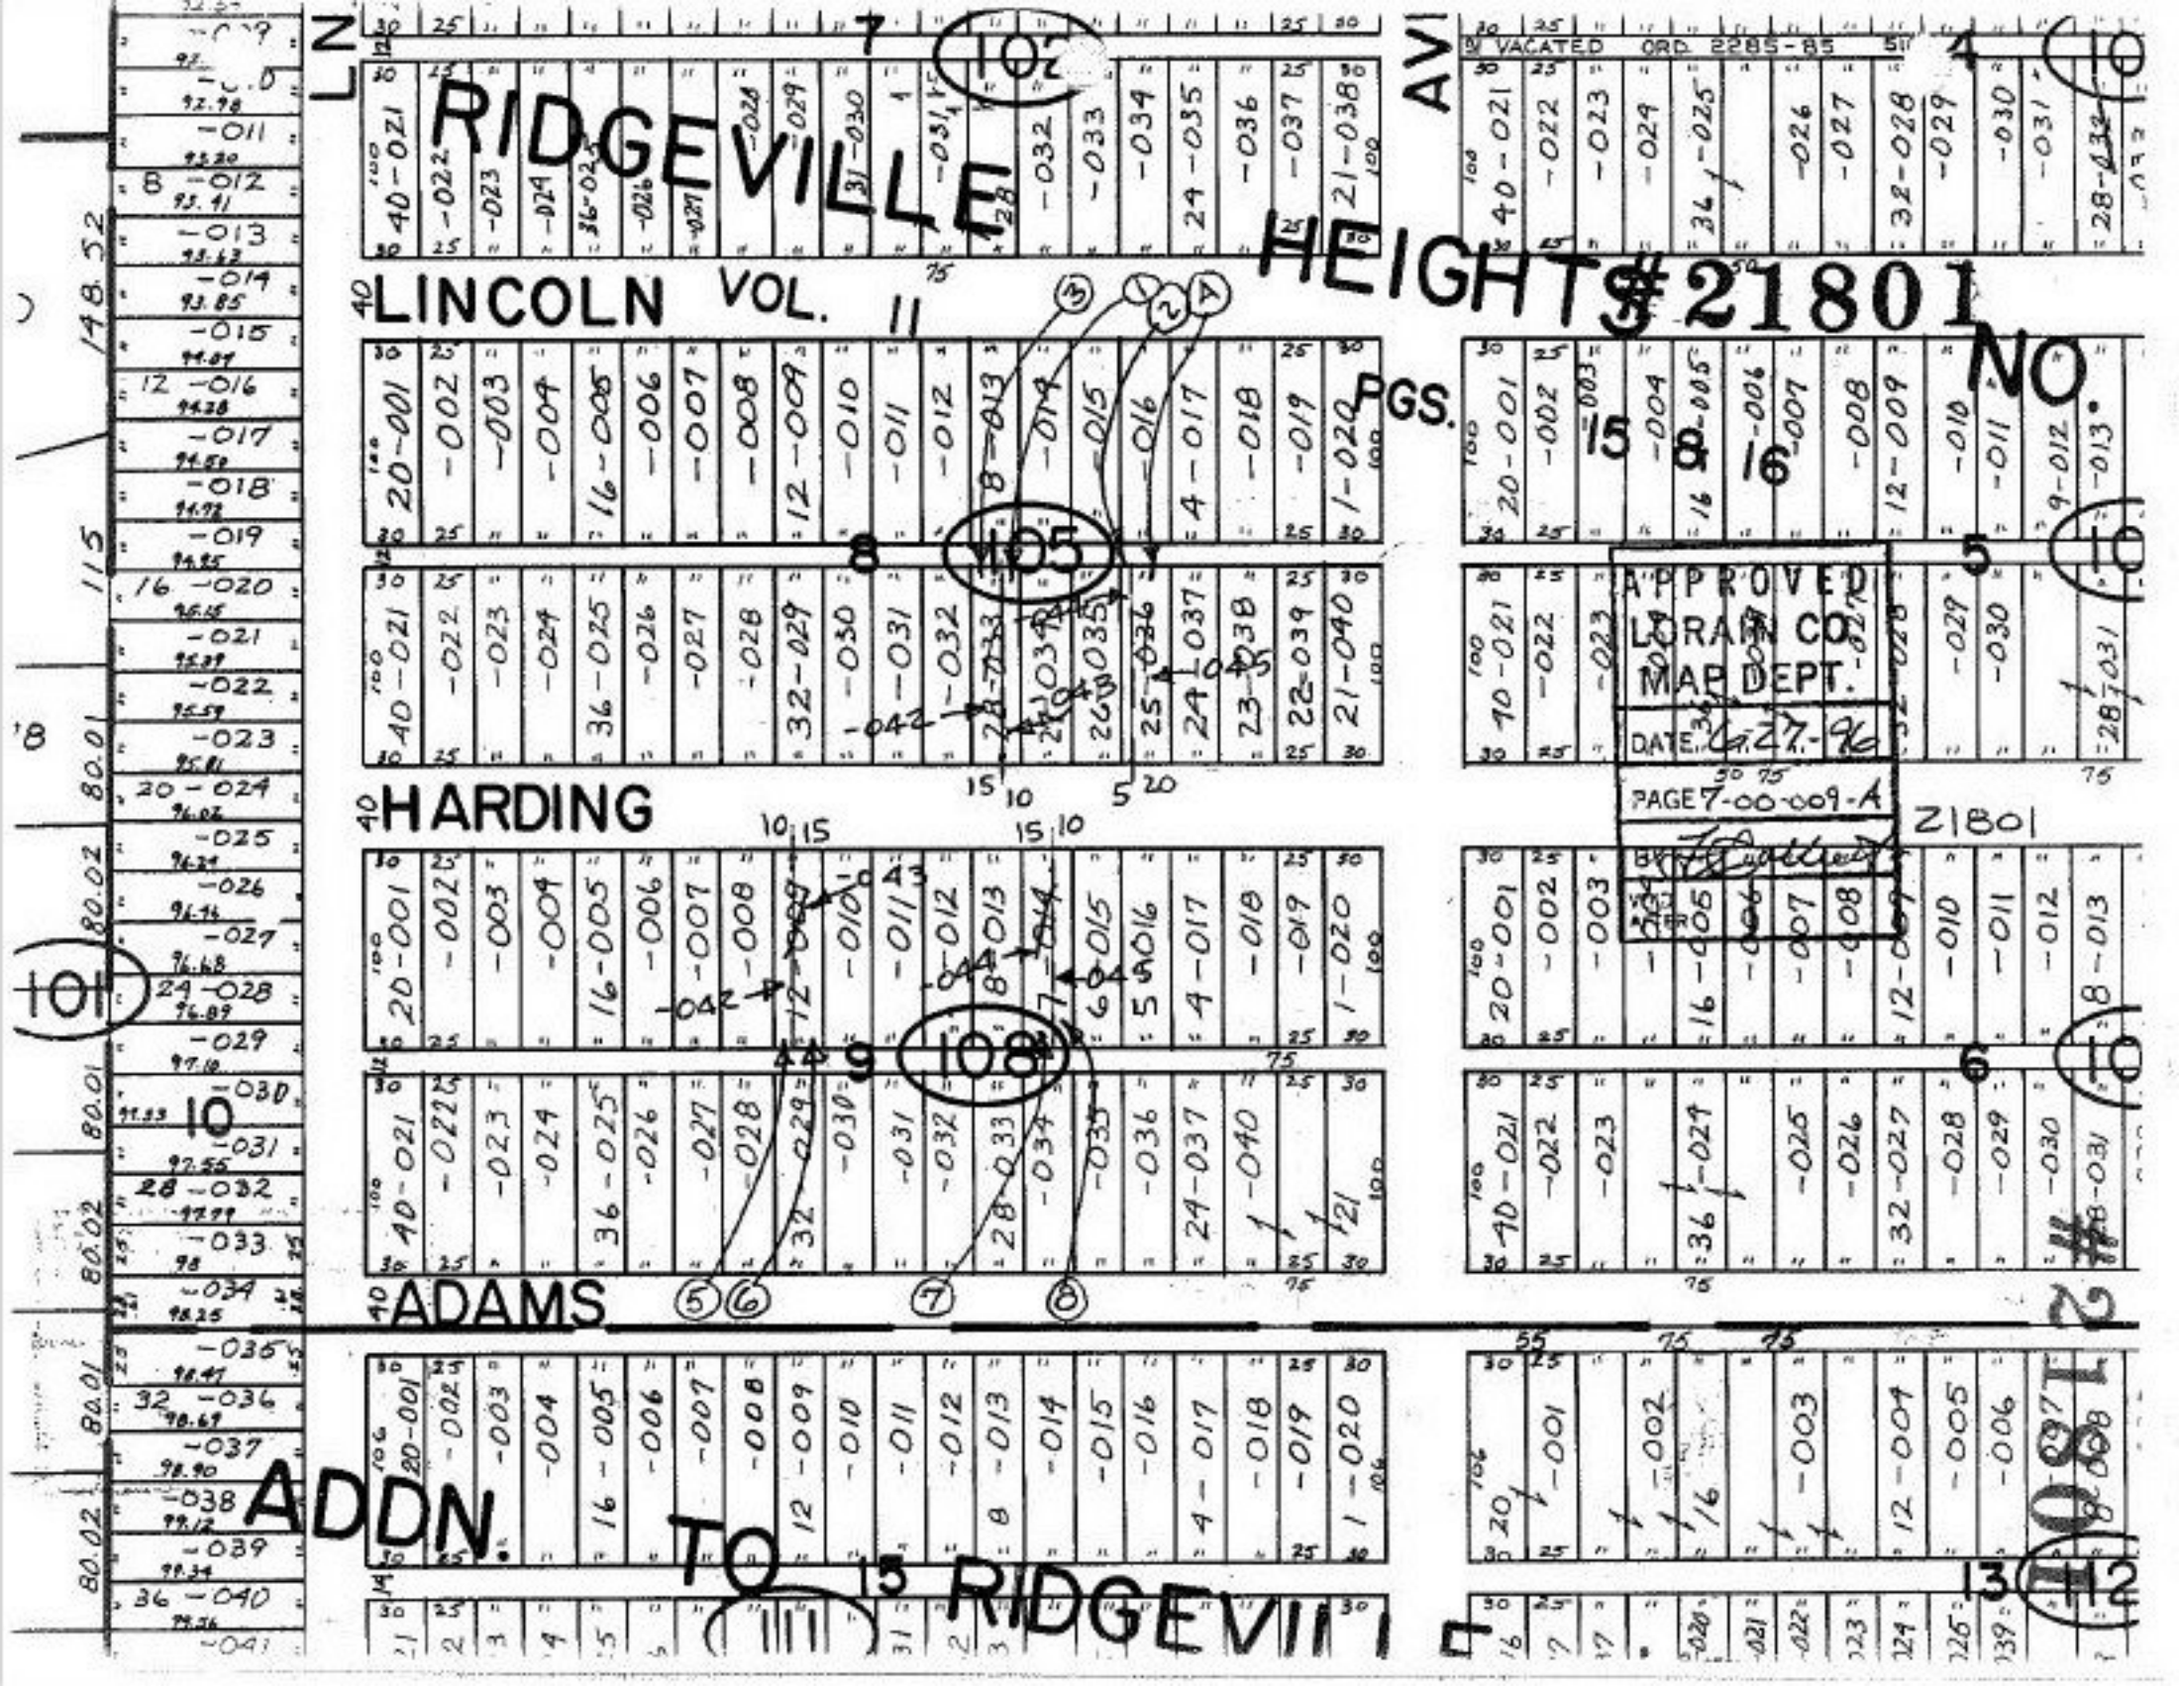
RIDGEVILLE HEIGHTS #21801
ADDN TO RIDGEVILLE
LINCOLN
HARDING
ADAMS
VOL. 11
VACATED ORD 2285-85
APPROVED
LORAIN CO.
MAP DEPT.
DATE 4-27-96
PAGE 7-00-009-A
21801
NO