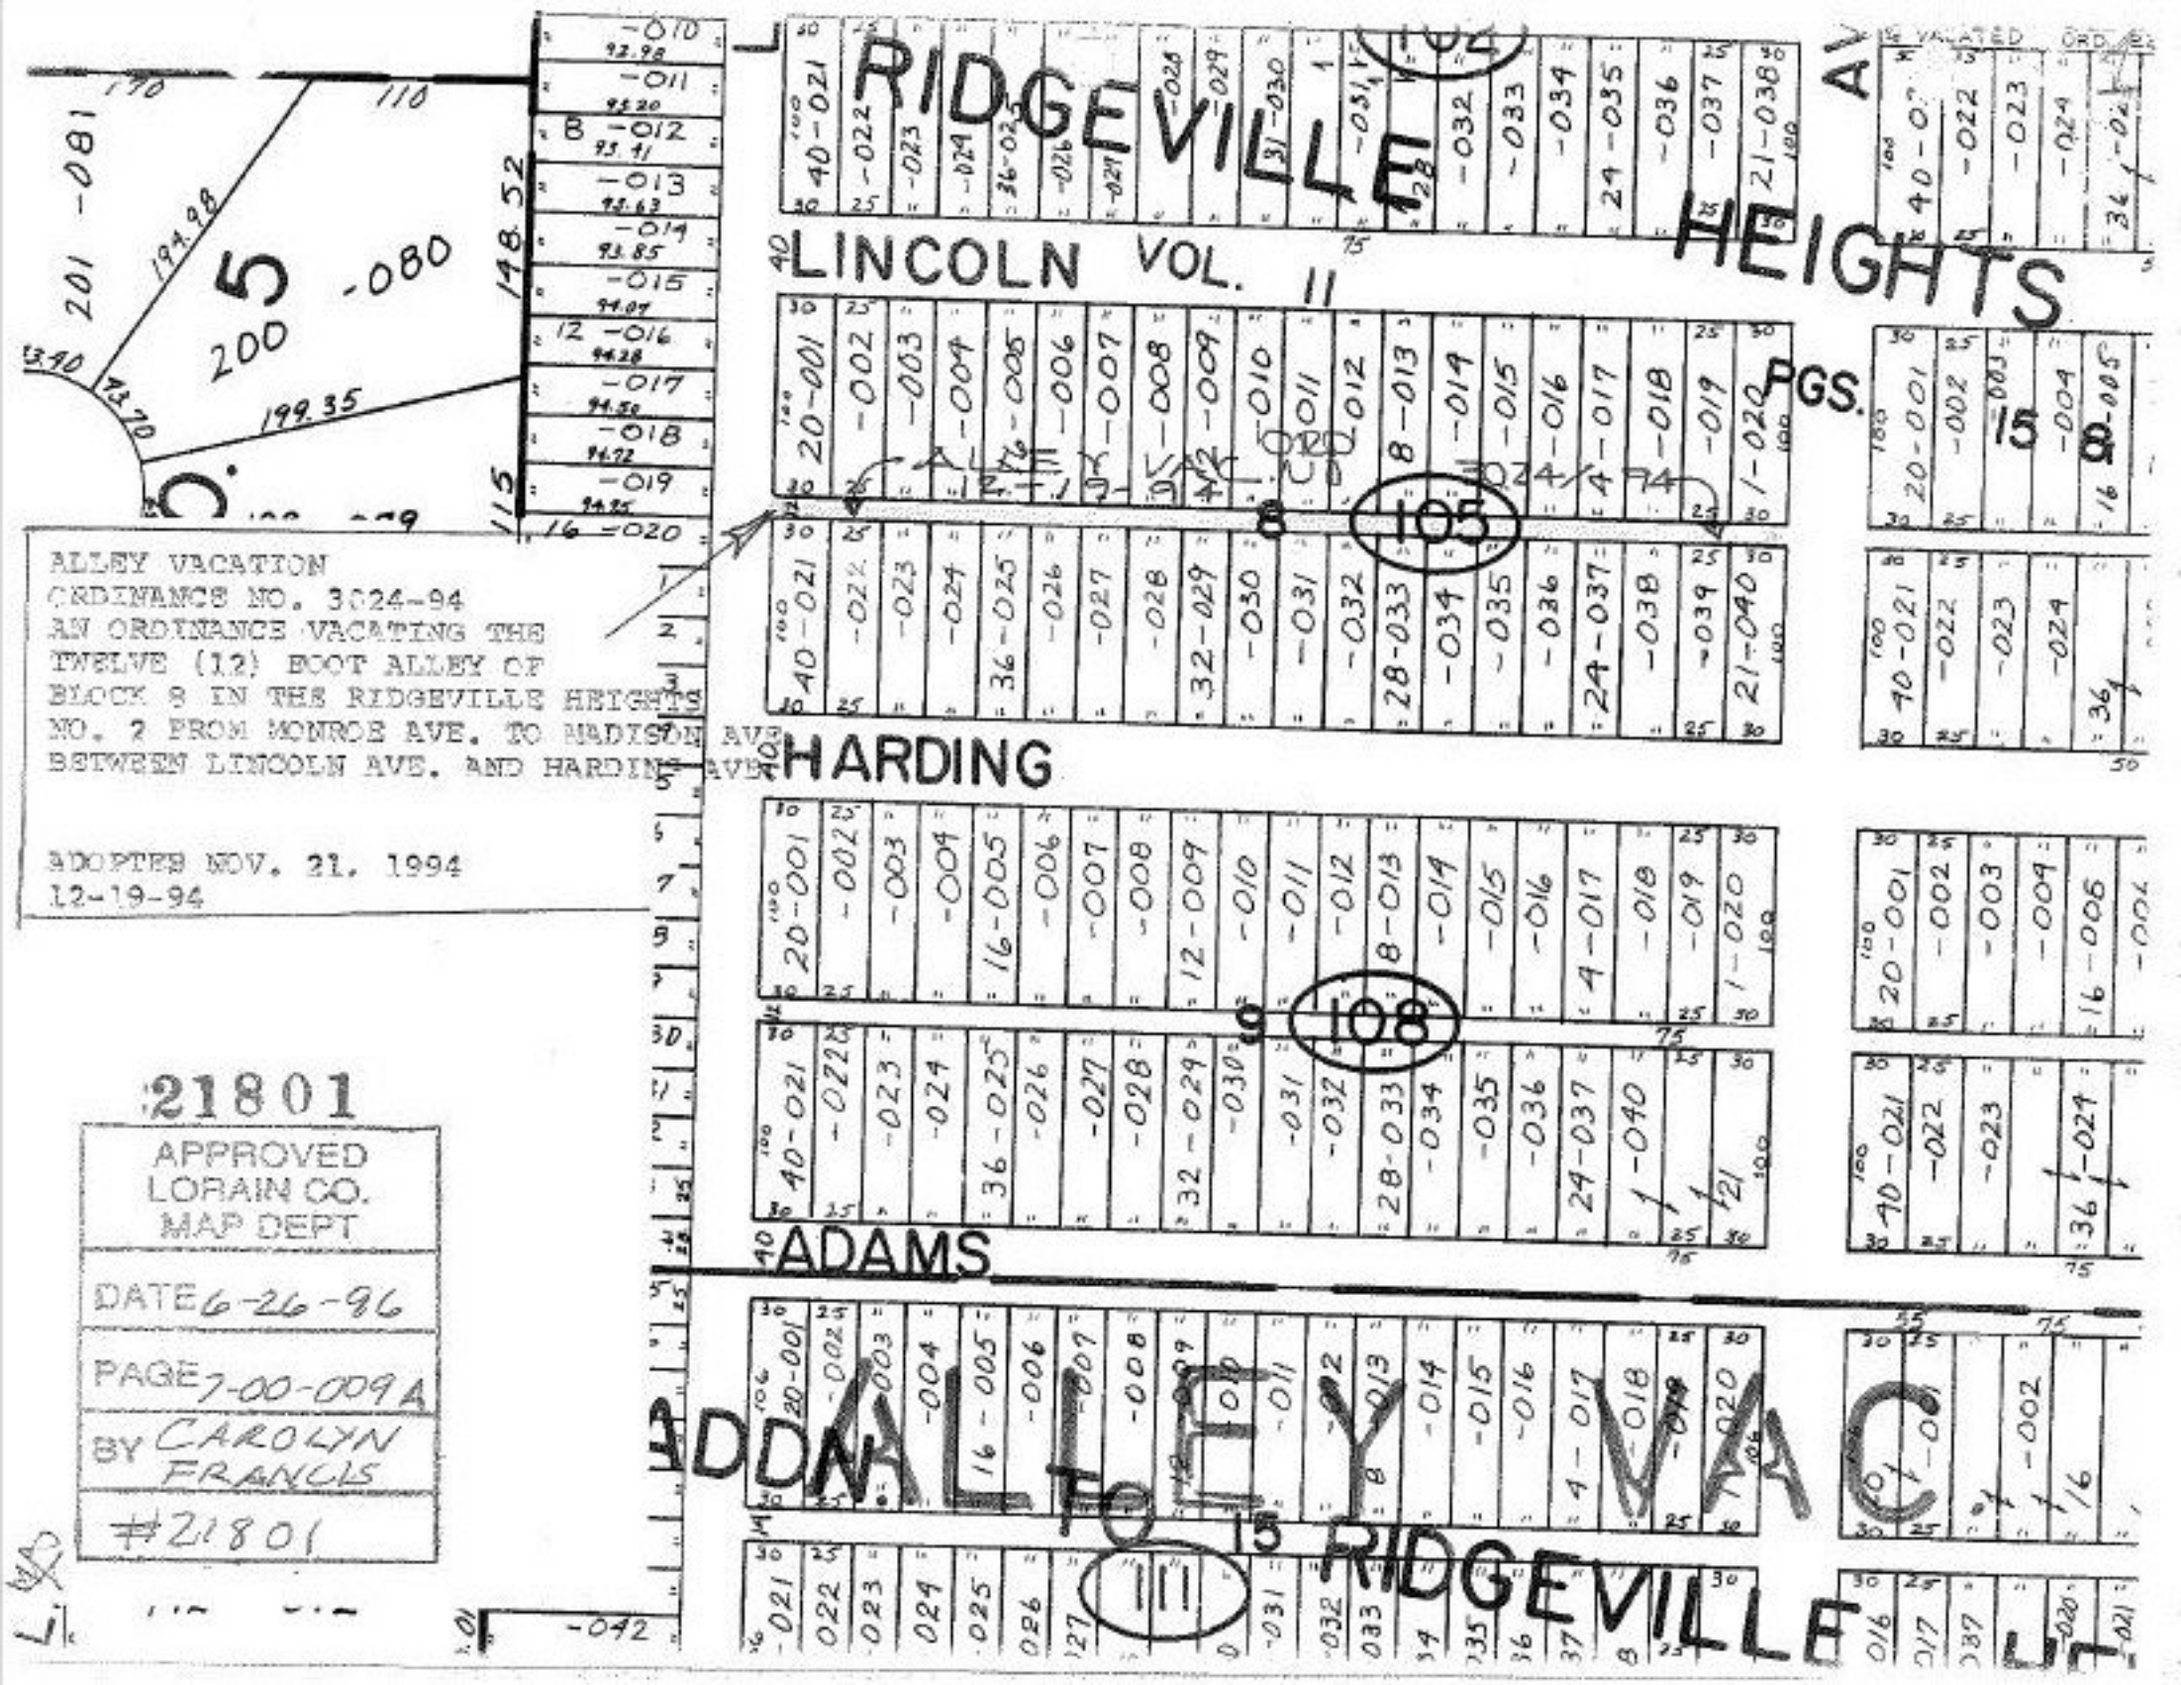
RIDGEVILLE HEIGHTS
LINCOLN
VOL. 11
PGS.
HARDING
ADAMS
ADDN. TO RIDGEVILLE
ALLEY VACATION
ORDINANCE NO. 3024-94
AN ORDINANCE VACATING THE TWELVE (12) FOOT ALLEY OF BLOCK 8 IN THE RIDGEVILLE HEIGHTS NO. 2 FROM MONROE AVE. TO MADISON AVE BETWEEN LINCOLN AVE. AND HARDING AVE
ADOPTED NOV. 21. 1994
12-19-94
21801
APPROVED
LORAIN CO.
MAP DEPT
DATE 6-26-96
PAGE 7-00-009A
BY CAROLYN FRANCIS
#21801