#21802

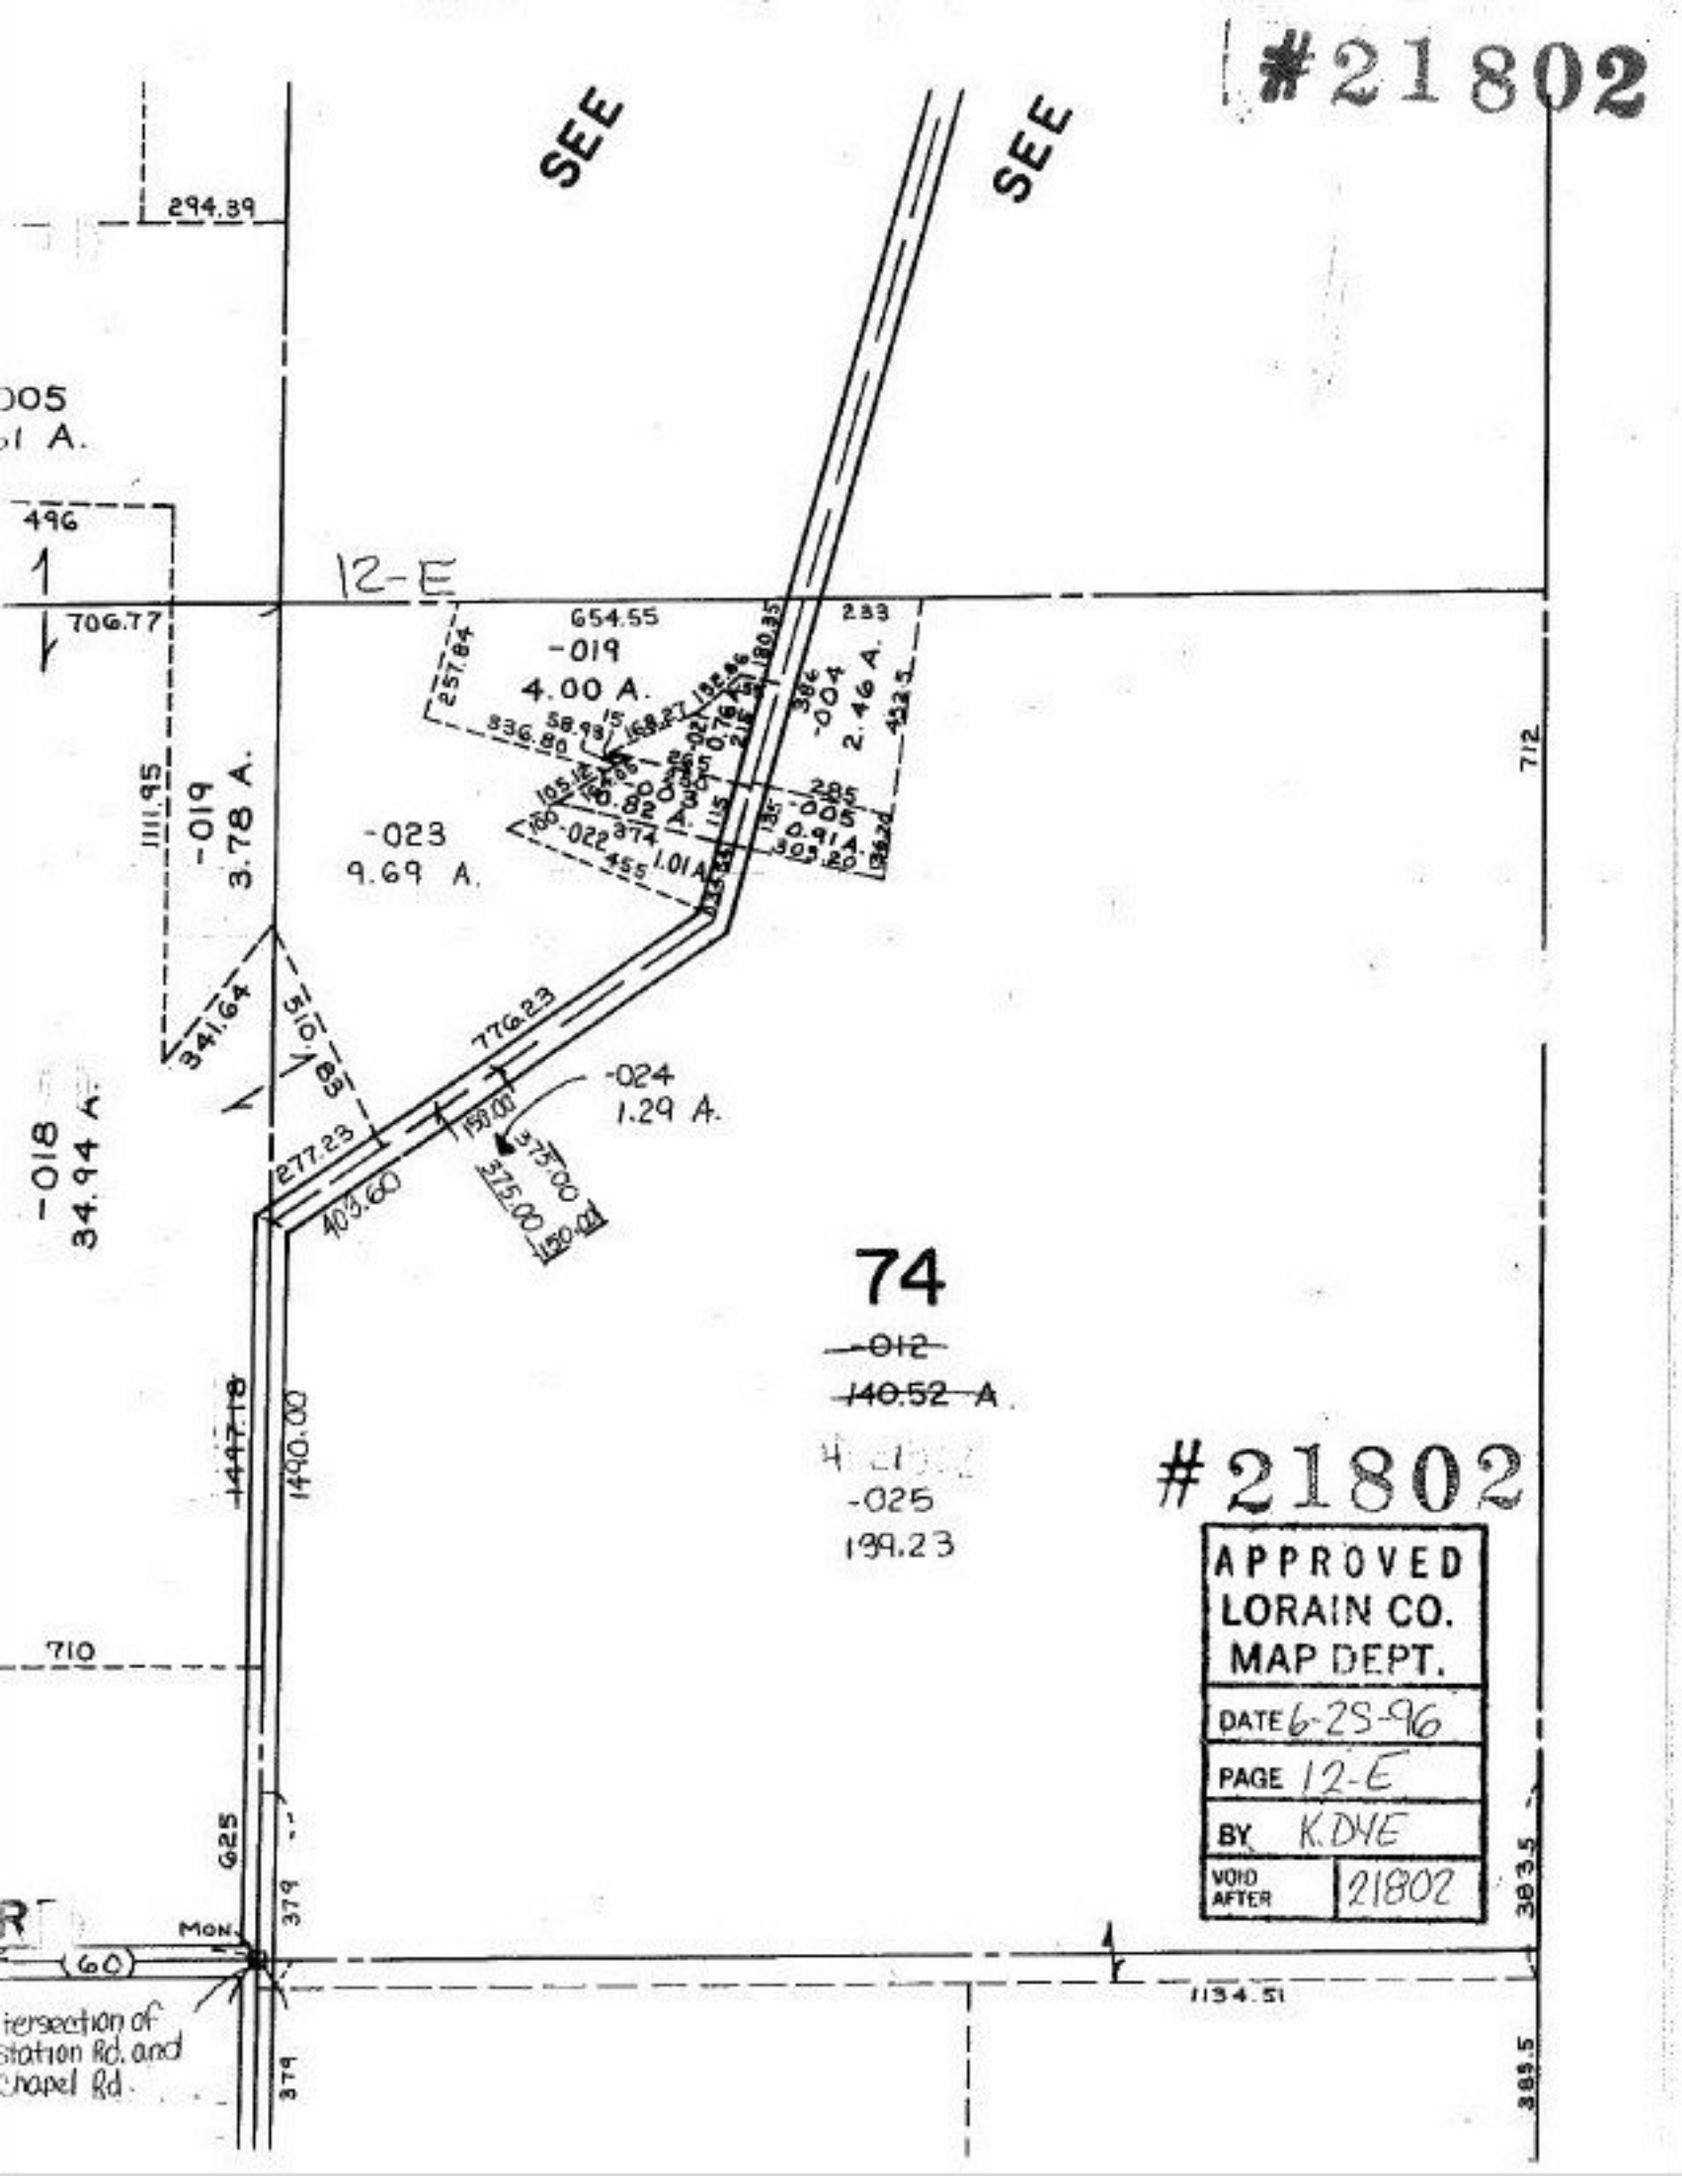


#21802

APPROVED
LORAIN CO.
MAP DEPT.

| | |
|---|---|
| DATE | 6-25-96 |
| PAGE | 12-E |
| BY | K.DYE |
| VOID AFTER | 21802 |