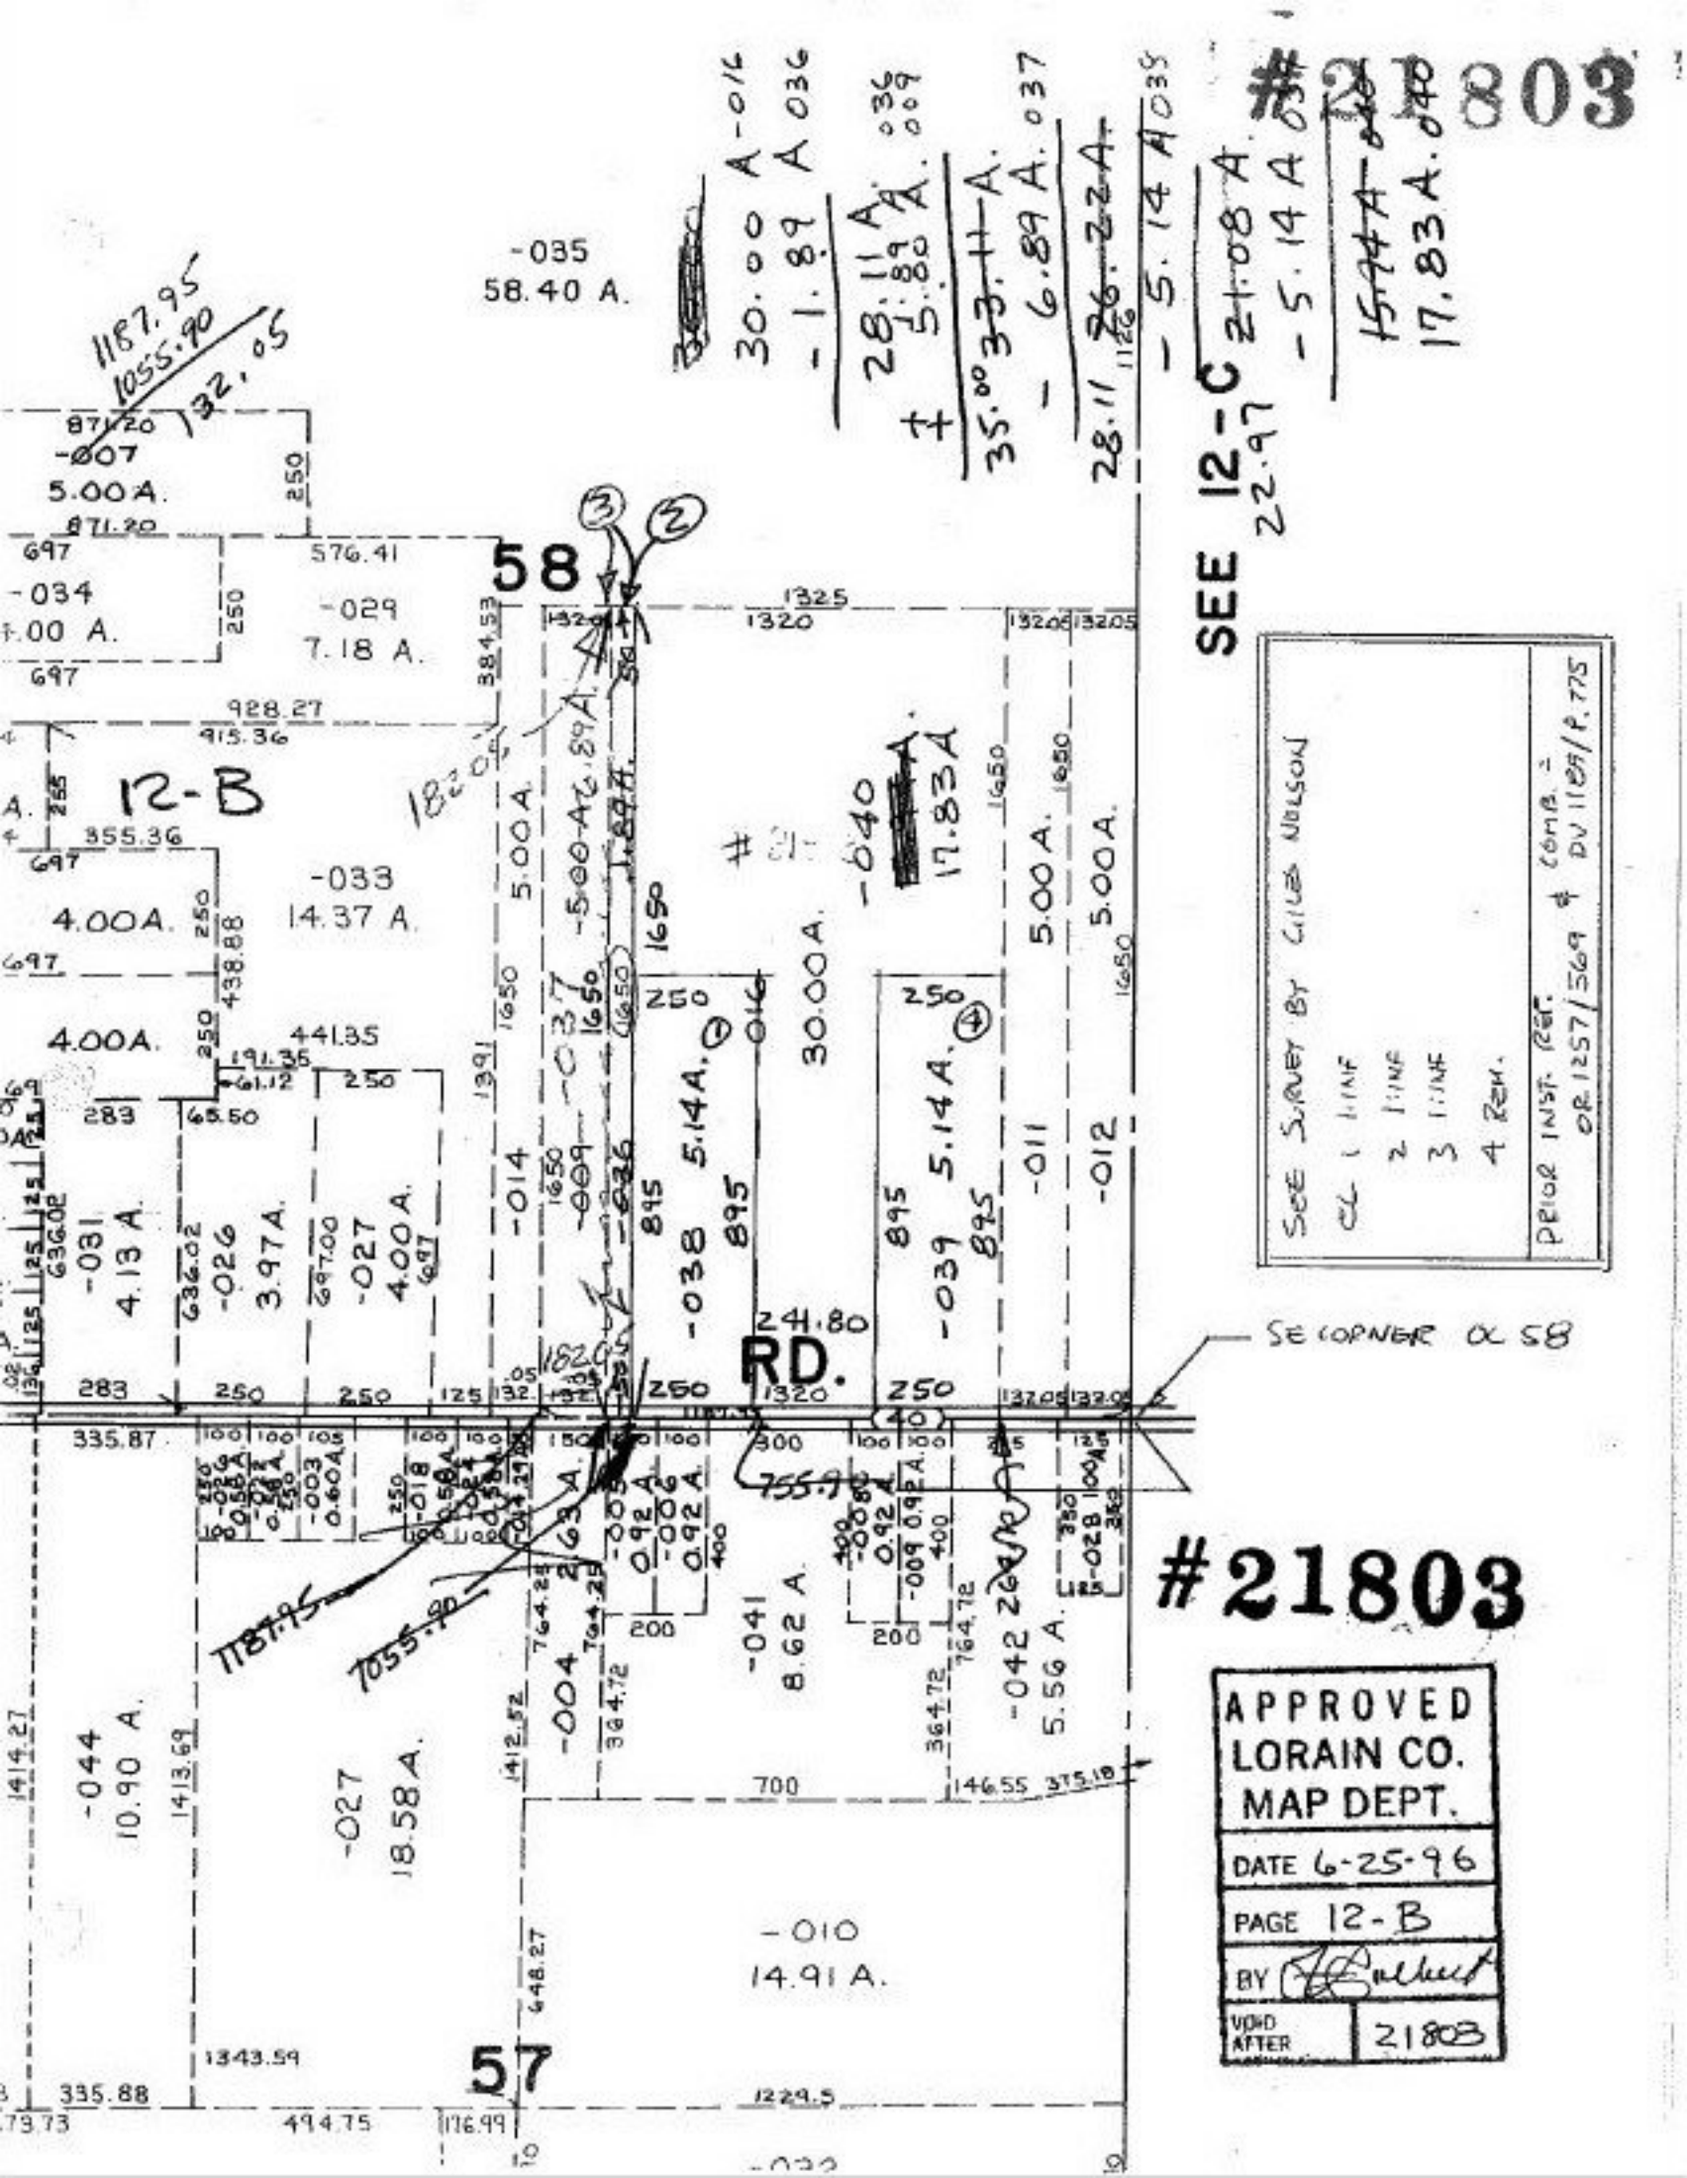
#21803
SEE 12-C
58
57
RD.
12-B
SEE SURVEY BY GILES NELSON
PRIOR INST. REF. OR 1257/569 & COMB. = OR 1128/P. 775
SE CORNER OF 58
APPROVED
LORAIN CO.
MAP DEPT.
DATE 6-25-96
PAGE 12-B
BY
VOID AFTER 21803