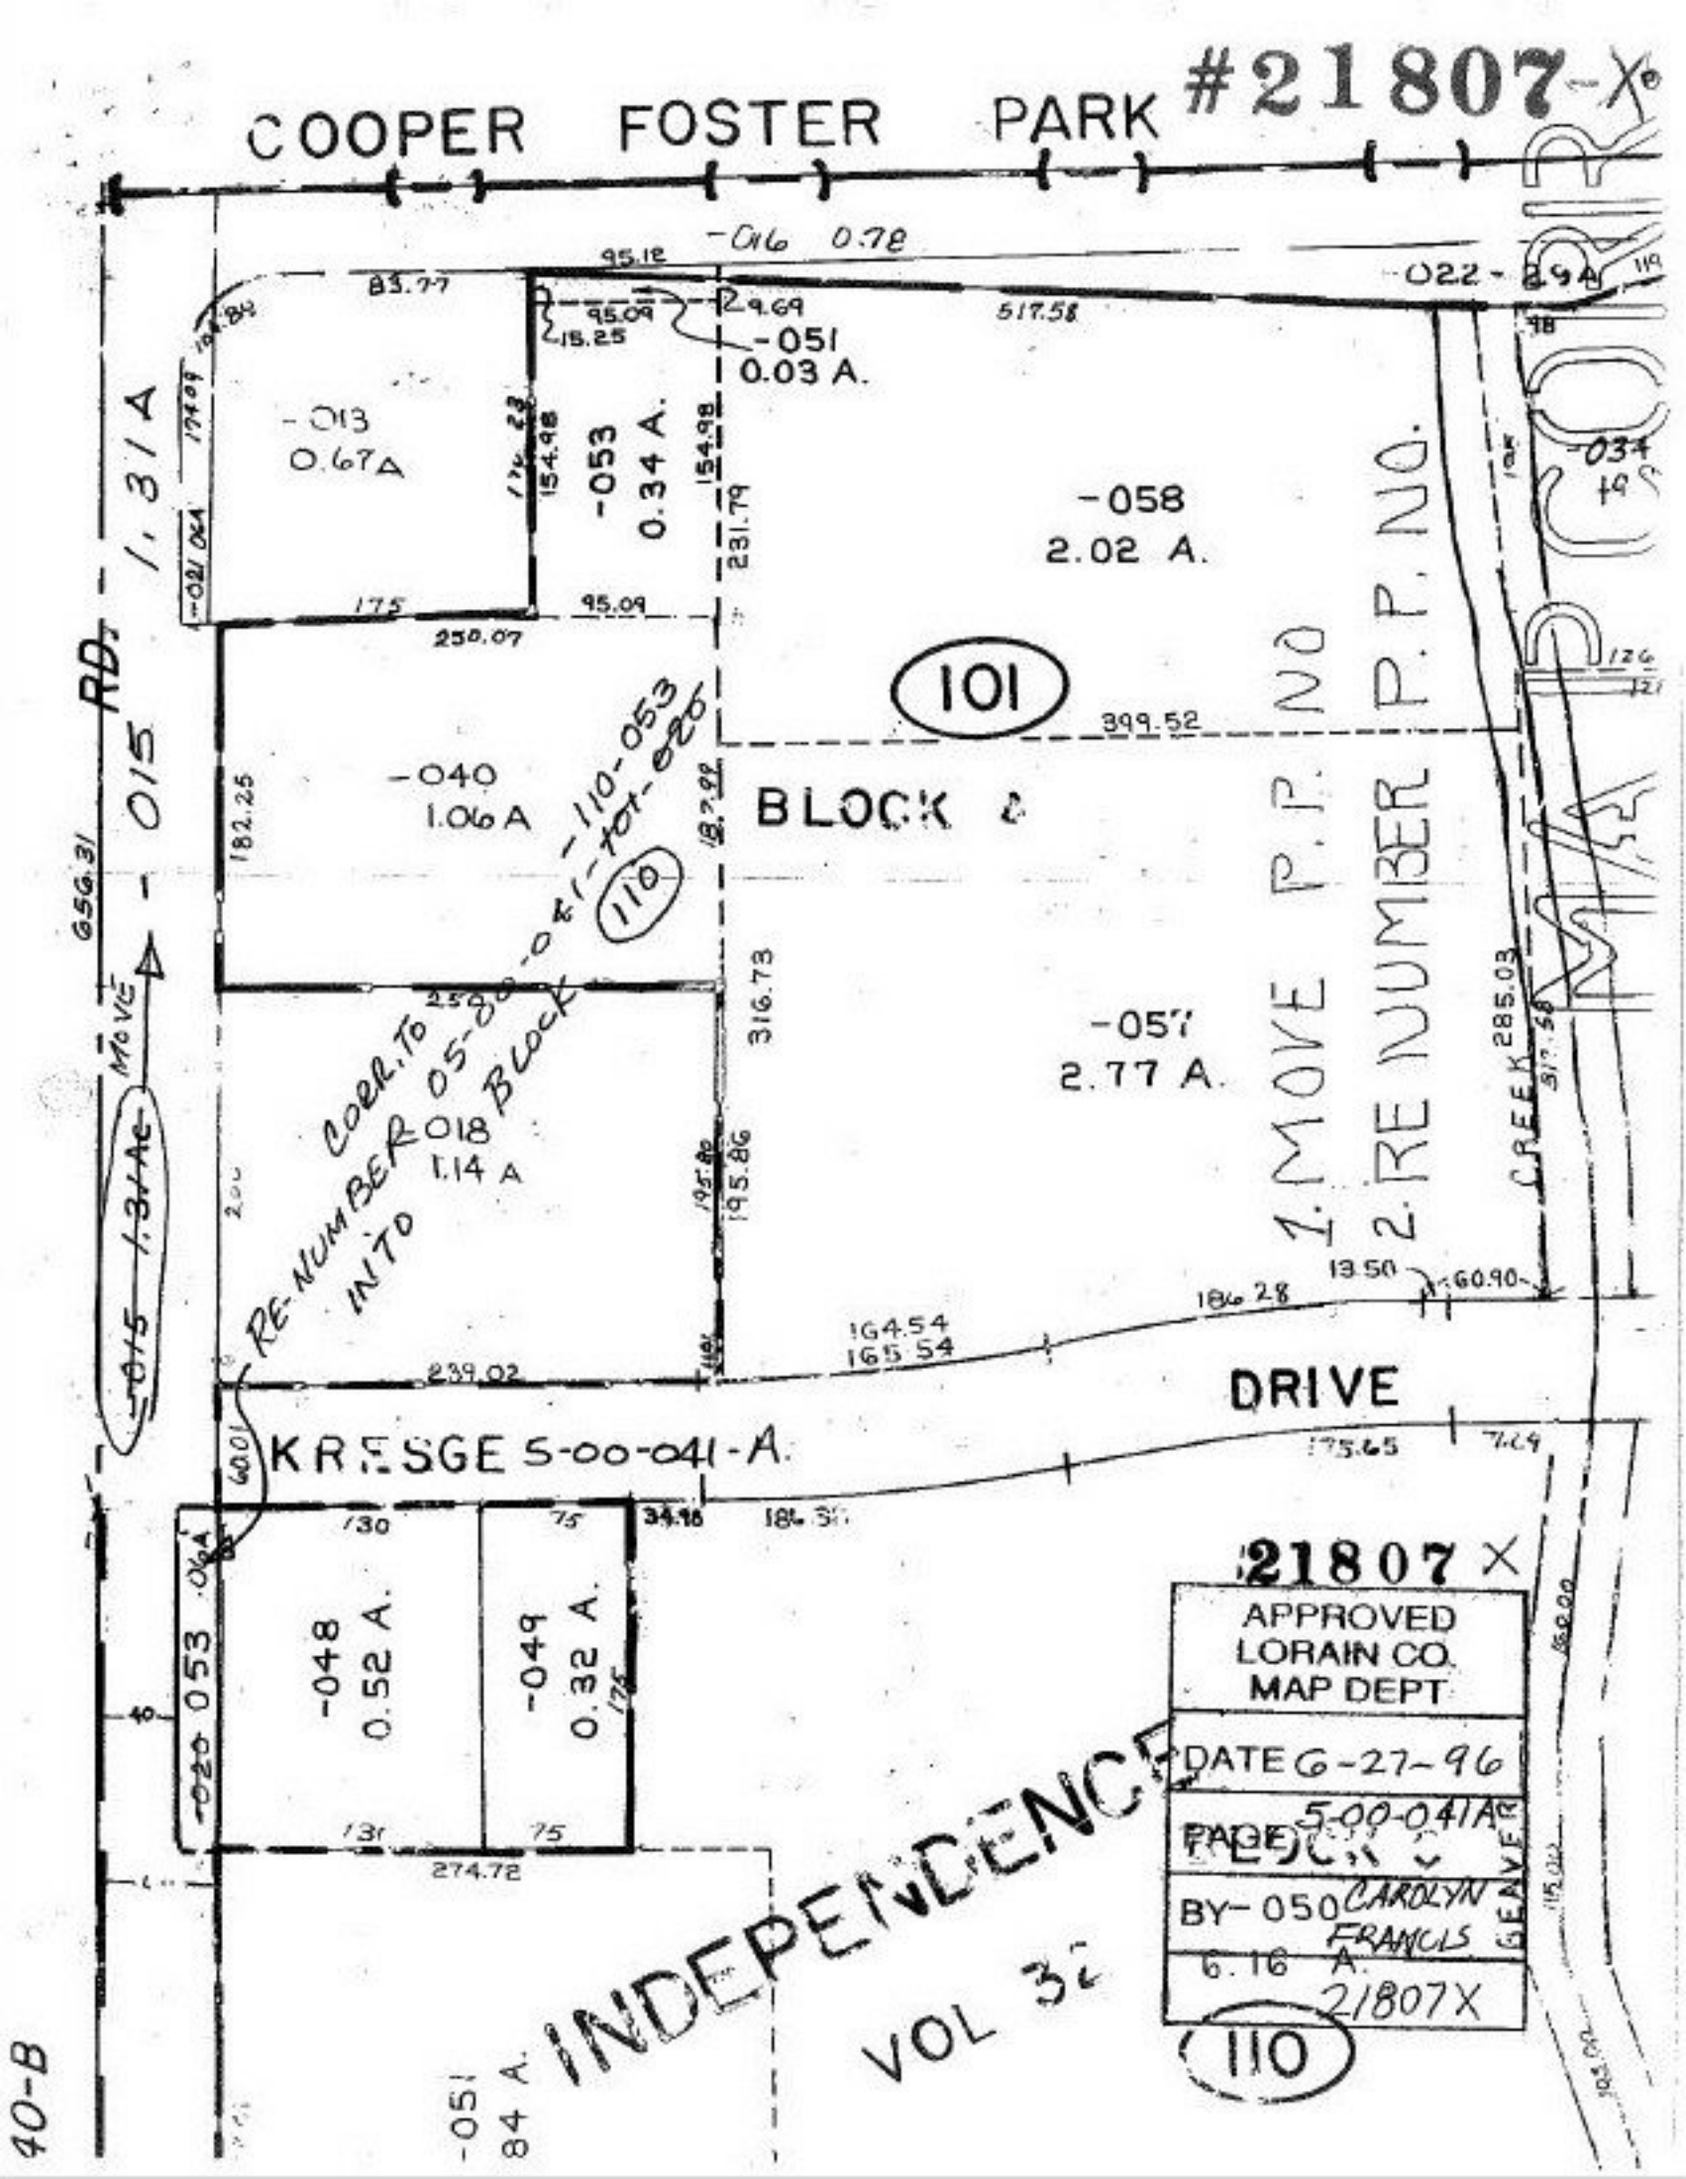

#21807-X
COOPER FOSTER PARK
-016 0.78
-022 - 2.9A
-051
0.03 A.
-013
0.67A
-053
0.34 A.
-058
2.02 A.
101
-040
1.06 A
BLOCK 2
-110-053
-101-020
110
-057
2.77 A.
1. MOVE P.P. NO
2. RE NUMBER P.P. NO.
CORR. TO RE-NUMBER 05-00-041-101-020 INTO BLOCK
-018
1.14 A
-015 1.31 Ac
MOVE
RD. - 015 - 1.31 A
CREEK
DRIVE
KRESGE 5-00-041-A.
-048
0.52 A.
-049
0.32 A.
-020 053
-051
84 A.
INDEPENDENCE
VOL 32
21807 X
APPROVED
LORAIN CO.
MAP DEPT
DATE 6-27-96
PAGE 5-00-041A
BY- 050 CAROLYN FRANCIS
6.16 A.
21807X
110
40-B