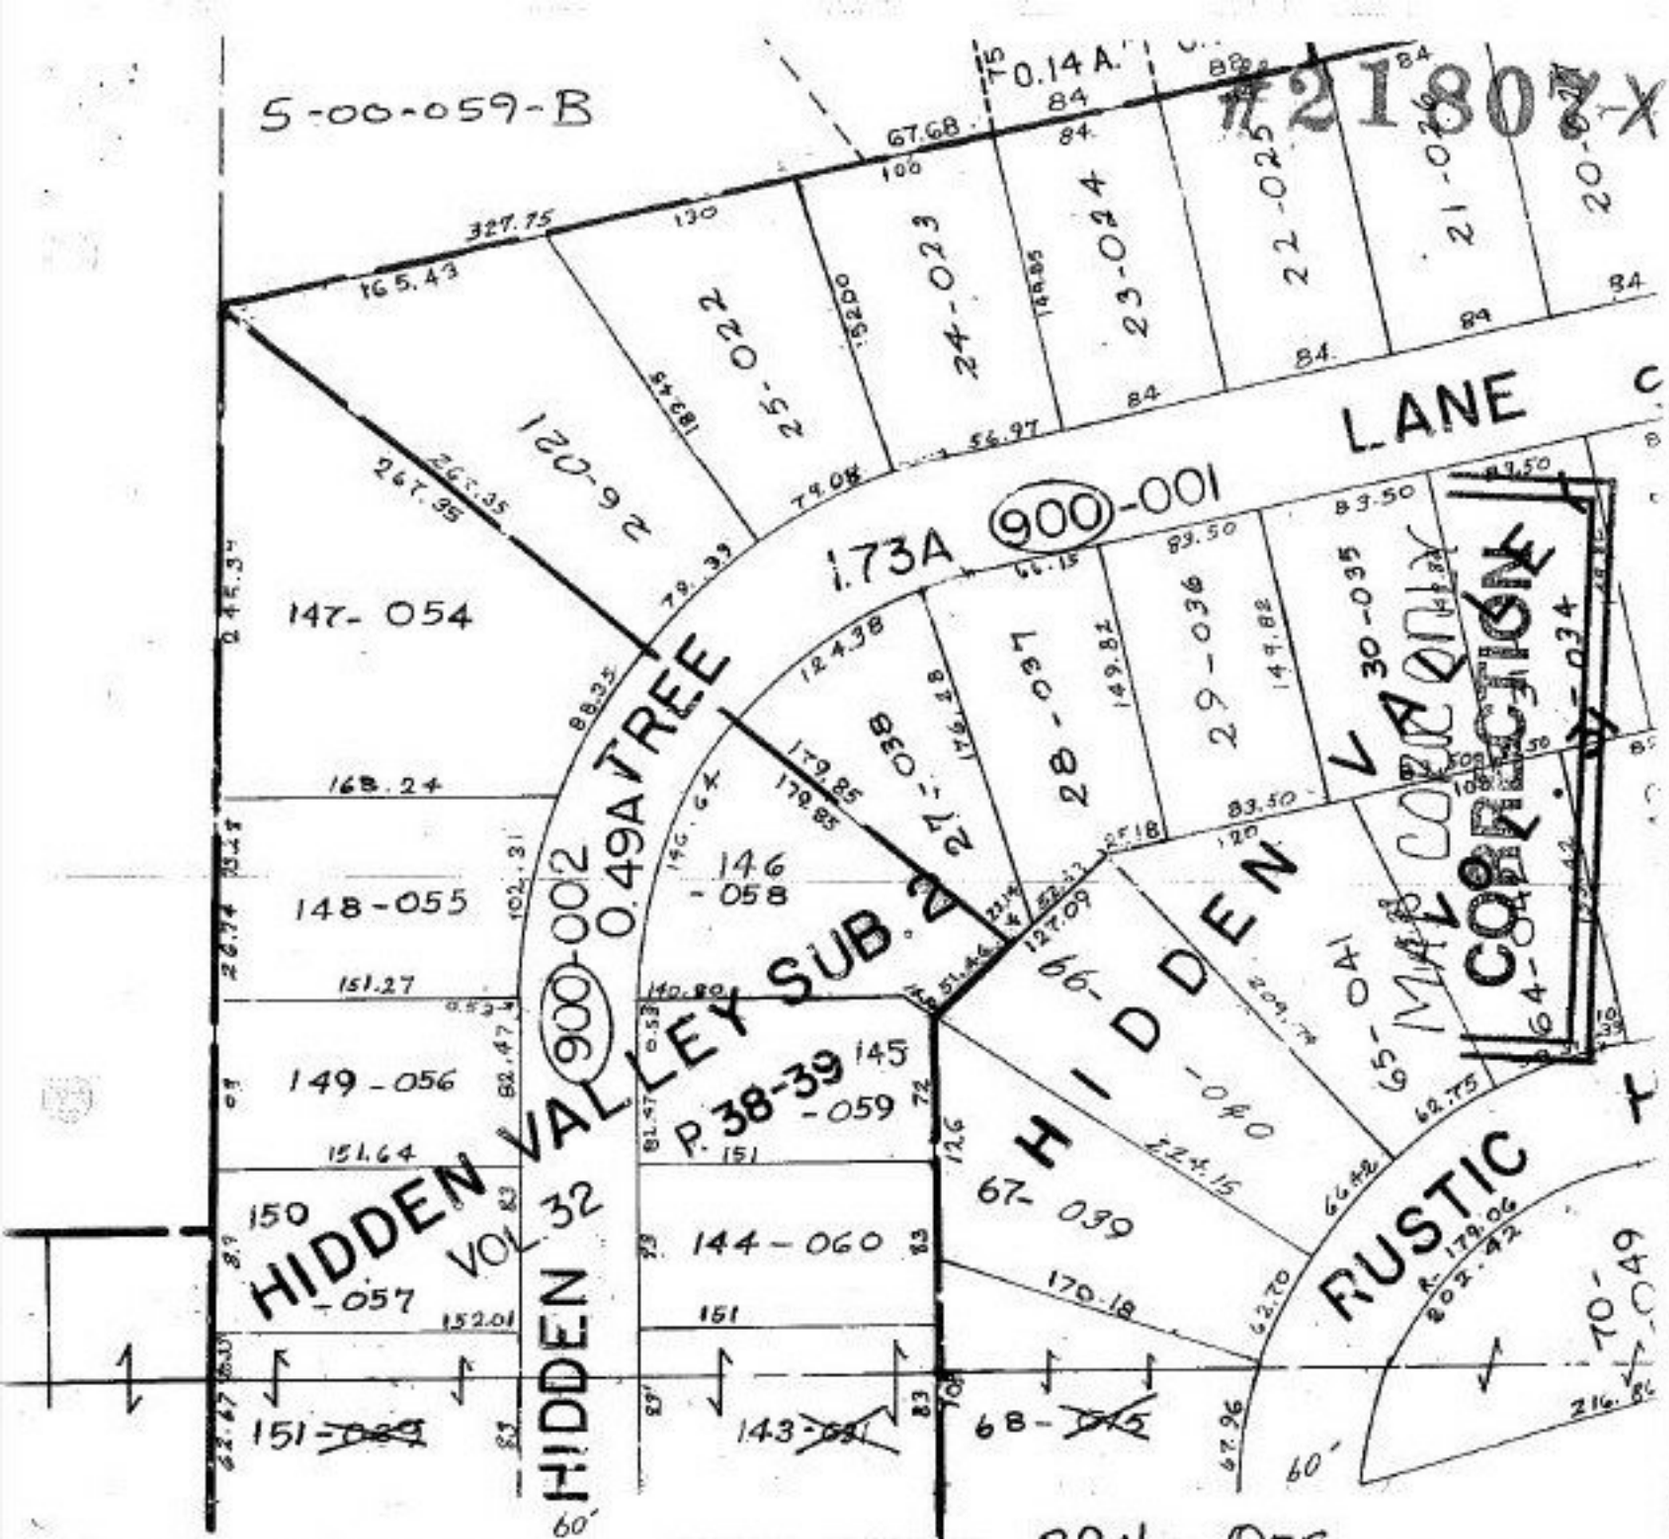
5-00-059-B
#21807 X
0.14 A.
67.68
327.75
165.43
25-022
24-023
23-024
22-025
21-026
20-027
LANE
1.73A
900-001
147-054
148-055
149-056
150
-057
151-089
HIDDEN VALLEY SUB. 2
VOL 32
P. 38-39
900-002
0.49A
TREE
146
-058
145
-059
144-060
143-061
HIDDEN VALLEY
27-038
28-037
29-036
30-035
64-034
65-041
66-040
67-039
68-042
MAP CORRECTION
RUSTIC
SEE 05-00-058-B
TAKE THESE P.P. Nos. OFF.
21807 X
APPROVED
LORAIN CO.
MAP DEPT
DATE 6-27-96
PAGE 5-00-059-B
BY CAROLYN
FRANCIS
#21807 X
WP.
E ly PT. LOT 59