#21807X

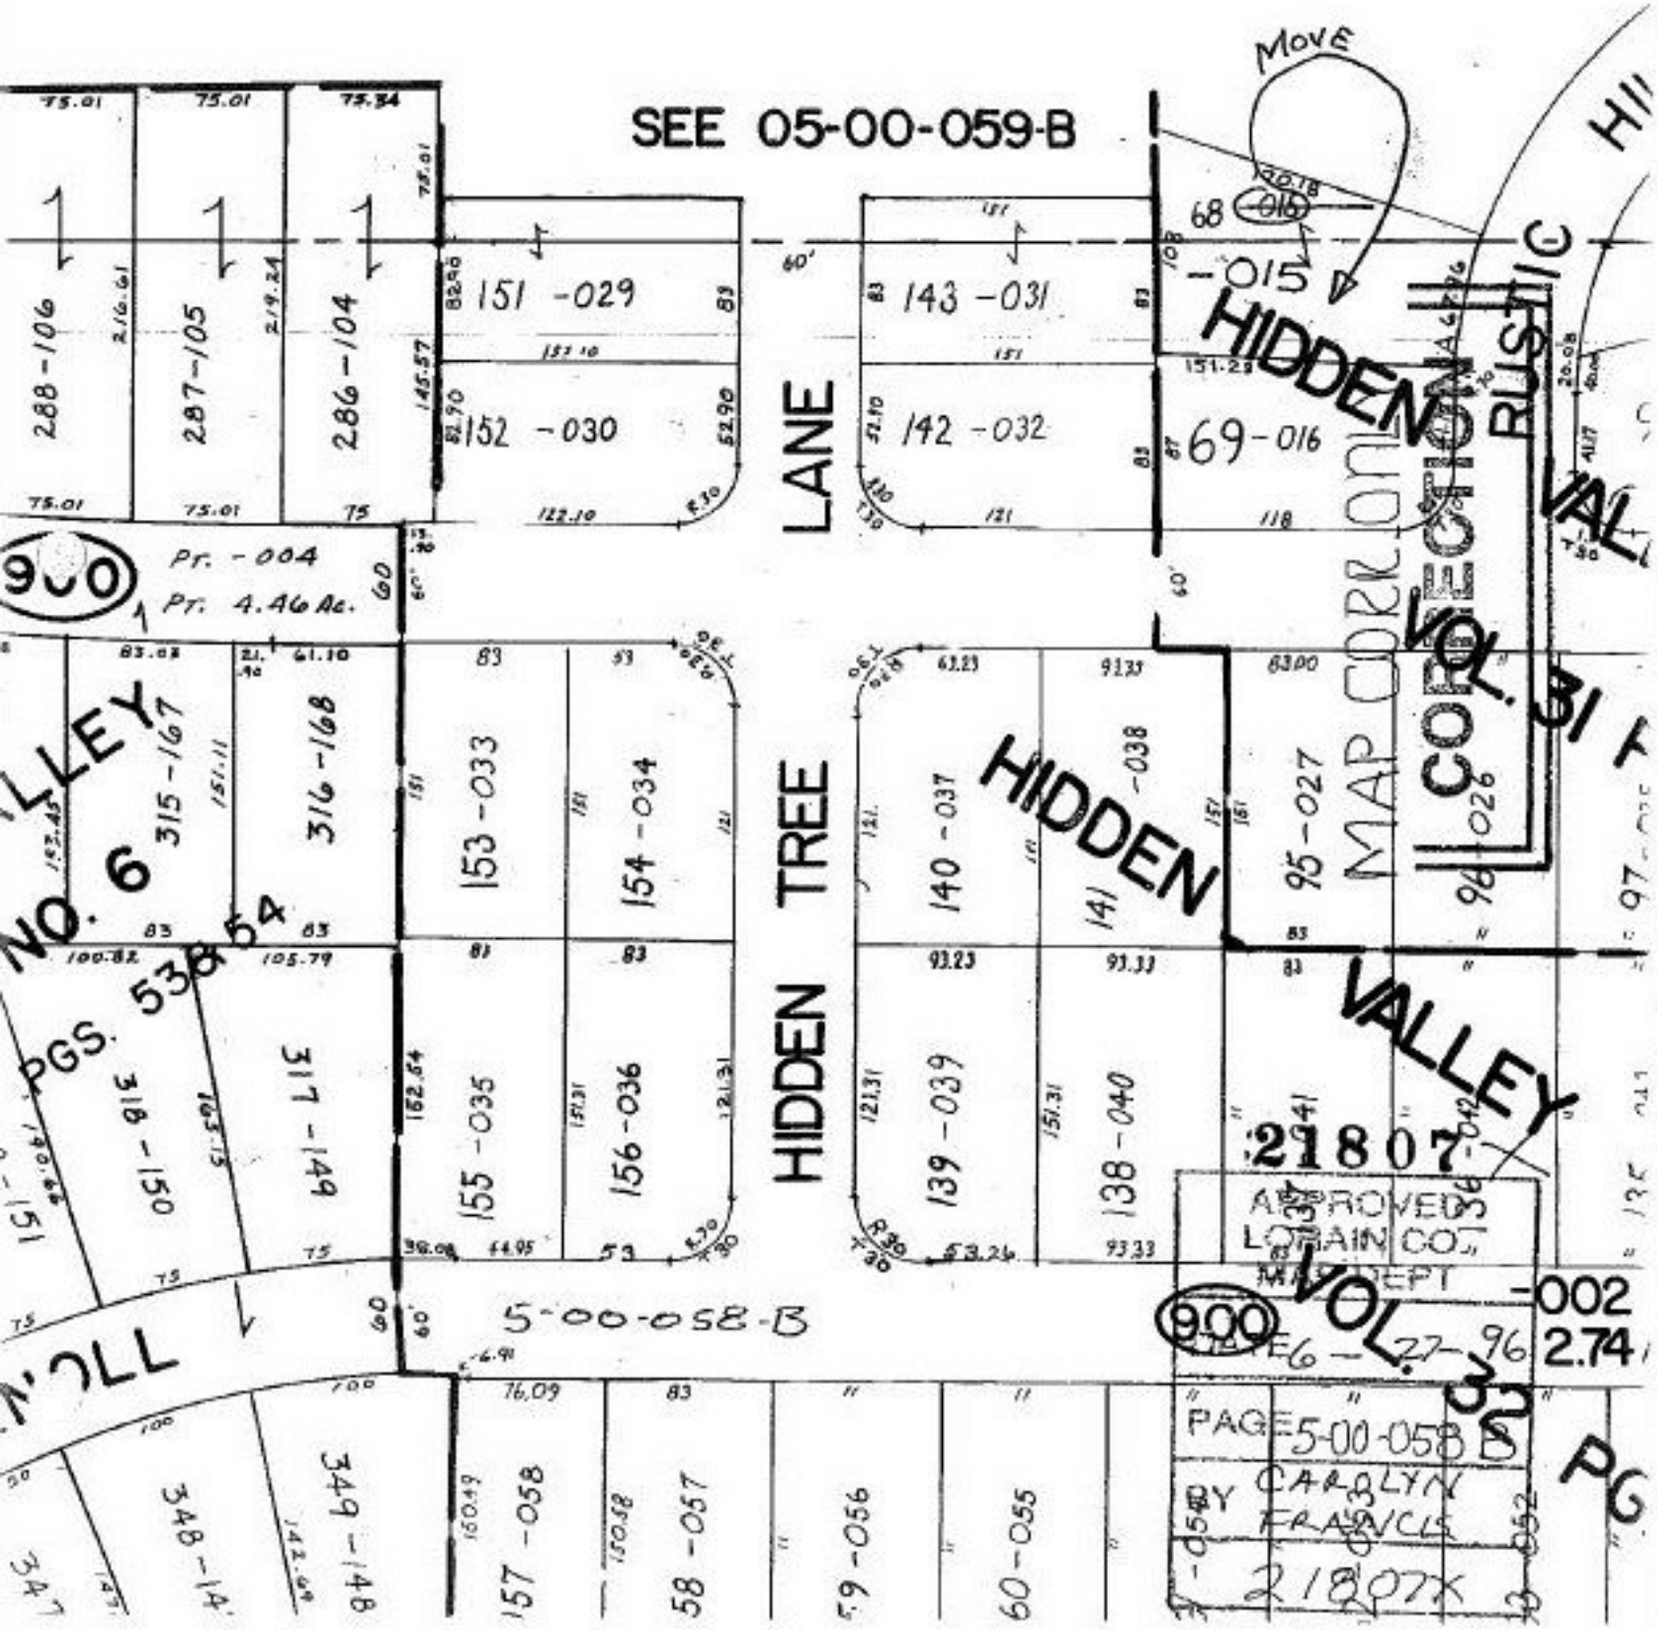

SEE 05-00-059-B
MOVE
HIDDEN VALLEY
HIDDEN TREE LANE
RUSTIC
CORRECTION
MAP CORR ONLY
VOL. 31
VOL. 32
PGS. 538-54
NO. 6
5-00-058-B
21807
APPROVED
LORAIN CO.
MAP DEPT
PAGE 5-00-058 B
BY CAROLYN FRANCIS
21807X