#21809

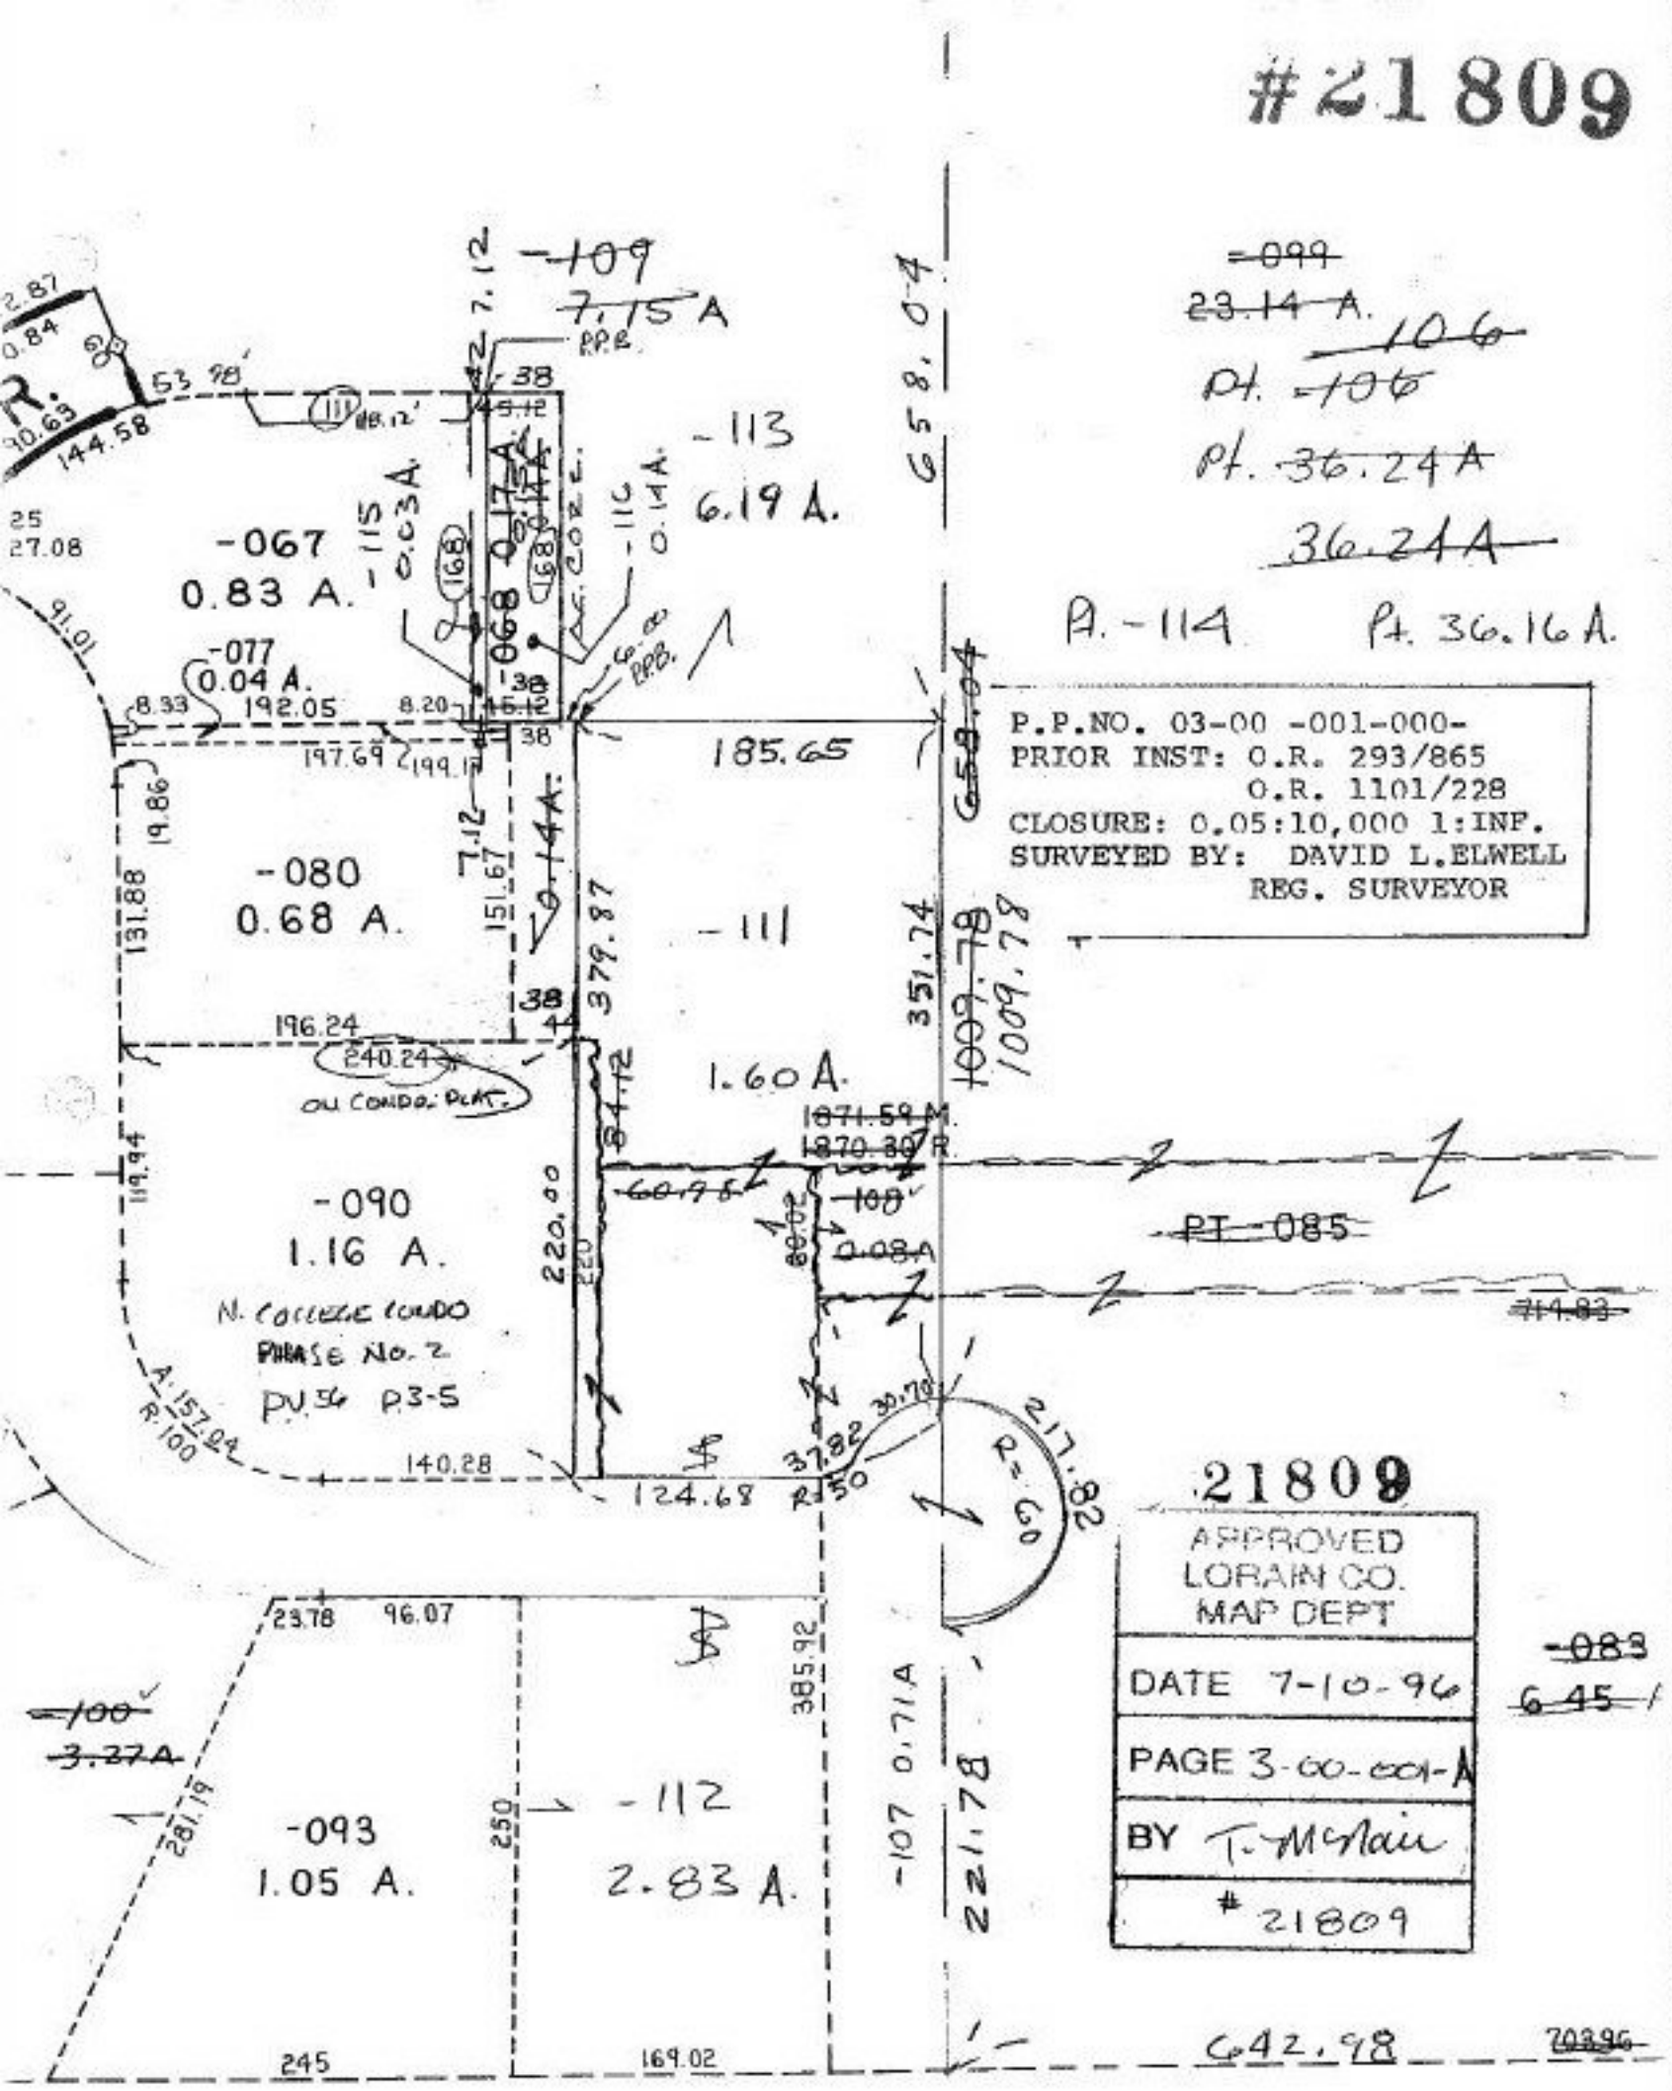
-109
7.15 A
-113
6.19 A.
-067
0.83 A.
-068
-077
0.04 A.
-080
0.68 A.
-111
1.60 A.
-090
1.16 A.
N. COLLEGE CONDO
PHASE NO. 2
PV 56 P3-5
-112
2.83 A.
-093
1.05 A.
-107 0.71A
-115 0.03A.
-116 0.14A.
-083
6.45
-099
23.14 A.
106
Pt. -106
Pt. 36.24 A
36.24A
A. -114
Pt. 36.16 A.
P.P.NO. 03-00 -001-000-
PRIOR INST: O.R. 293/865
O.R. 1101/228
CLOSURE: 0.05:10,000 1:INF.
SURVEYED BY: DAVID L.ELWELL
REG. SURVEYOR
21809
APPROVED
LORAIN CO.
MAP DEPT
DATE 7-10-96
PAGE 3-00-001-A
BY T. McClain
21809