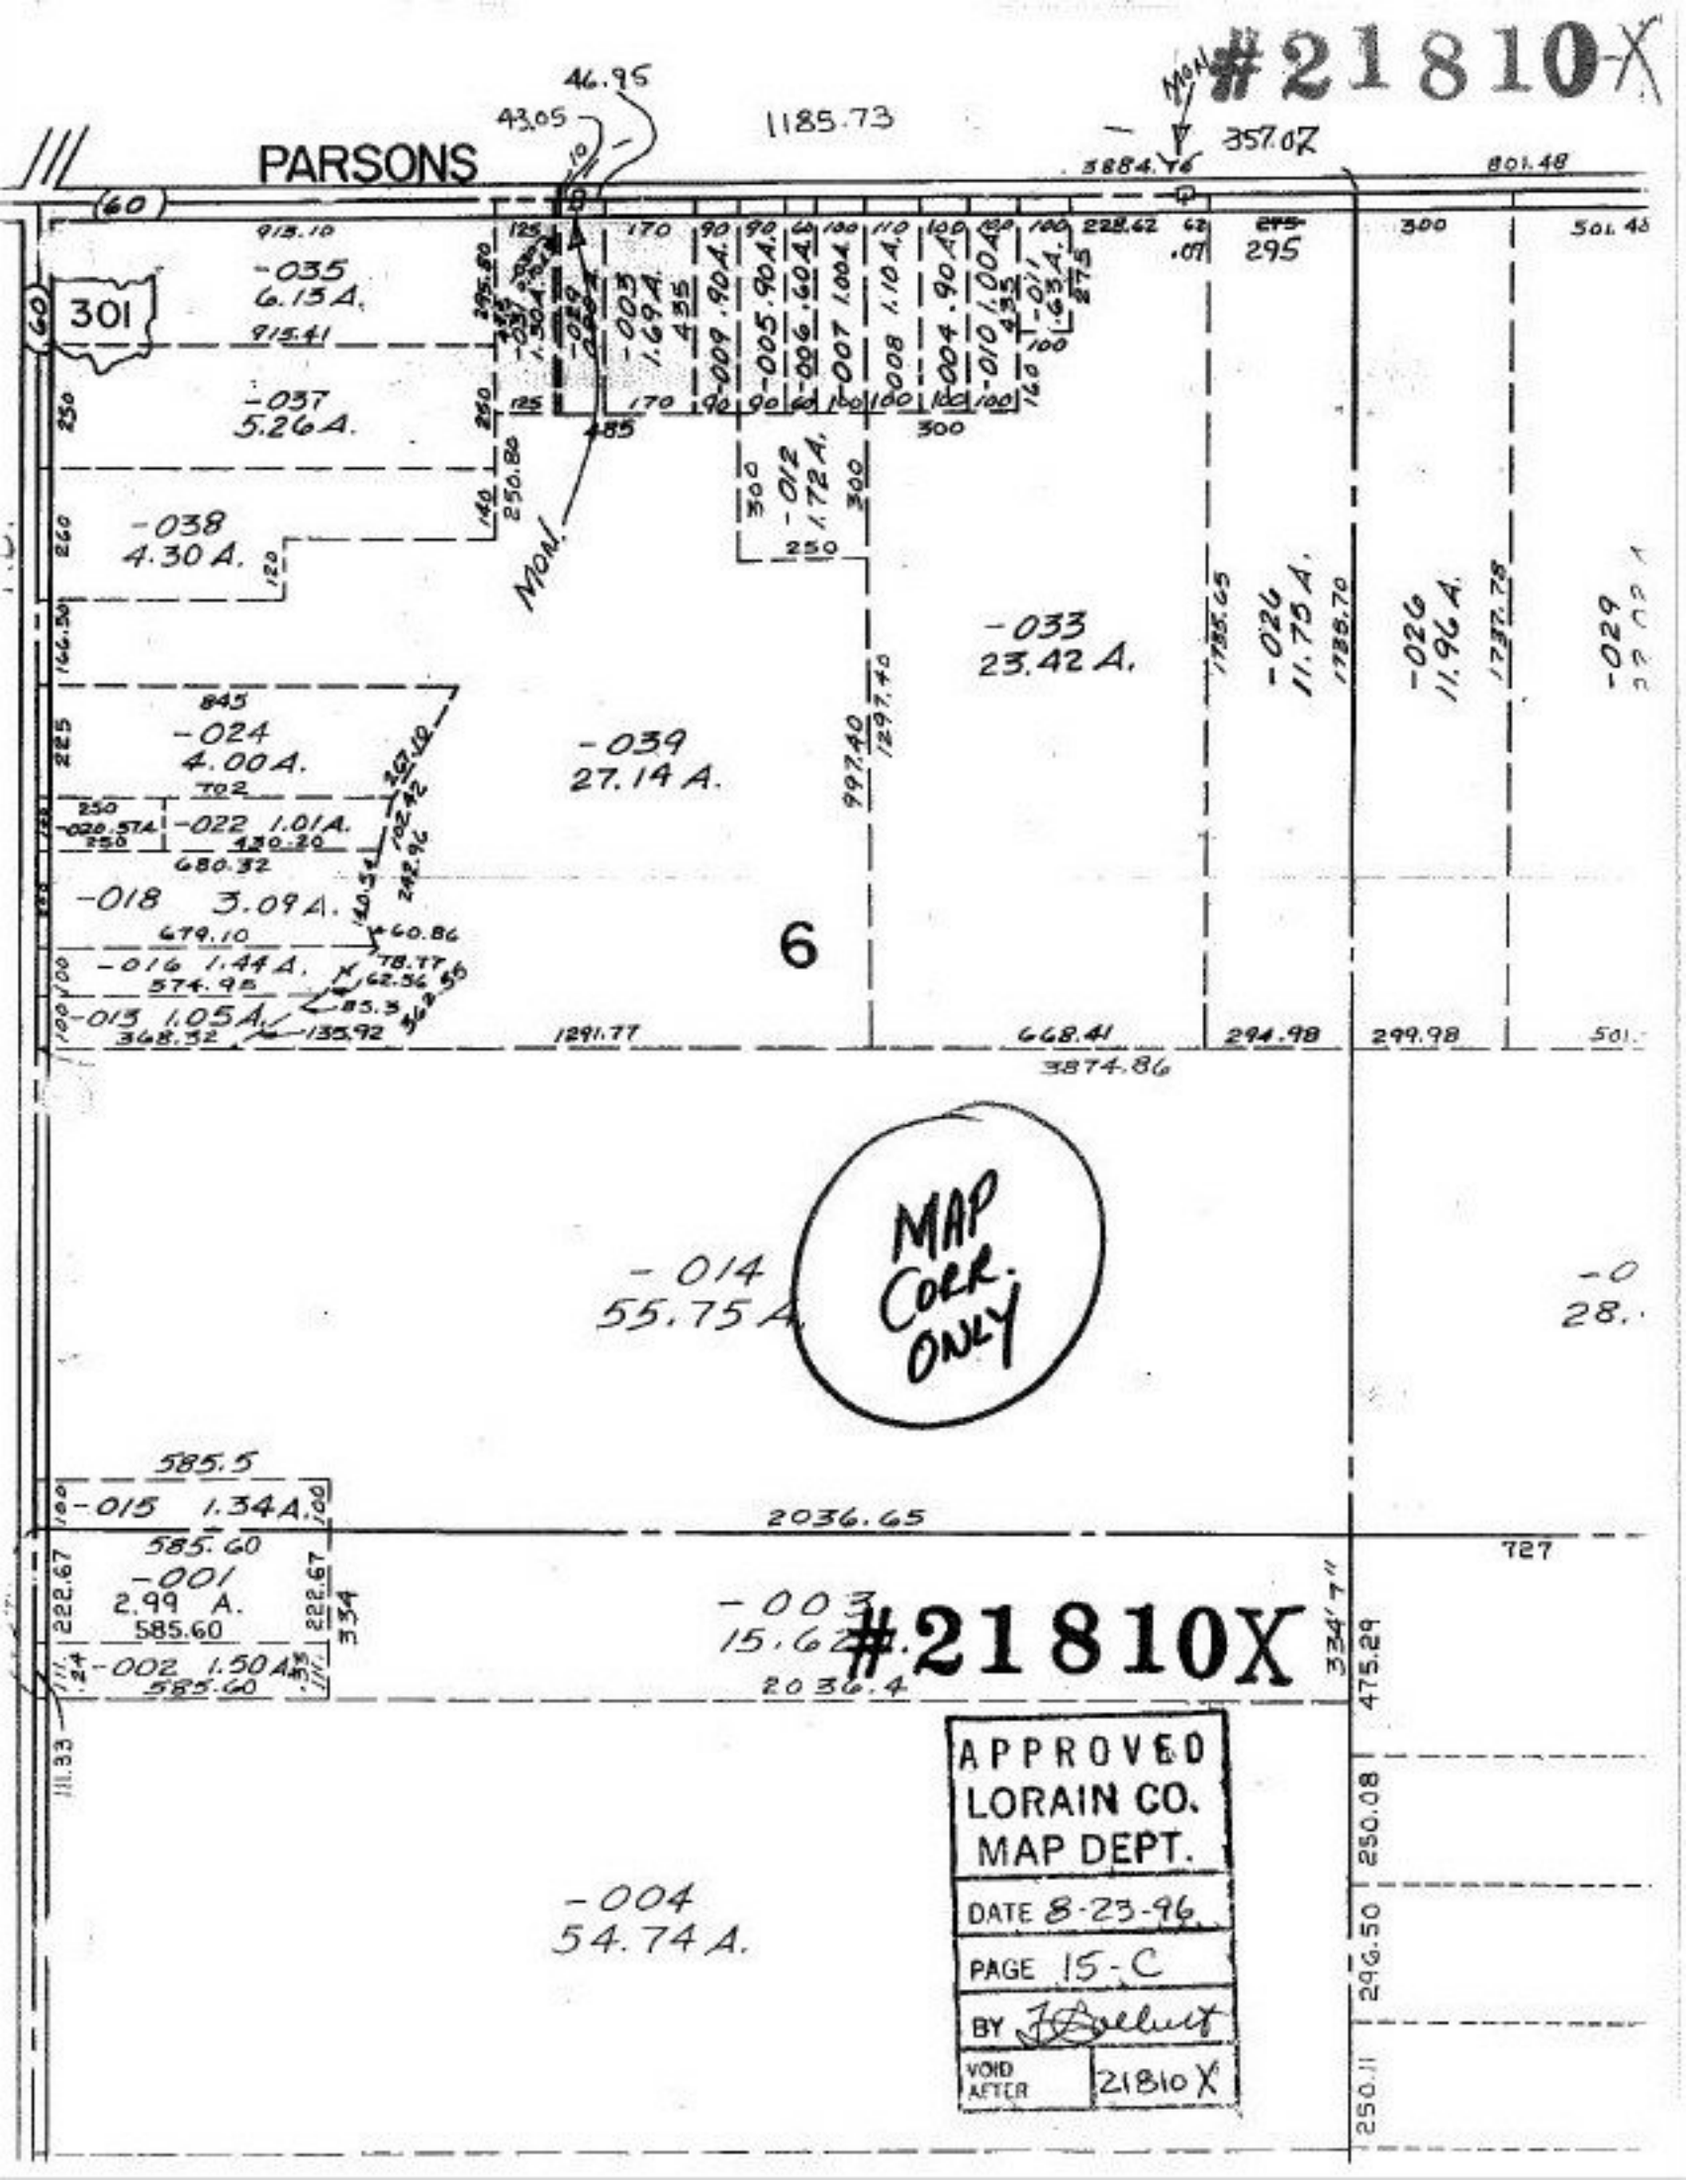
#21810X
PARSONS
46.95
43.05
1185.73
357.07
3884.76
801.48
915.10
915.41
301
-035
6.15A.
-037
5.26A.
-038
4.30A.
-039
27.14A.
-033
23.42A.
-024
4.00A.
-022 1.01A.
-018 3.09A.
-016 1.44A.
-013 1.05A.
-012
1.72A.
-011
1.63A.
-010 1.00A.
-009 .90A.
-008 1.10A.
-007 1.00A.
-006 .60A.
-005 .90A.
-004 .90A.
-003
1.69A.
-026
11.75A.
-026
11.96A.
-029
-014
55.75A
-015 1.34A.
-001
2.99 A.
585.60
-002 1.50A.
585.60
-003
15.62
-004
54.74A.
6
MON.
MAP CORR. ONLY
2036.65
3874.86
1291.77
668.41
294.98
299.98
APPROVED
LORAIN CO.
MAP DEPT.
DATE 8-23-96
PAGE 15-C
BY
VOID AFTER
21810X