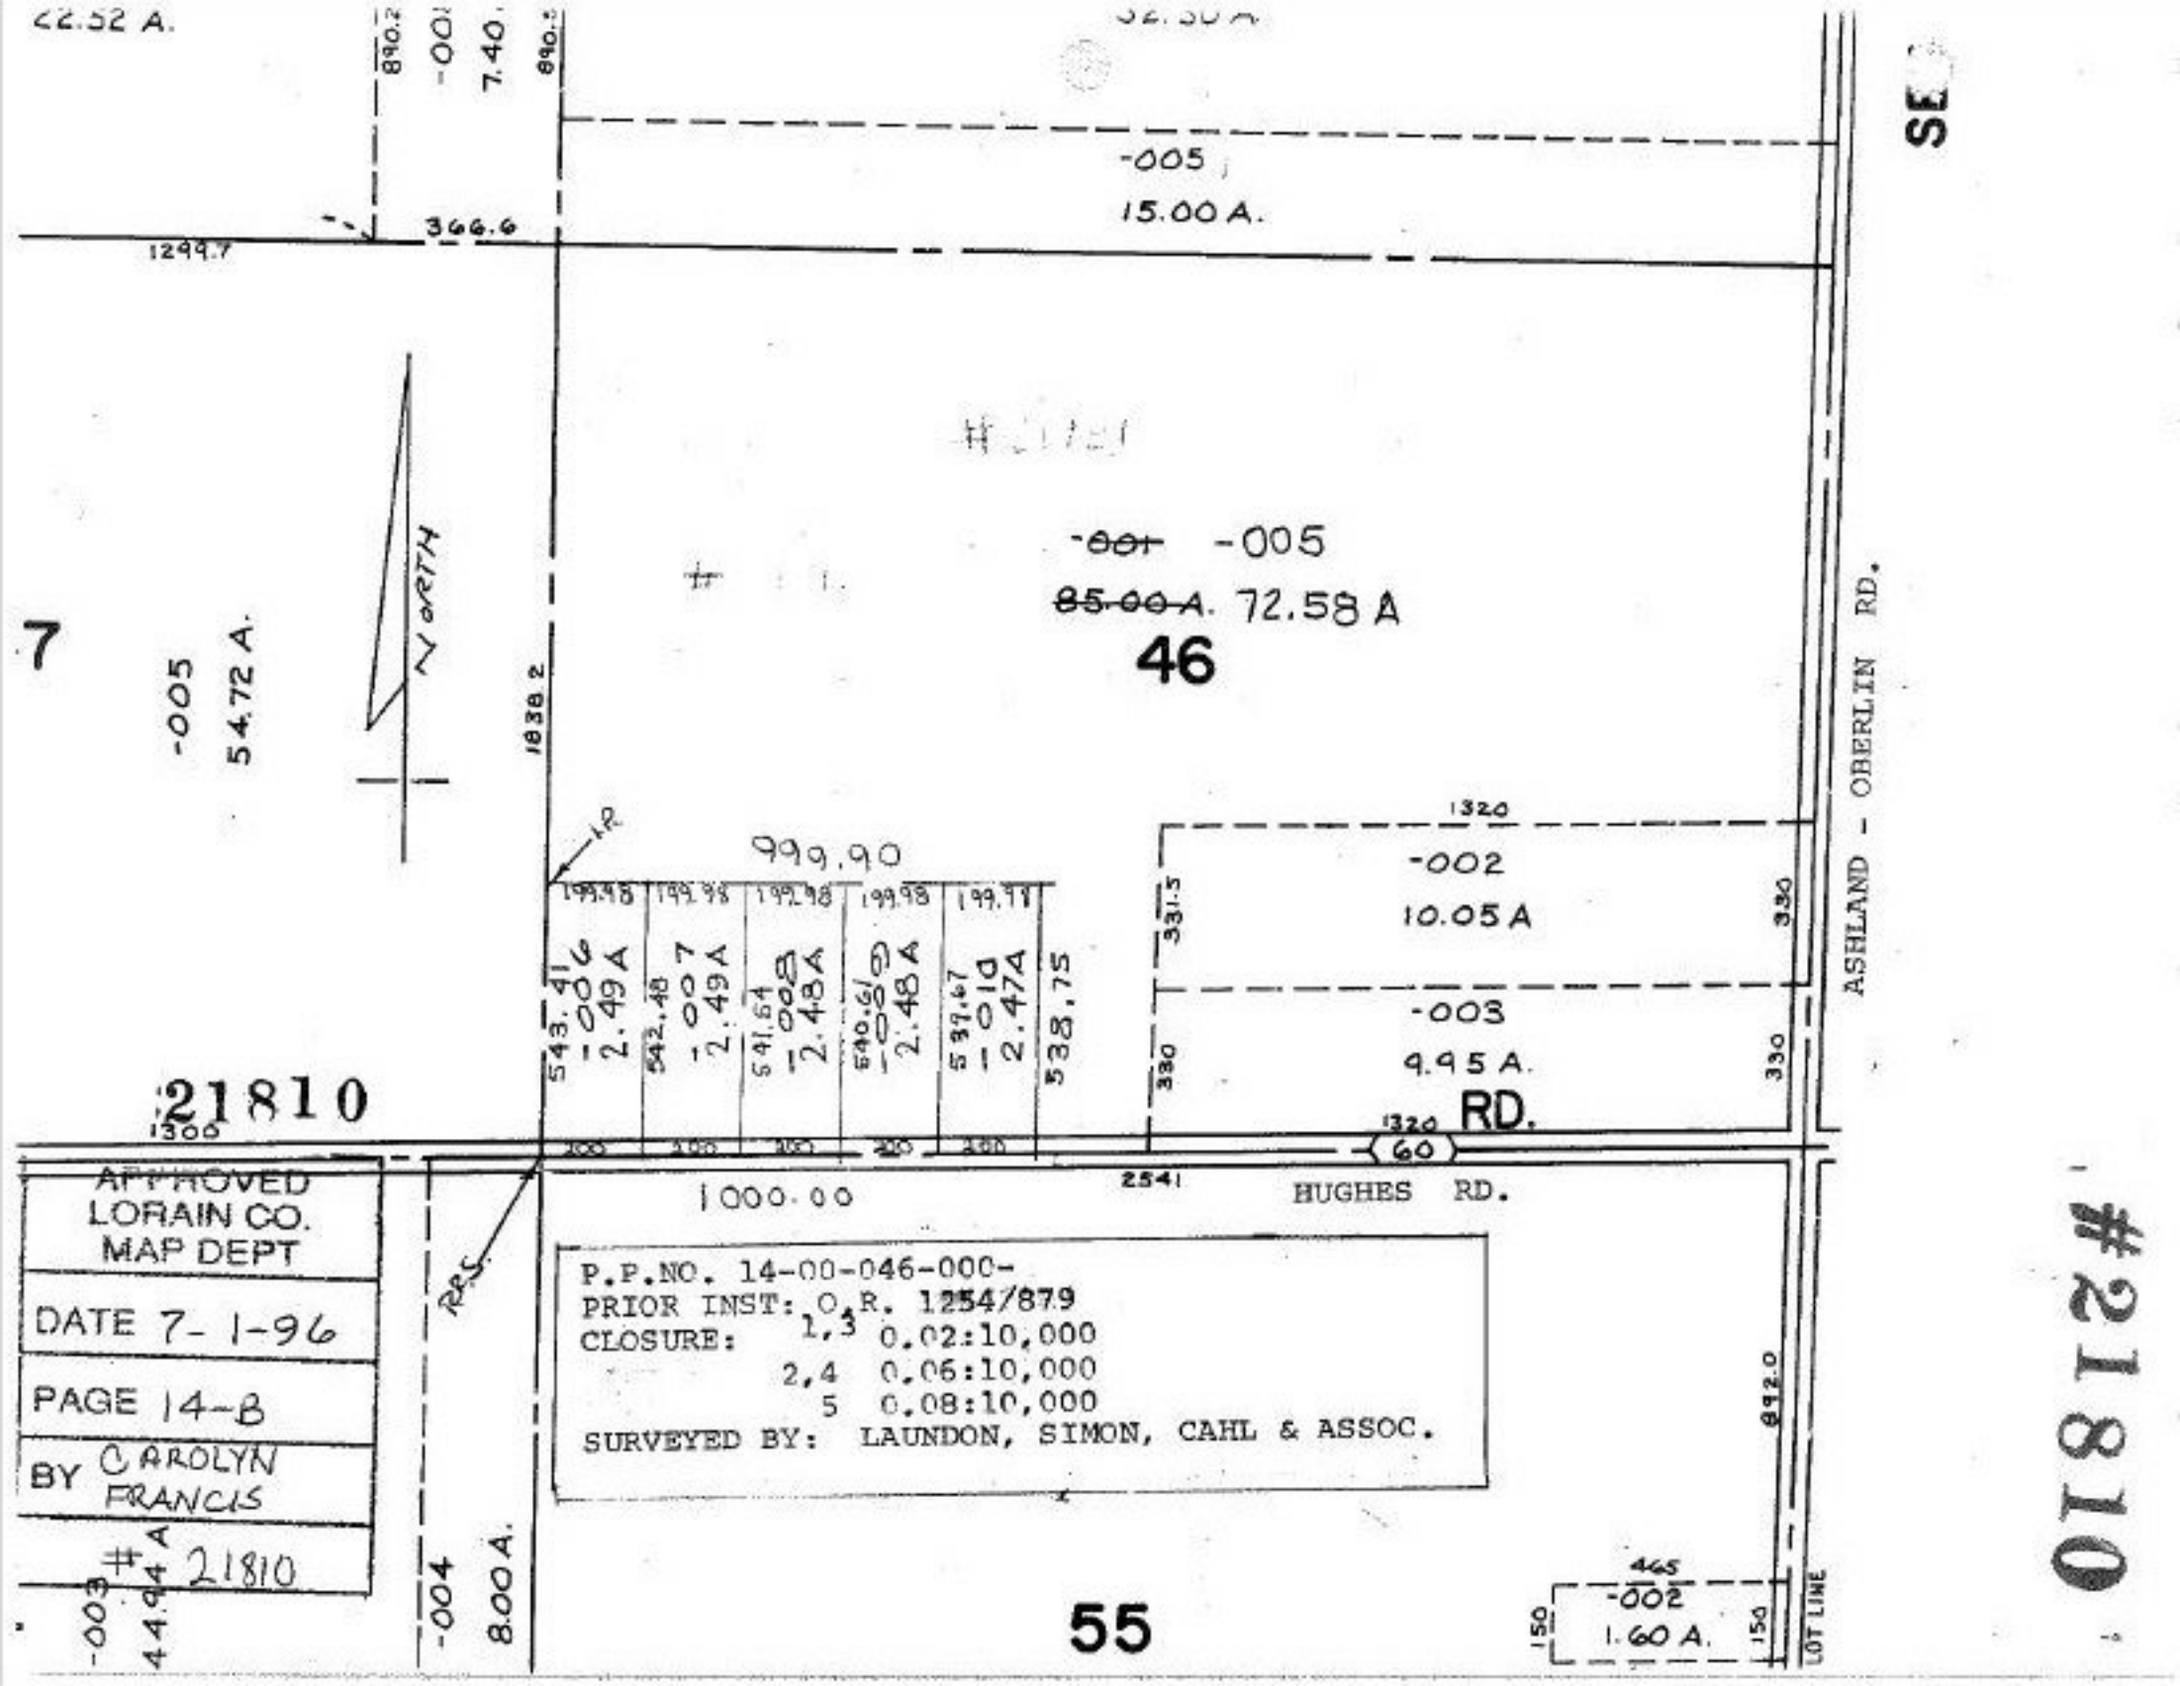
22.52 A.
890.2
-001
7.40
890.2
-005
15.00 A.
366.6
1299.7
-001 -005
85.00A. 72.58 A
46
7
-005
54.72 A.
NORTH
1838.2
1P
999.90
199.98
199.98
199.98
199.98
199.98
543.41
-006
2.49A
542.48
-007
2.49A
541.64
-008
2.48A
540.61
-009
2.48A
539.67
-010
2.47A
538.75
1320
-002
10.05A
331.5
330
330
330
-003
4.95 A.
21810
1300
RD.
1320
60
2541
1000.00
HUGHES RD.
ASHLAND - OBERLIN RD.
892.0
LOT LINE
APPROVED
LORAIN CO.
MAP DEPT
DATE 7-1-96
PAGE 14-B
BY CAROLYN FRANCIS
# 21810
P.P.NO. 14-00-046-000-
PRIOR INST: O.R. 1254/879
CLOSURE: 1,3 0.02:10,000
2,4 0.06:10,000
5 0.08:10,000
SURVEYED BY: LAUNDON, SIMON, CAHL & ASSOC.
-003
44.94 A
-004
8.00 A.
55
465
-002
1.60 A.
150
150
21810
#