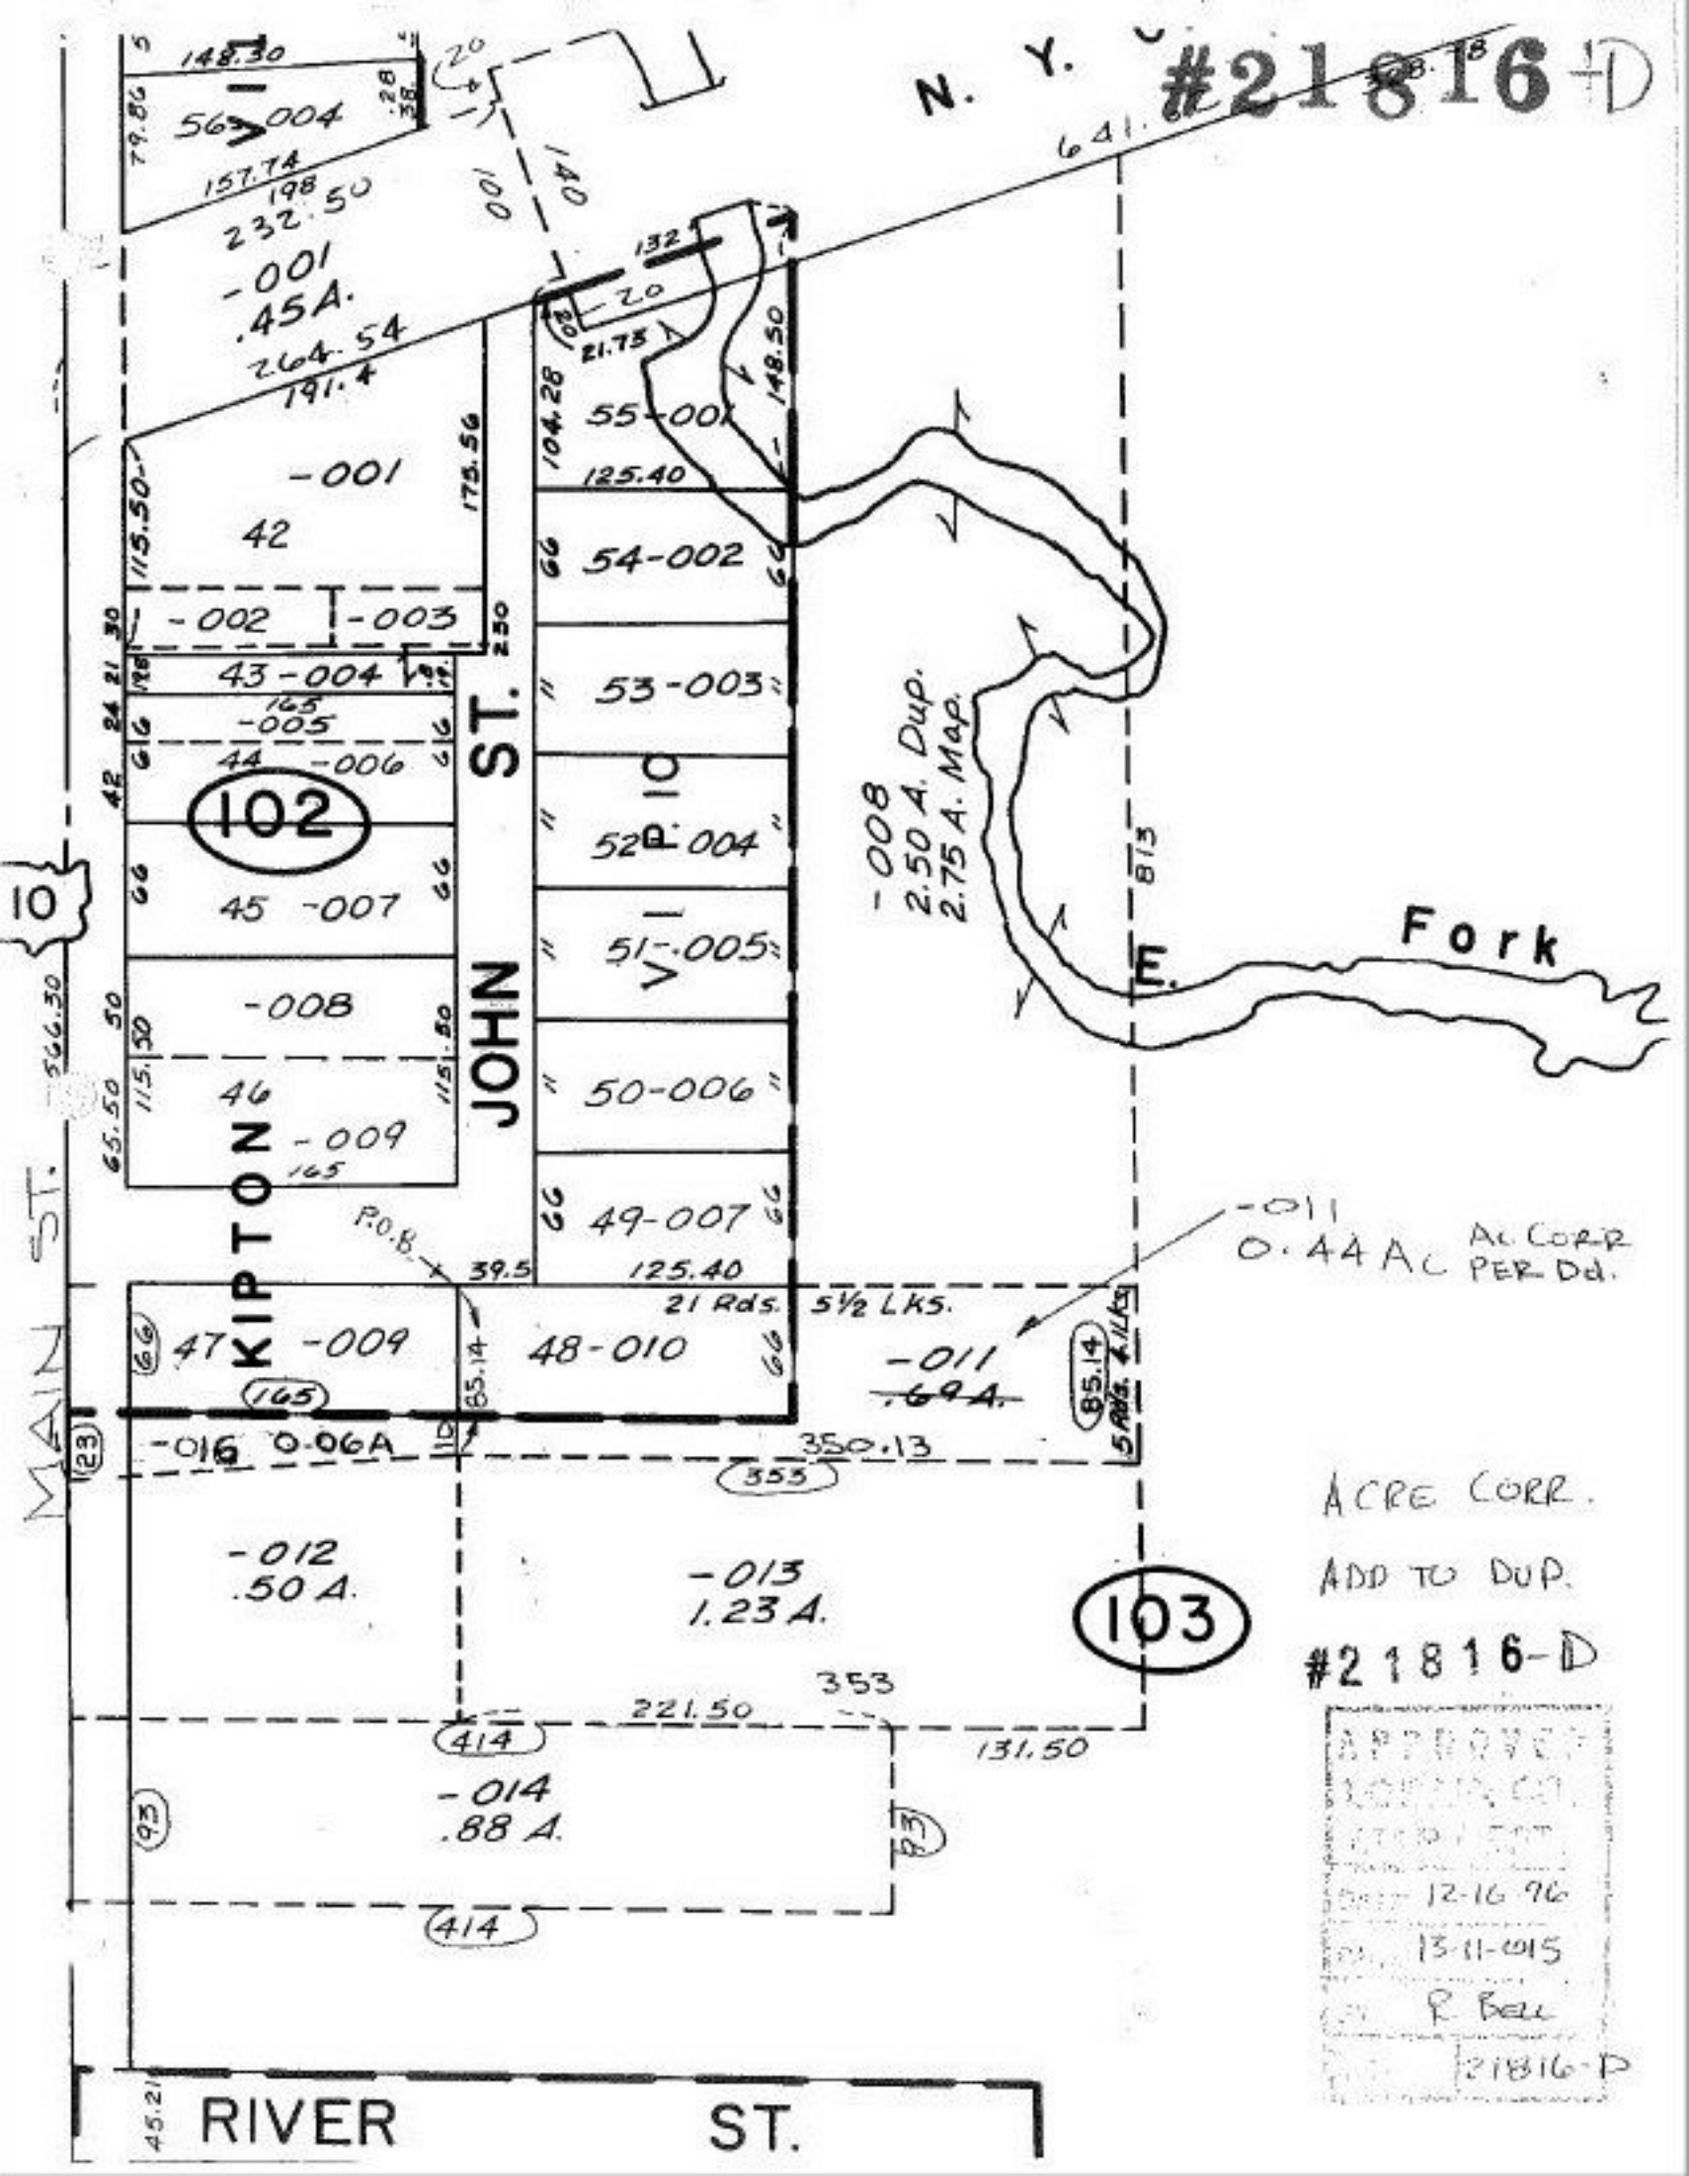
#21816-D
N. Y.
148.30
56-004
157.74
232.50
-001
.45A.
264.54
191.4
-001
42
-002
-003
43-004
-005
44 -006
102
45 -007
-008
46
-009
KIPTON
JOHN ST.
55-001
125.40
54-002
53-003
52-004
51-005
50-006
49-007
125.40
21 Rds. 5½ Lks.
47 -009
48-010
-011
.69 A.
-011
0.44 Ac
Ac CORR PER Dd.
-008
2.50 A. Dup.
2.75 A. Map.
E. Fork
-016 0.06A
350.13
-012
.50 A.
-013
1.23 A.
103
221.50
131.50
-014
.88 A.
MAIN ST.
RIVER ST.
ACRE CORR.
ADD TO DUP.
#21816-D
APPROVED
12-16-96
13-11-015
R. Bell
21816-D