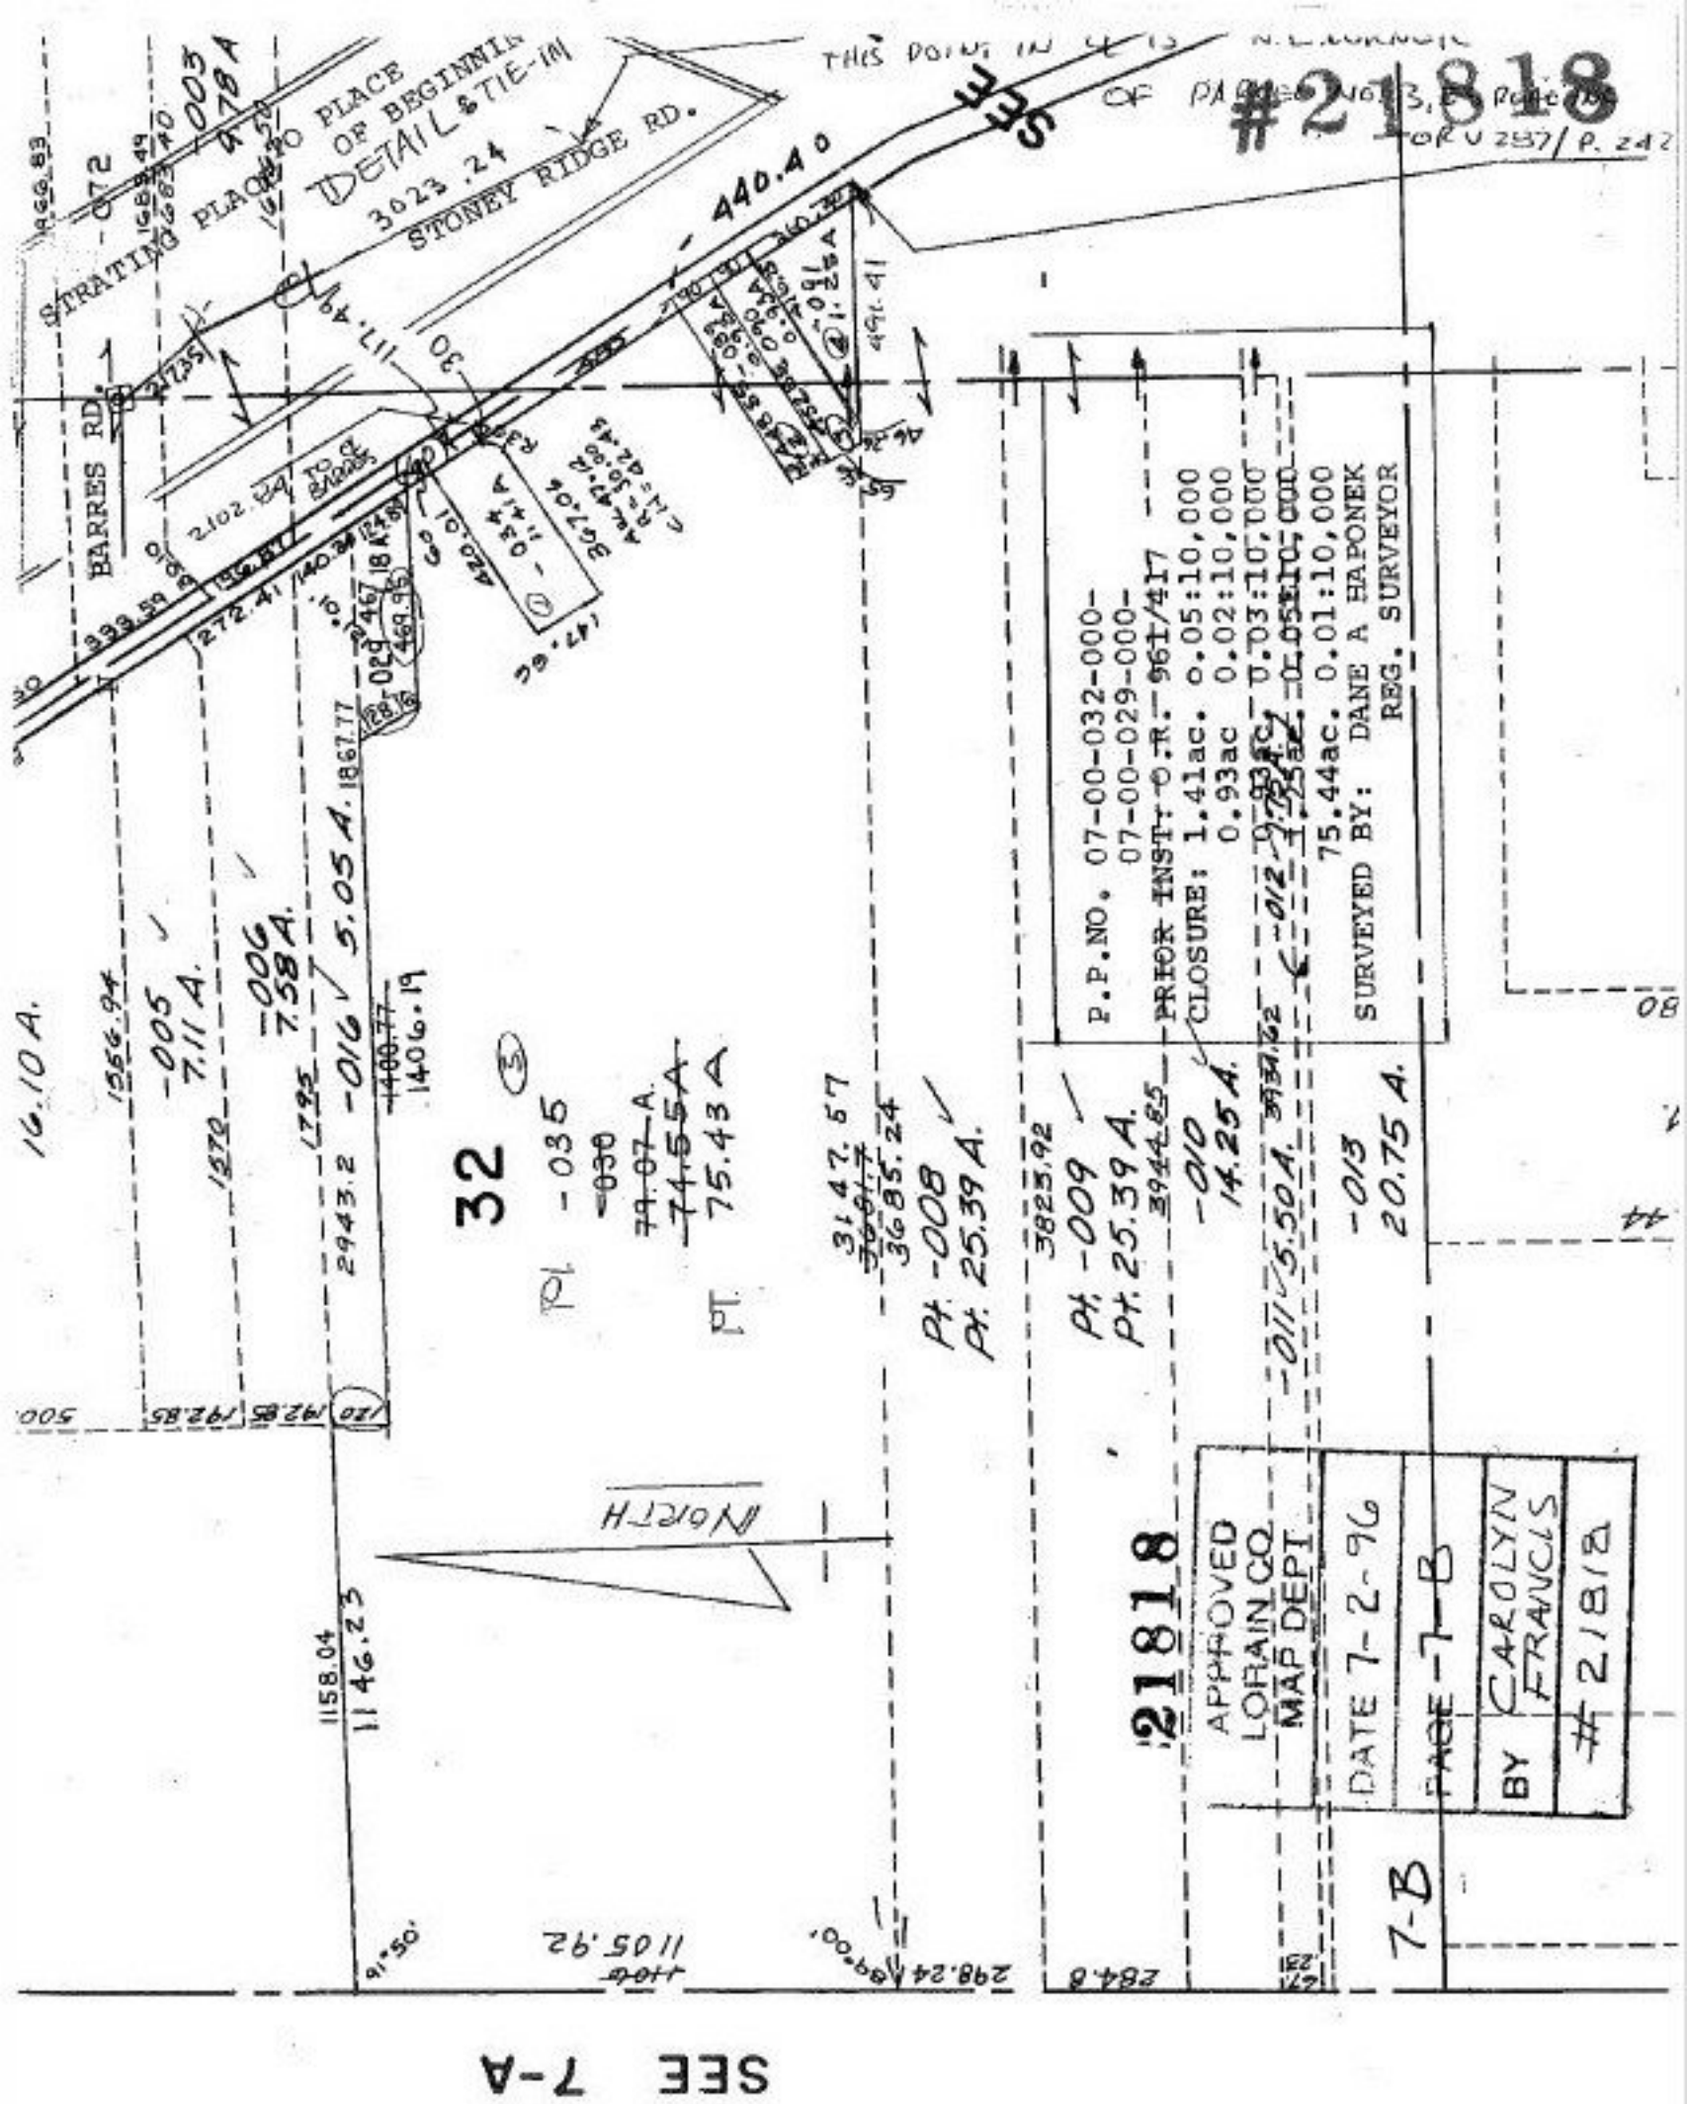
#21818
STRATING PLACE TO PLACE OF BEGINNING
DETAIL & TIE-IN
3023.24
STONEY RIDGE RD.
BARRES RD.
440.40
P.P.NO. 07-00-032-000-
07-00-029-000-
PRIOR INST: O.R. 961/417
CLOSURE: 1.41ac. 0.05:10,000
0.93ac 0.02:10,000
0.93ac 0.03:10,000
1.25ac 0.05:10,000
75.44ac. 0.01:10,000
SURVEYED BY: DANE A HAPONEK
REG. SURVEYOR
32
Pt. -035
Pt. 75.43 A
Pt. -008
Pt. 25.39 A.
Pt. -009
Pt. 25.39 A.
-010
14.25 A.
-011
5.50 A.
-013
20.75 A.
-005
7.11 A.
-006
7.58 A.
-016
5.05 A.
16.10 A.
NORTH
21818
APPROVED
LORAIN CO.
MAP DEPT.
DATE 7-2-96
PAGE 7-B
BY CAROLYN FRANCIS
#21818
7-B
SEE 7-A