#21820

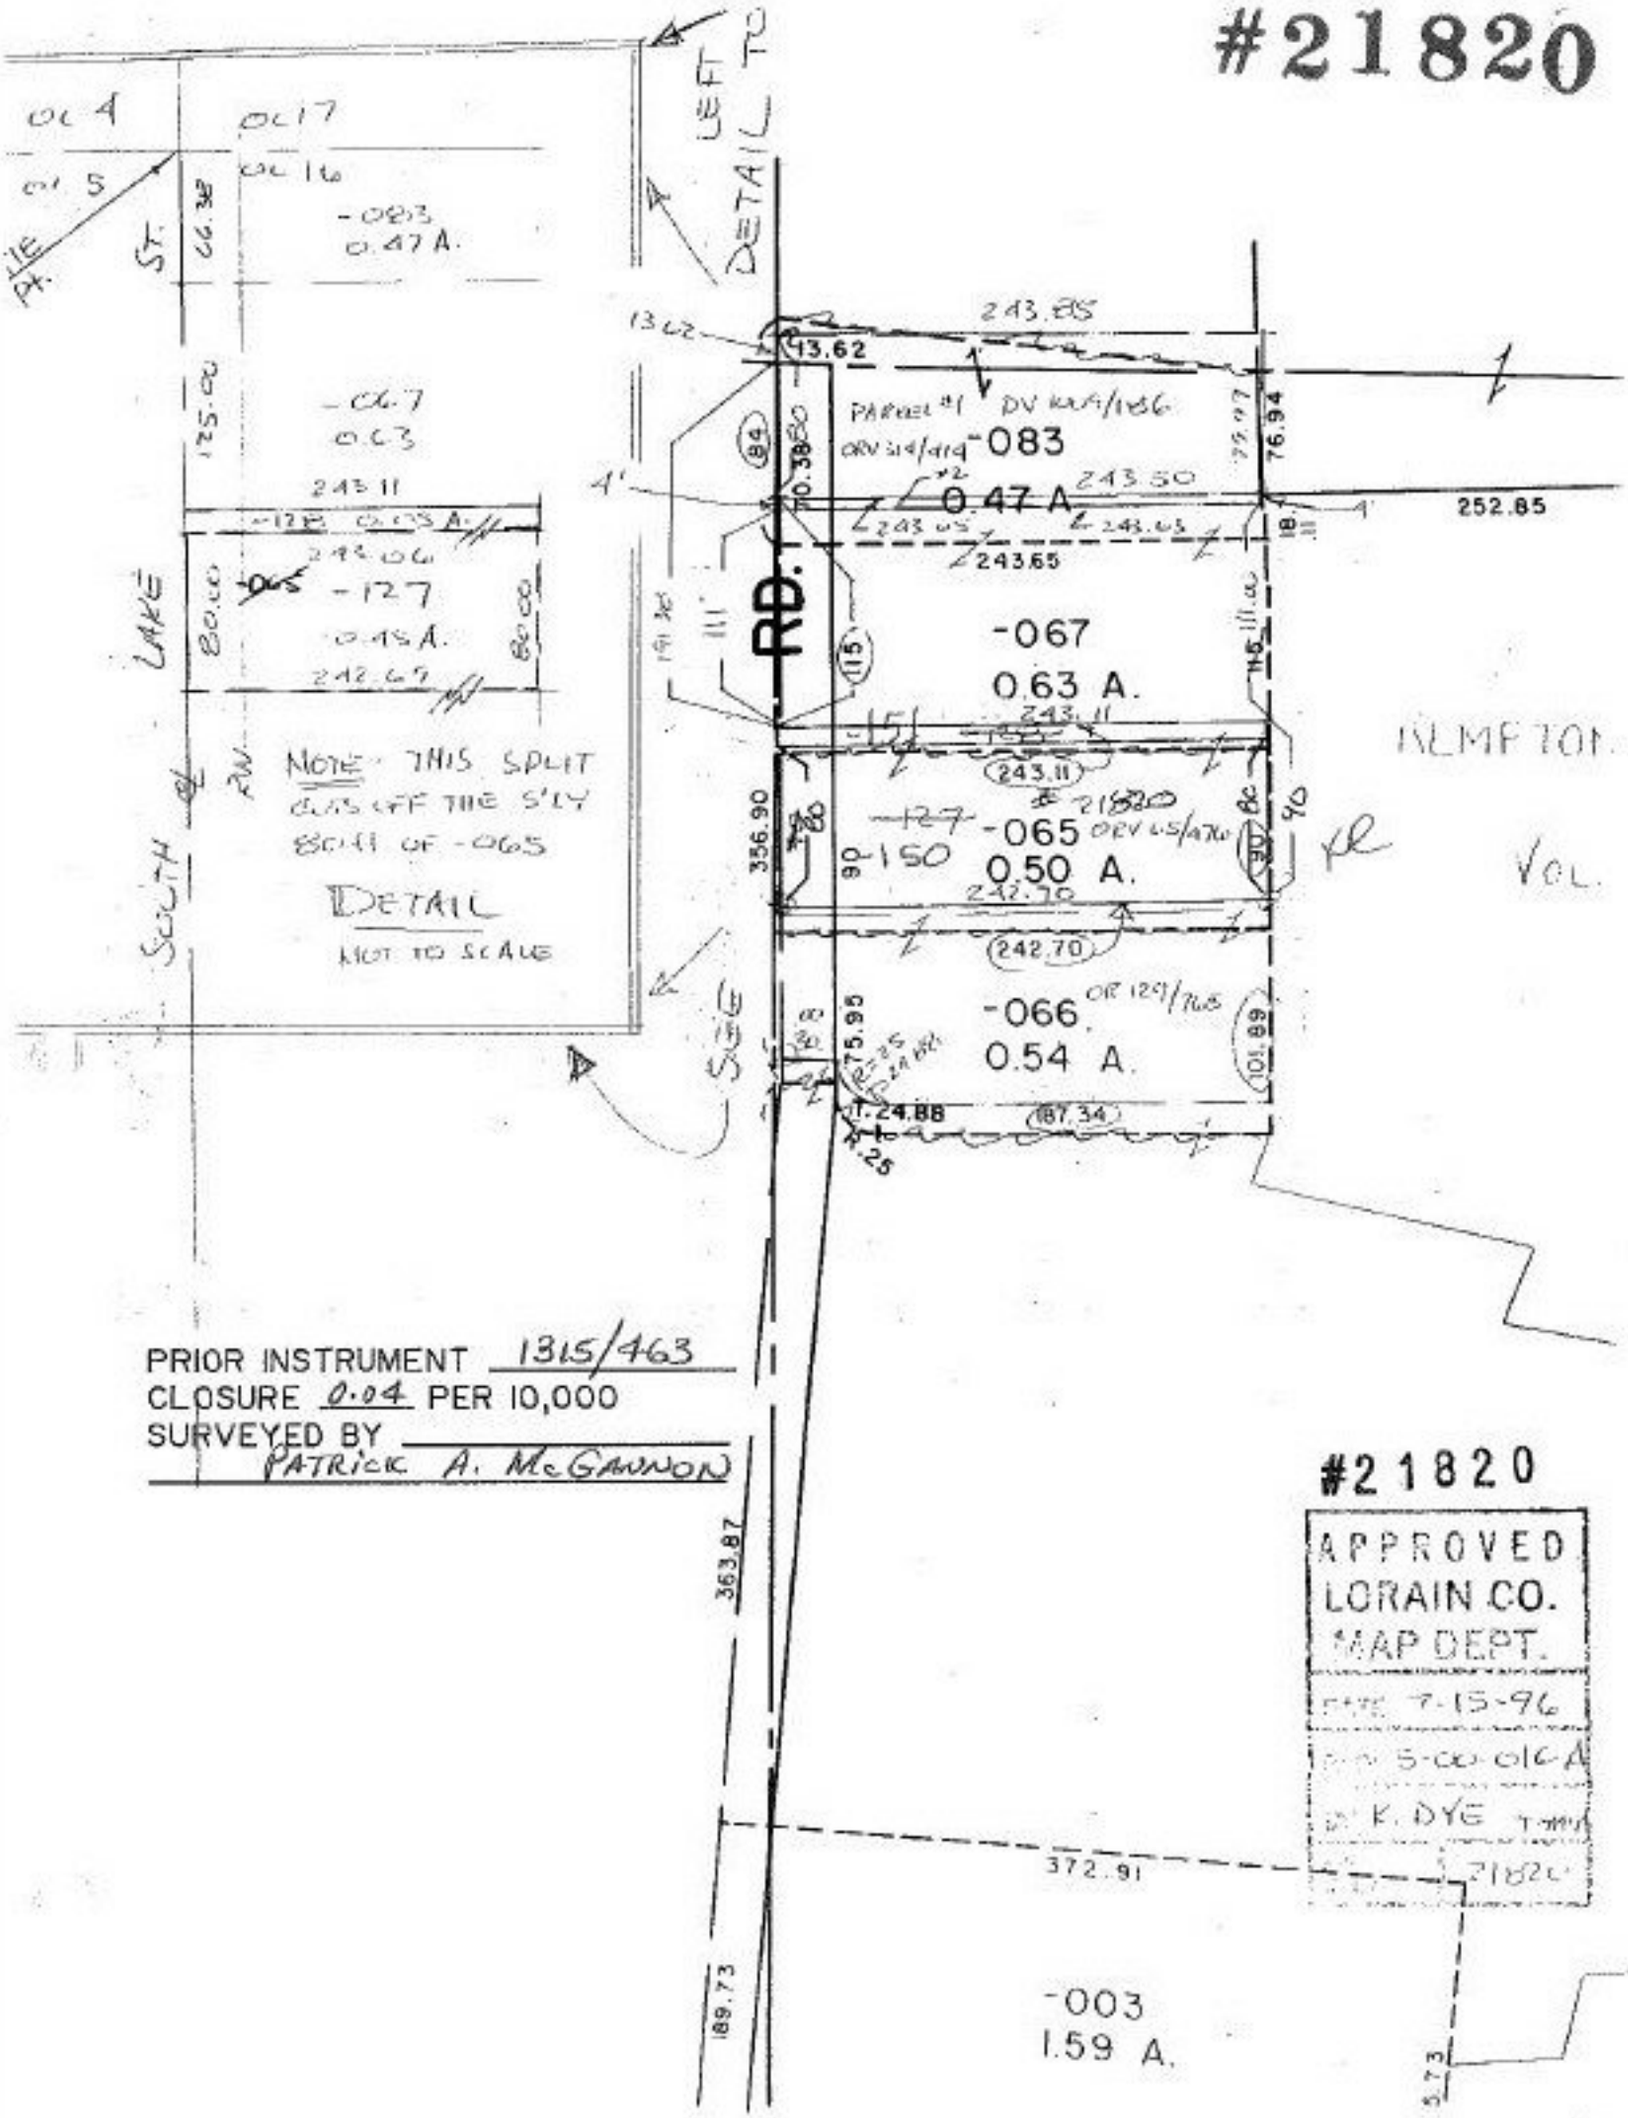

PRIOR INSTRUMENT 1315/463
CLOSURE 0.04 PER 10,000
SURVEYED BY PATRICK A. McGANNON