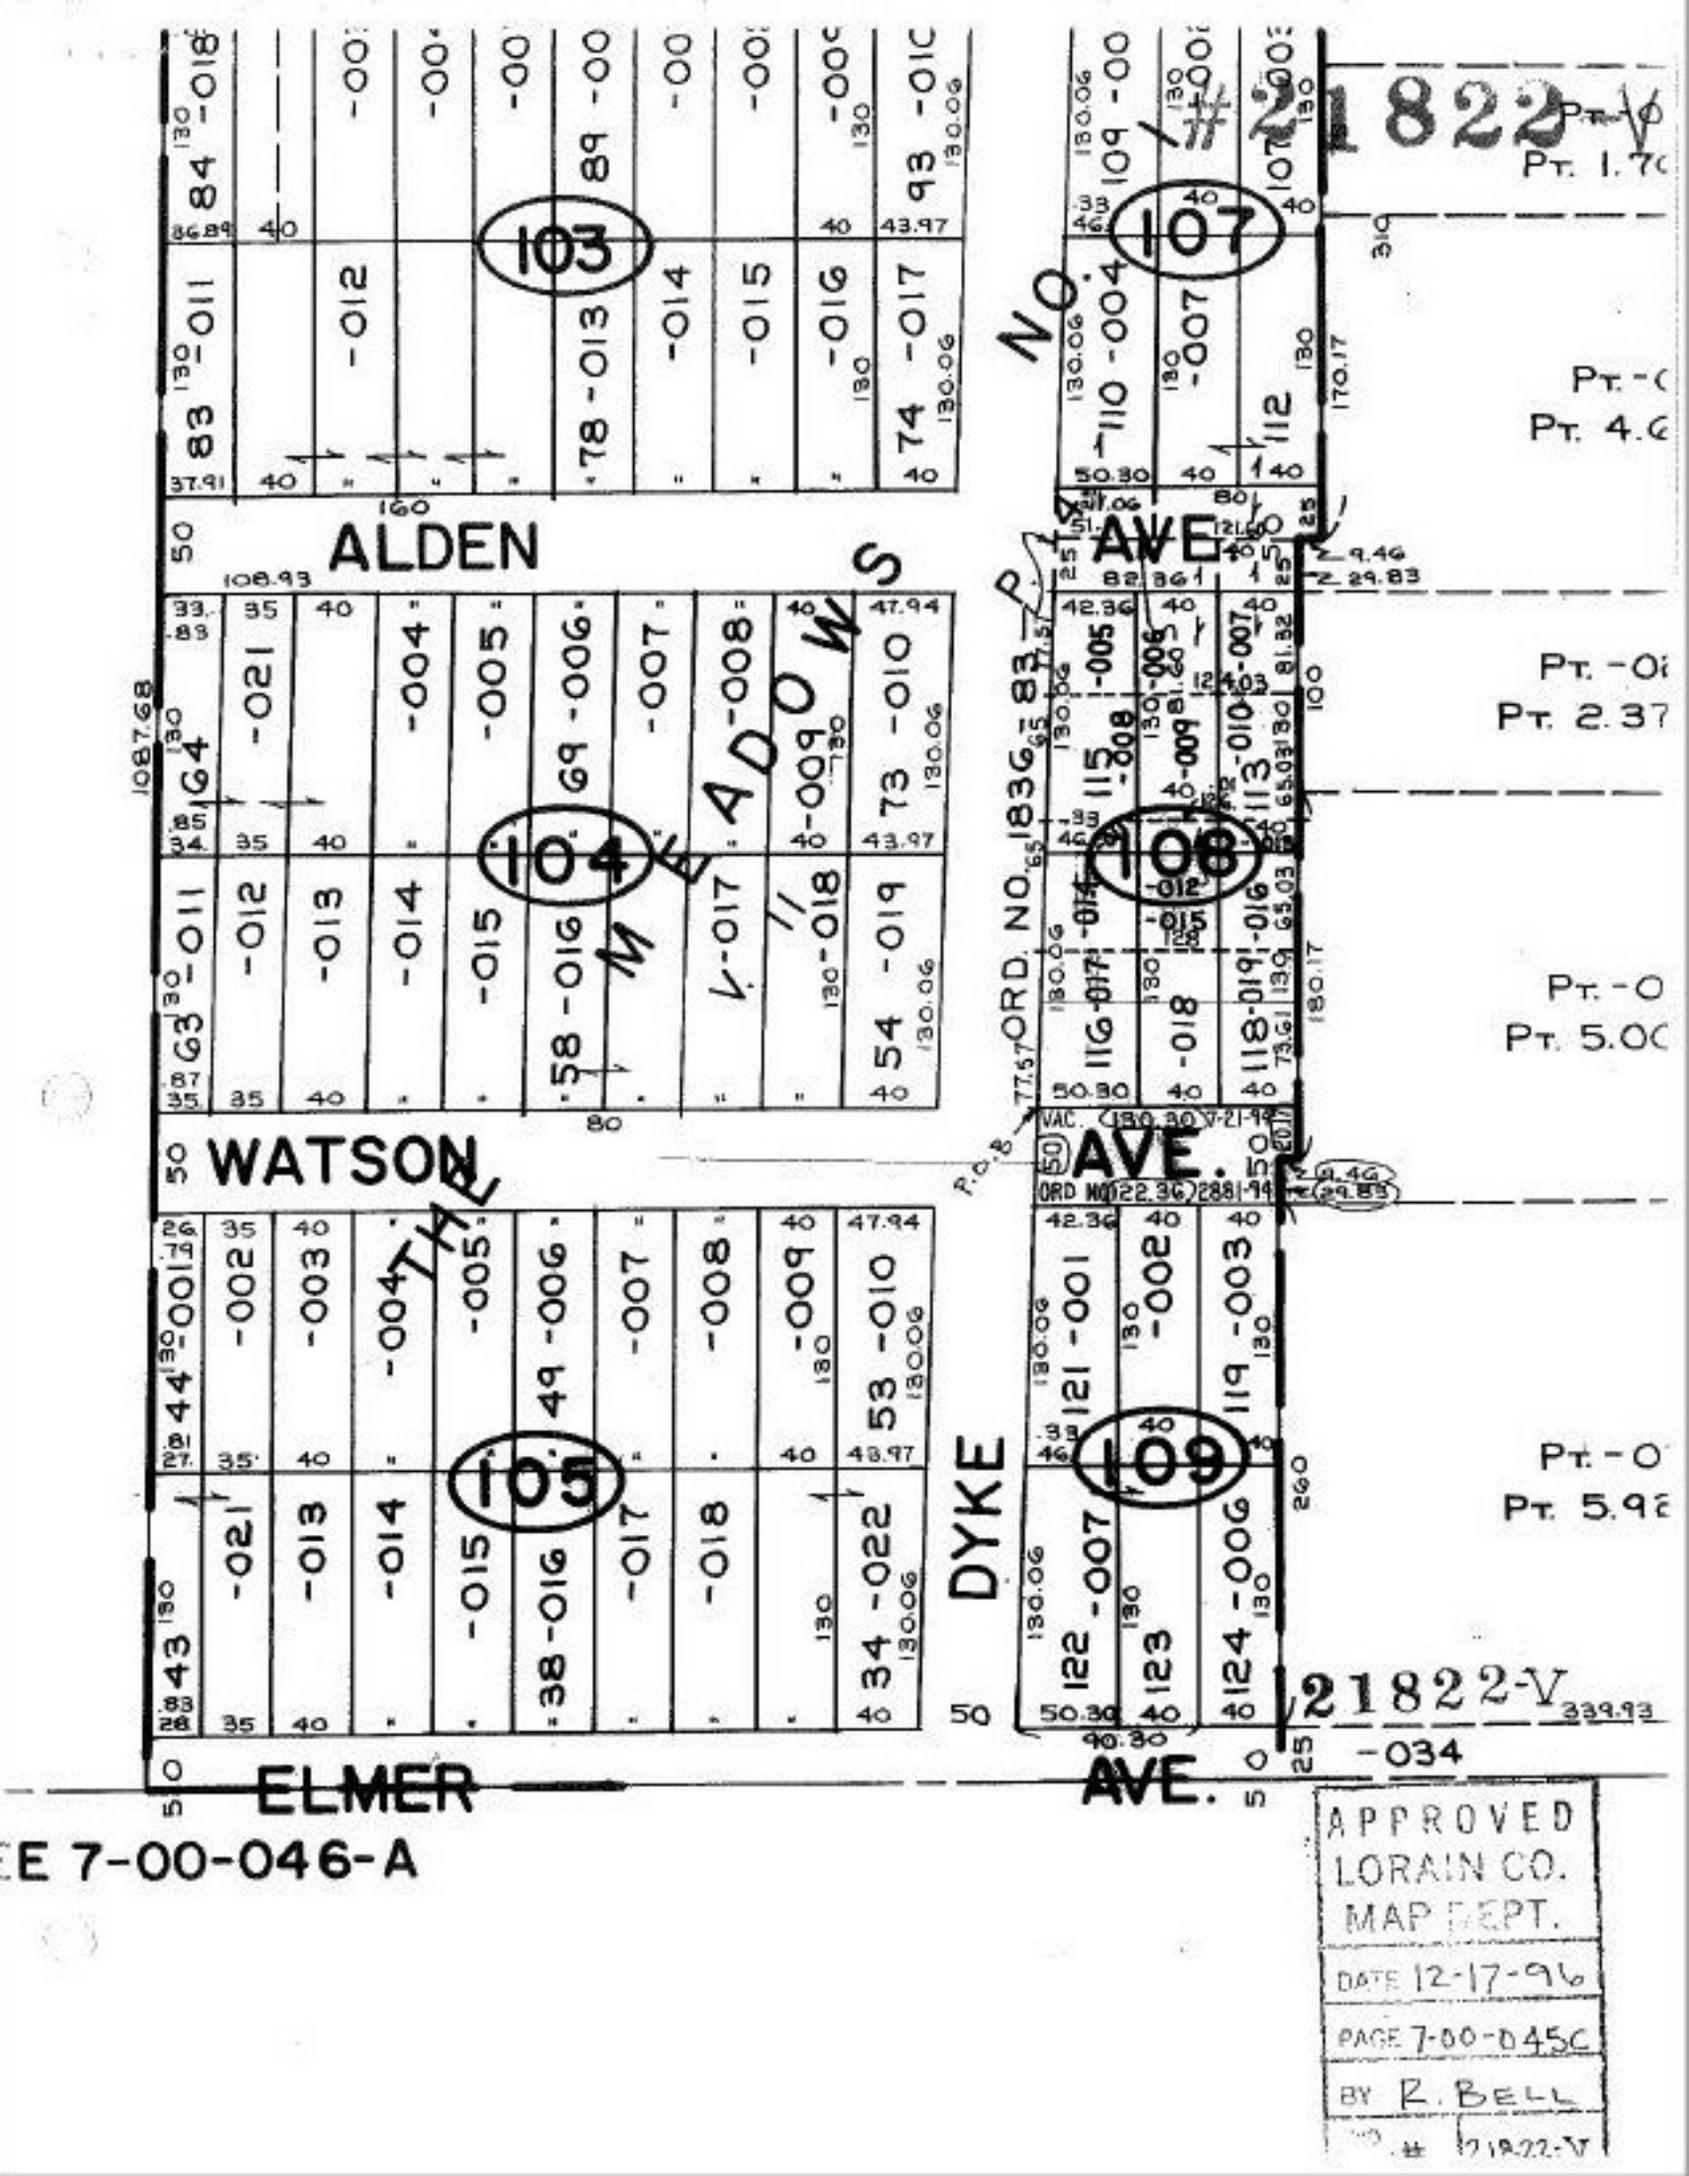
ALDEN
AVE
WATSON
AVE.
ELMER
AVE.
DYKE
MEADOWS
ORD. NO. 1836-83
ORD NO 122.36 288-94
103
104
105
107
108
109
#21822
21822-V
339.93
-034
Pt. 1.70
Pt. 4.6
Pt. 2.37
Pt. 5.00
Pt. 5.92
P.O.B.
77.57
VAC. 130.30 V-21-94
APPROVED
LORAIN CO.
MAP DEPT.
DATE 12-17-96
PAGE 7-00-045C
BY R. BELL
21822-V

E 7-00-046-A