LAND INSTALLMENT CONTRACT

#21824 D

DEED CHECK

NO CHANGES OF TAX MAP

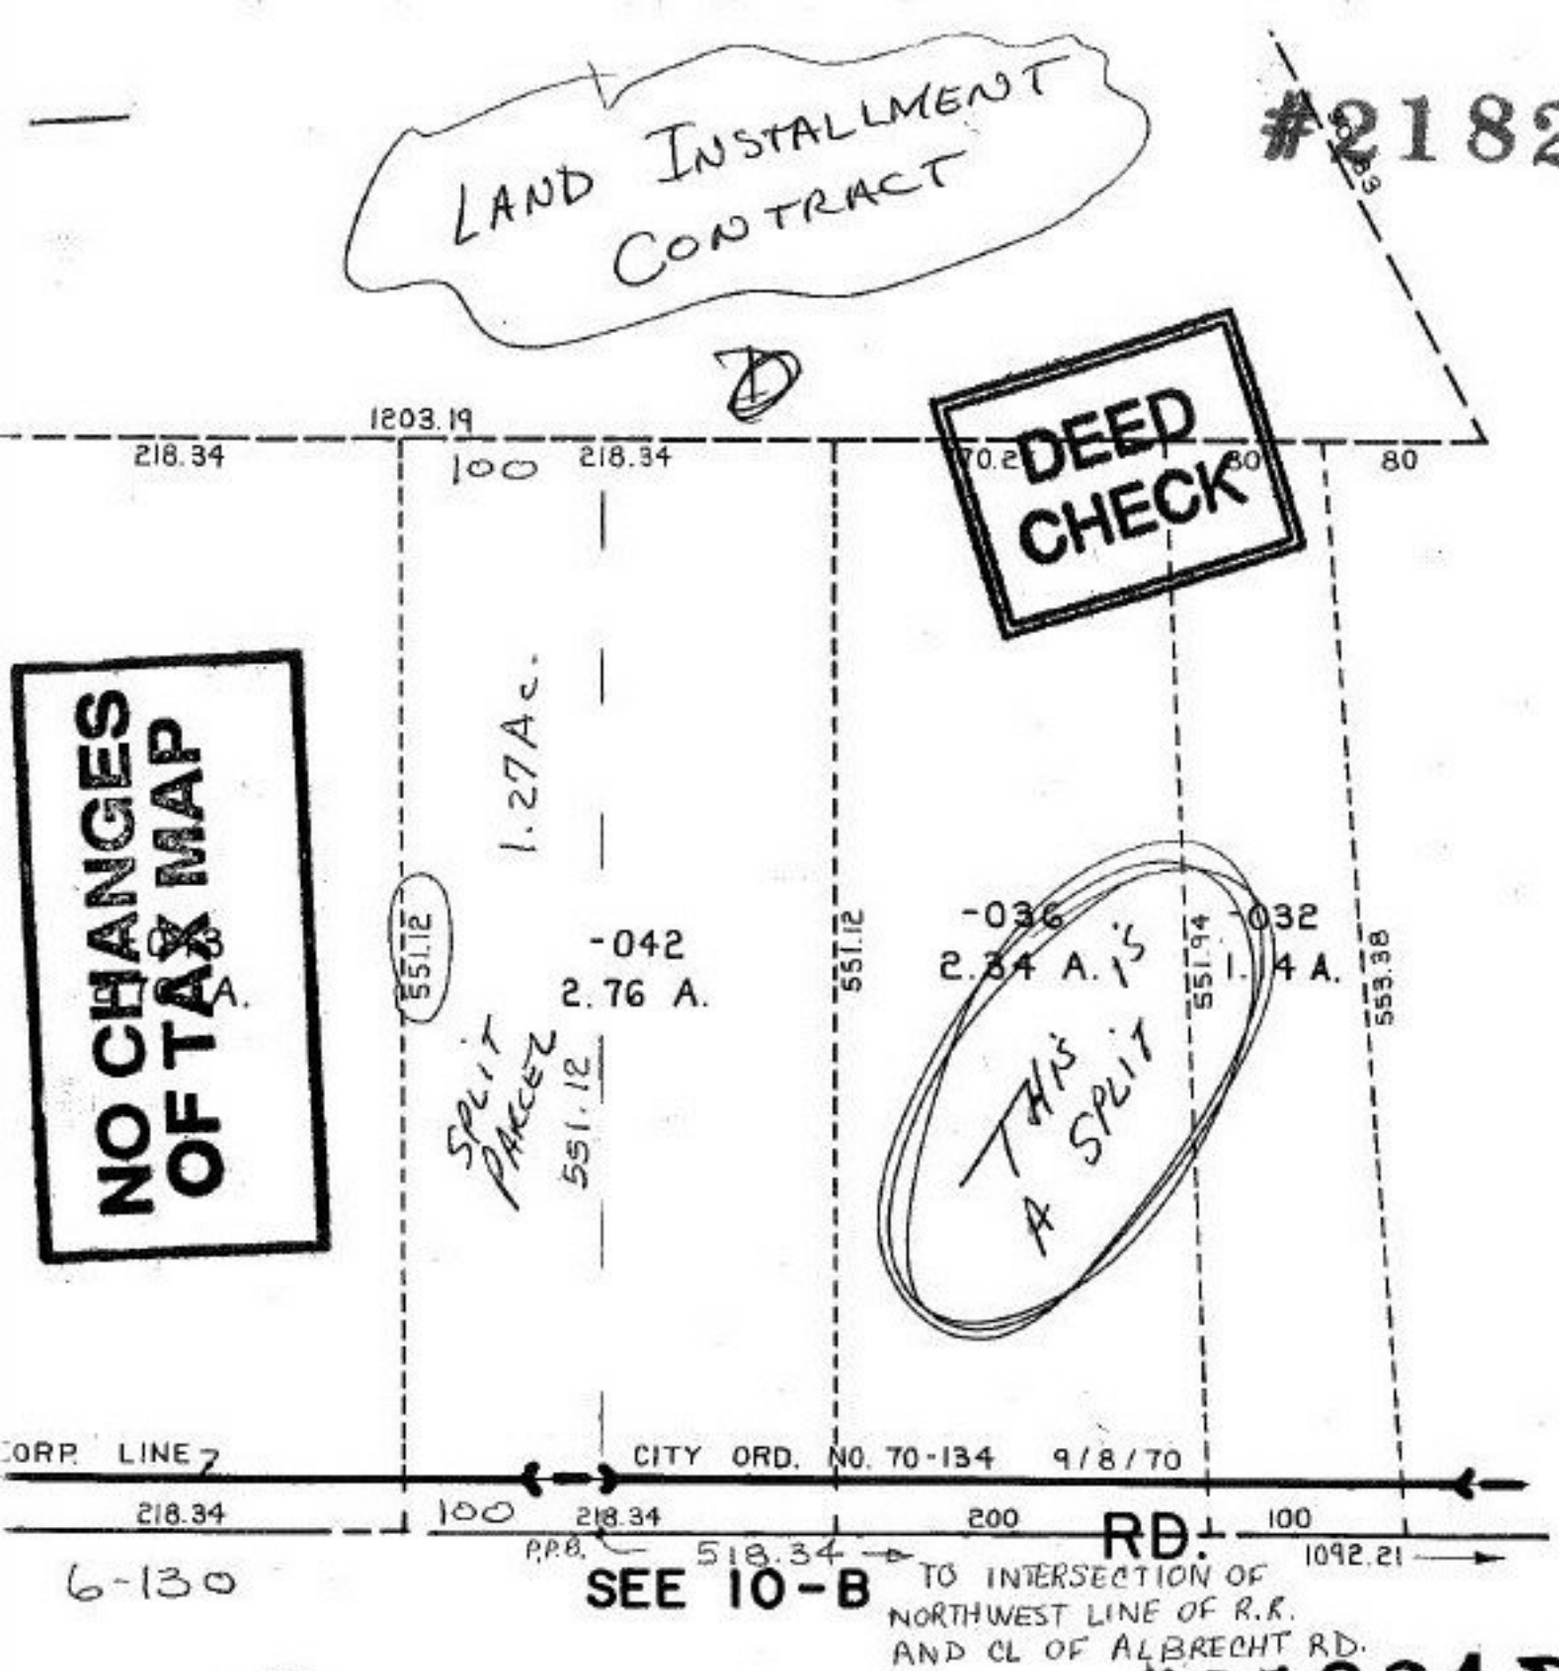

6-130

SEE 10-B TO INTERSECTION OF NORTHWEST LINE OF R.R. AND CL OF ALBRECHT RD.

#21824 D

DEED CHECK

0 100 200

WEST of RIVER

W ly PT. LOTS 5 & 6

APPROVED
LORAIN CO.
MAP DEPT.
DATE 7-16-96
PAGE 6-130
BY
VOID AFTER 21824D