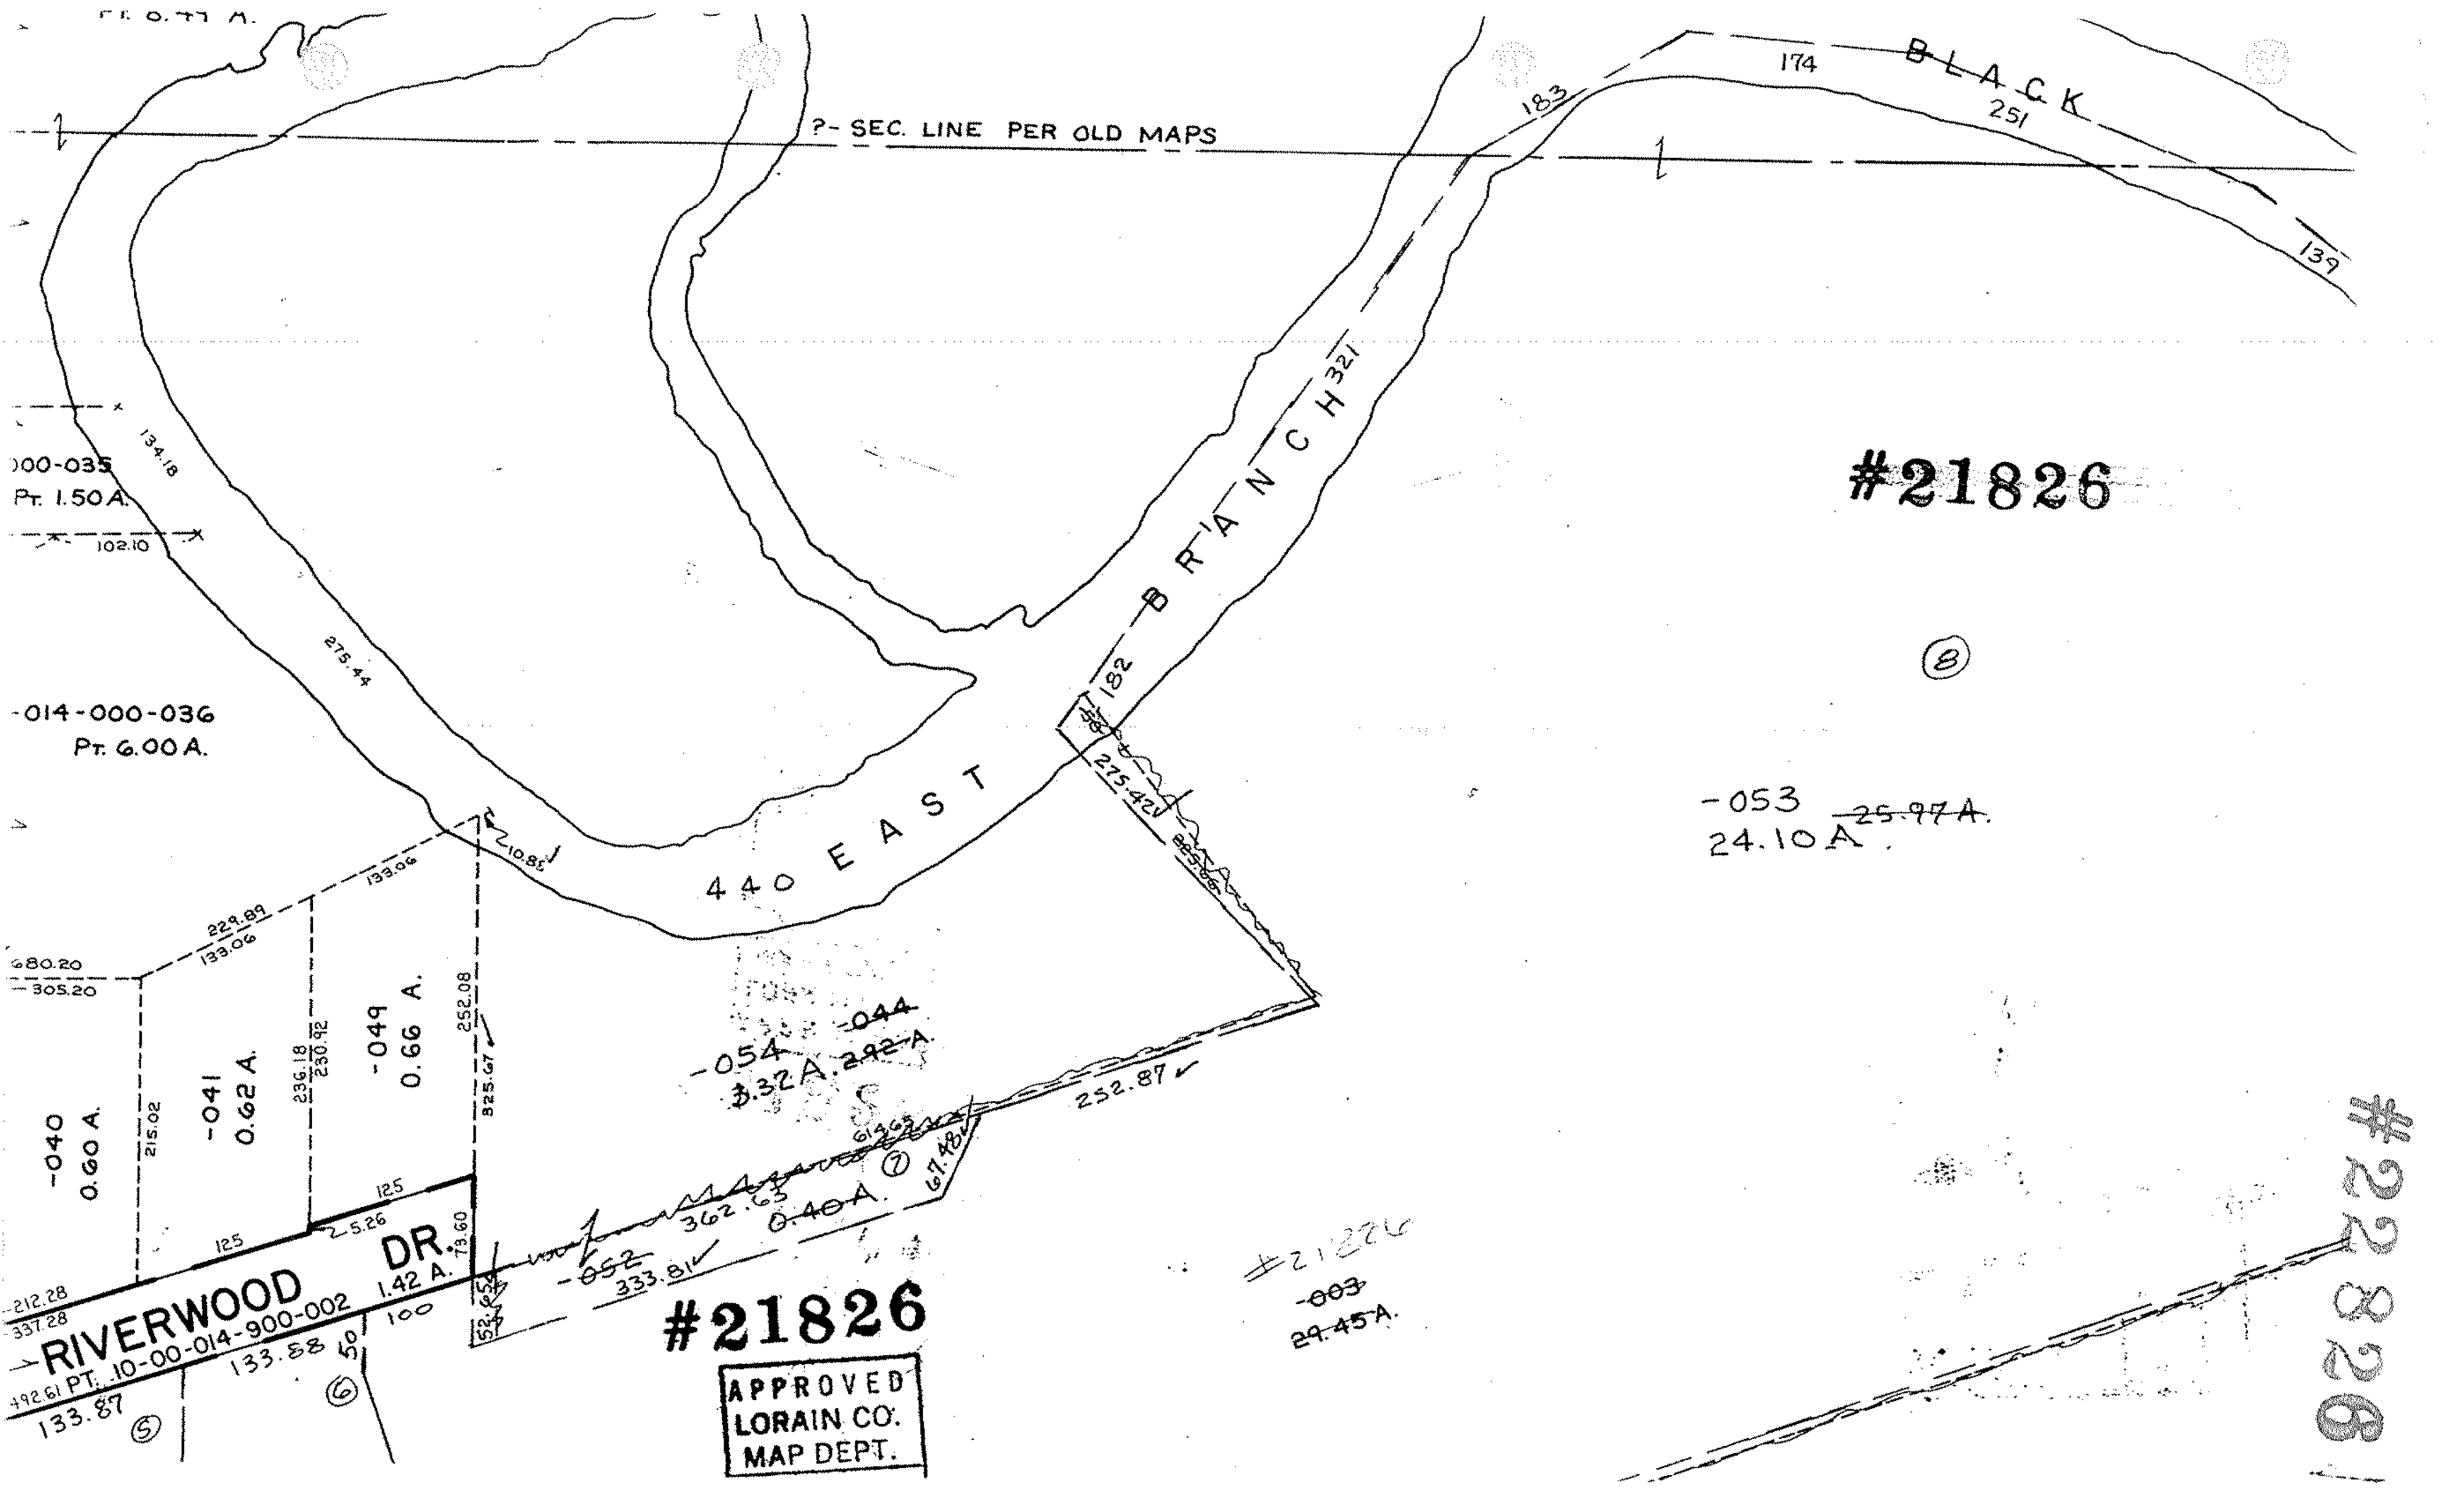

?- SEC. LINE PER OLD MAPS
BLACK
174
251
183
139
BRANCH
321
182
440 EAST
#21826
-053
24.10 A
25.97 A.
-054
3.32 A.
-044
2.92 A.
-052
0.40 A.
-003
29.45 A.
-040
0.60 A.
-041
0.62 A.
-049
0.66 A.
RIVERWOOD DR.
1.42 A.
PT. 10-00-014-900-002
133.87
133.88
-014-000-036
Pt. 6.00 A.
-000-035
Pt. 1.50 A.
134.18
102.10
275.44
275.42
252.87
362.63
333.81
#21826
APPROVED
LORAIN CO.
MAP DEPT.
#22826