


MAPS

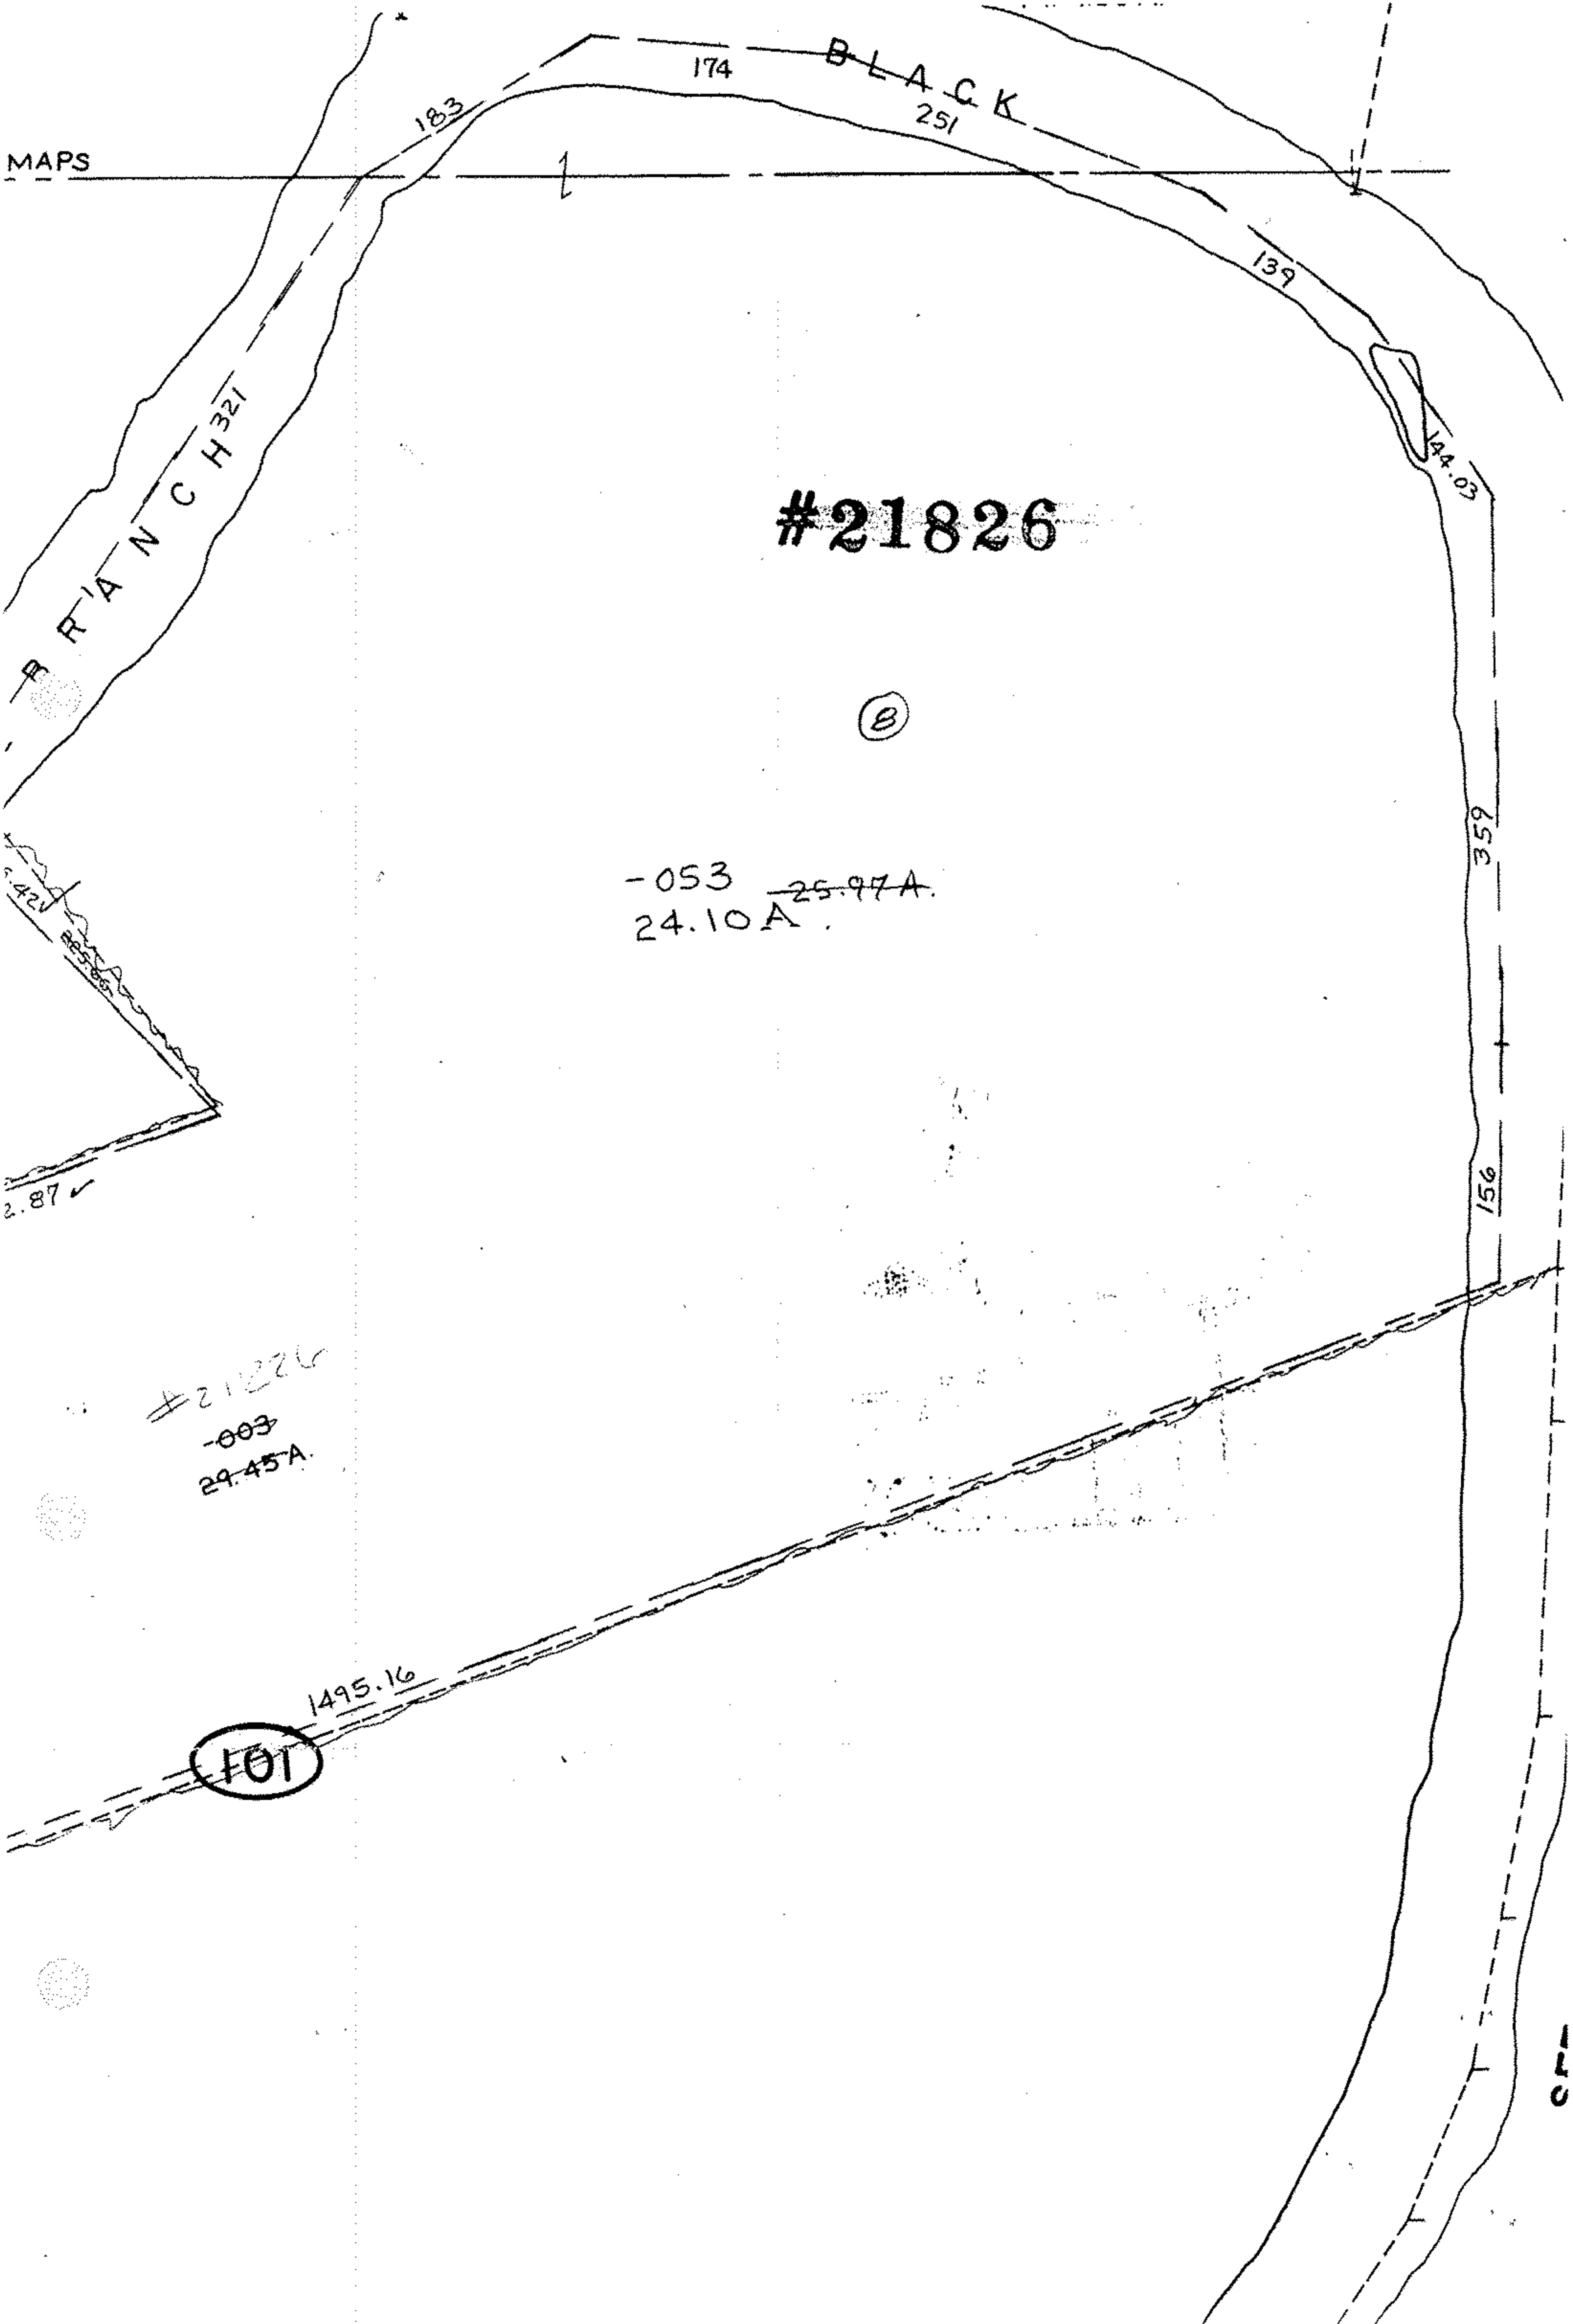

#21826

(B)

-053 25.97A  
24.10A

#21826  
-003  
29.45A

(FOI)

CFA