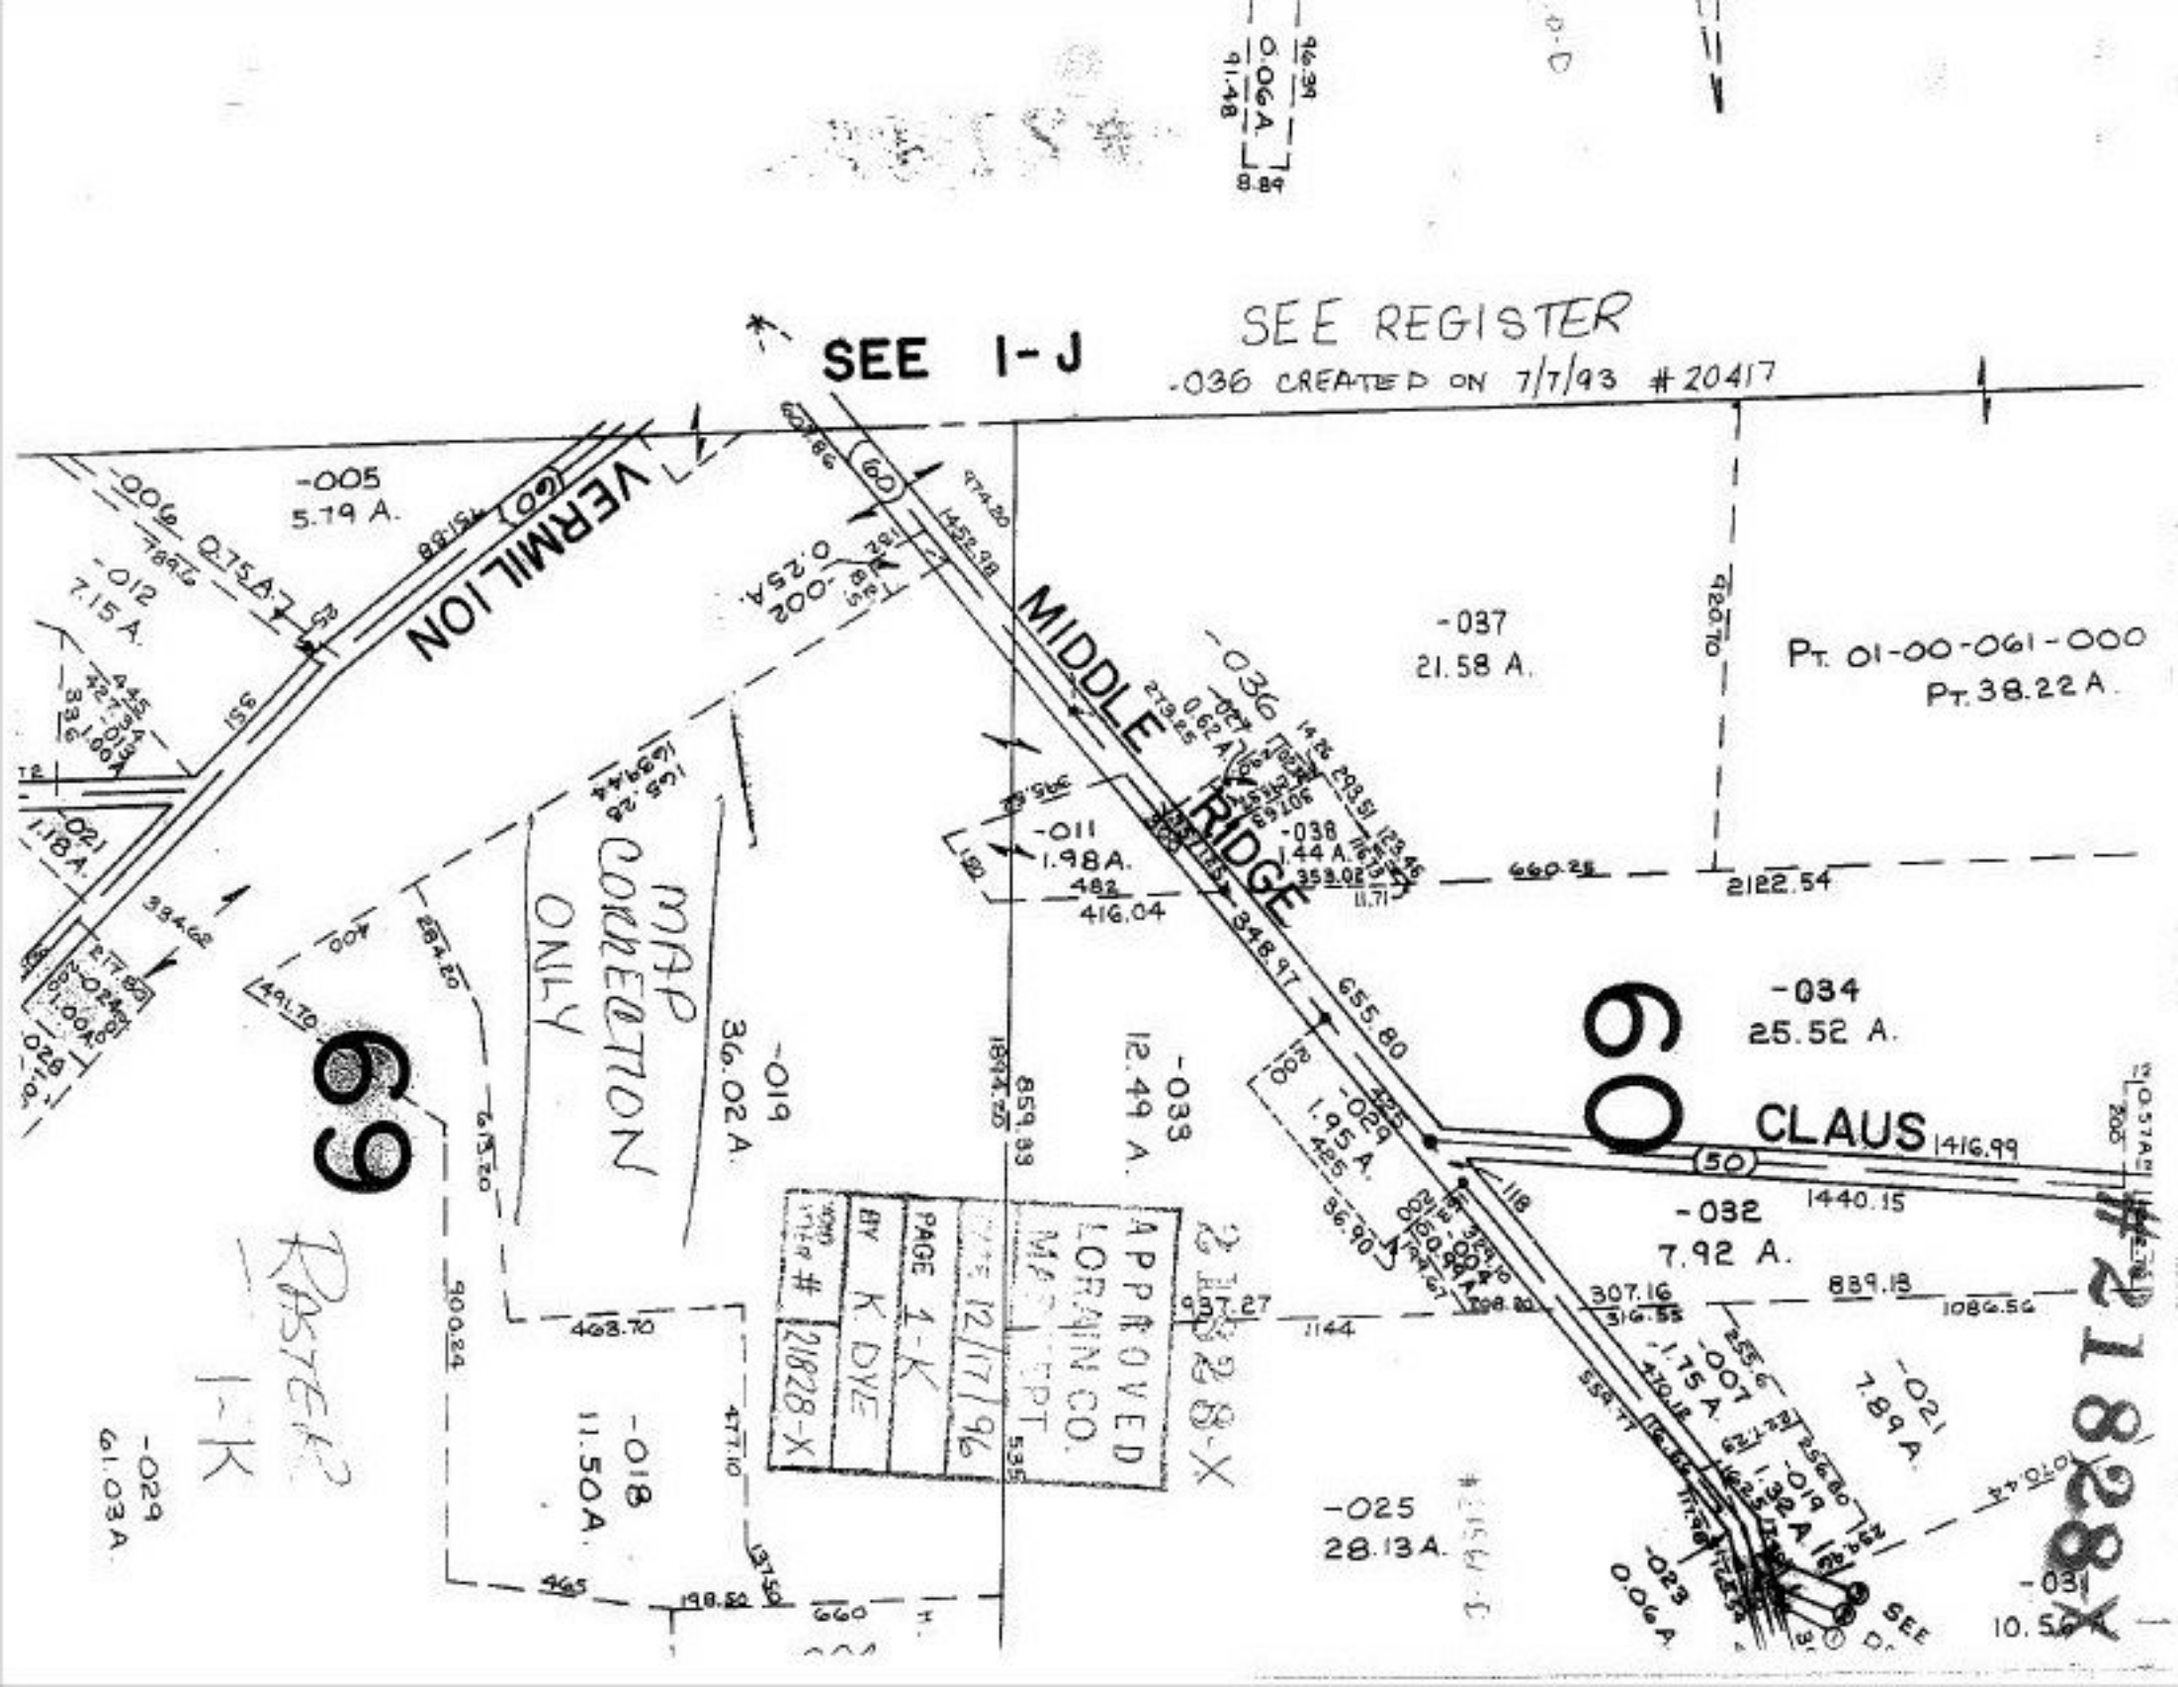
SEE I-J
SEE REGISTER
-036 CREATED ON 7/7/93 #20417
VERMILION
MIDDLE RIDGE
CLAUS
-005
5.79 A.
-006
0.75 A.
-012
7.15 A.
-021
1.18 A.
-011
1.98 A.
-036
0.62 A.
-037
21.58 A.
Pt. 01-00-061-000
Pt. 38.22 A.
-038
1.44 A.
-034
25.52 A.
-029
1.95 A.
-032
7.92 A.
-007
1.75 A.
-019
1.32 A.
-021
7.89 A.
-023
0.06 A.
-031
10.5
-019
36.02 A.
-033
12.49 A.
-025
28.13 A.
-018
11.50 A.
-029
61.03 A.
MAP CORRECTION ONLY
APPROVED LORAIN CO. MAP DEPT.
BY K. DYE
PAGE 1-K
12/17/96
21828-X
69
60
POSTED 1-K
#21828-X