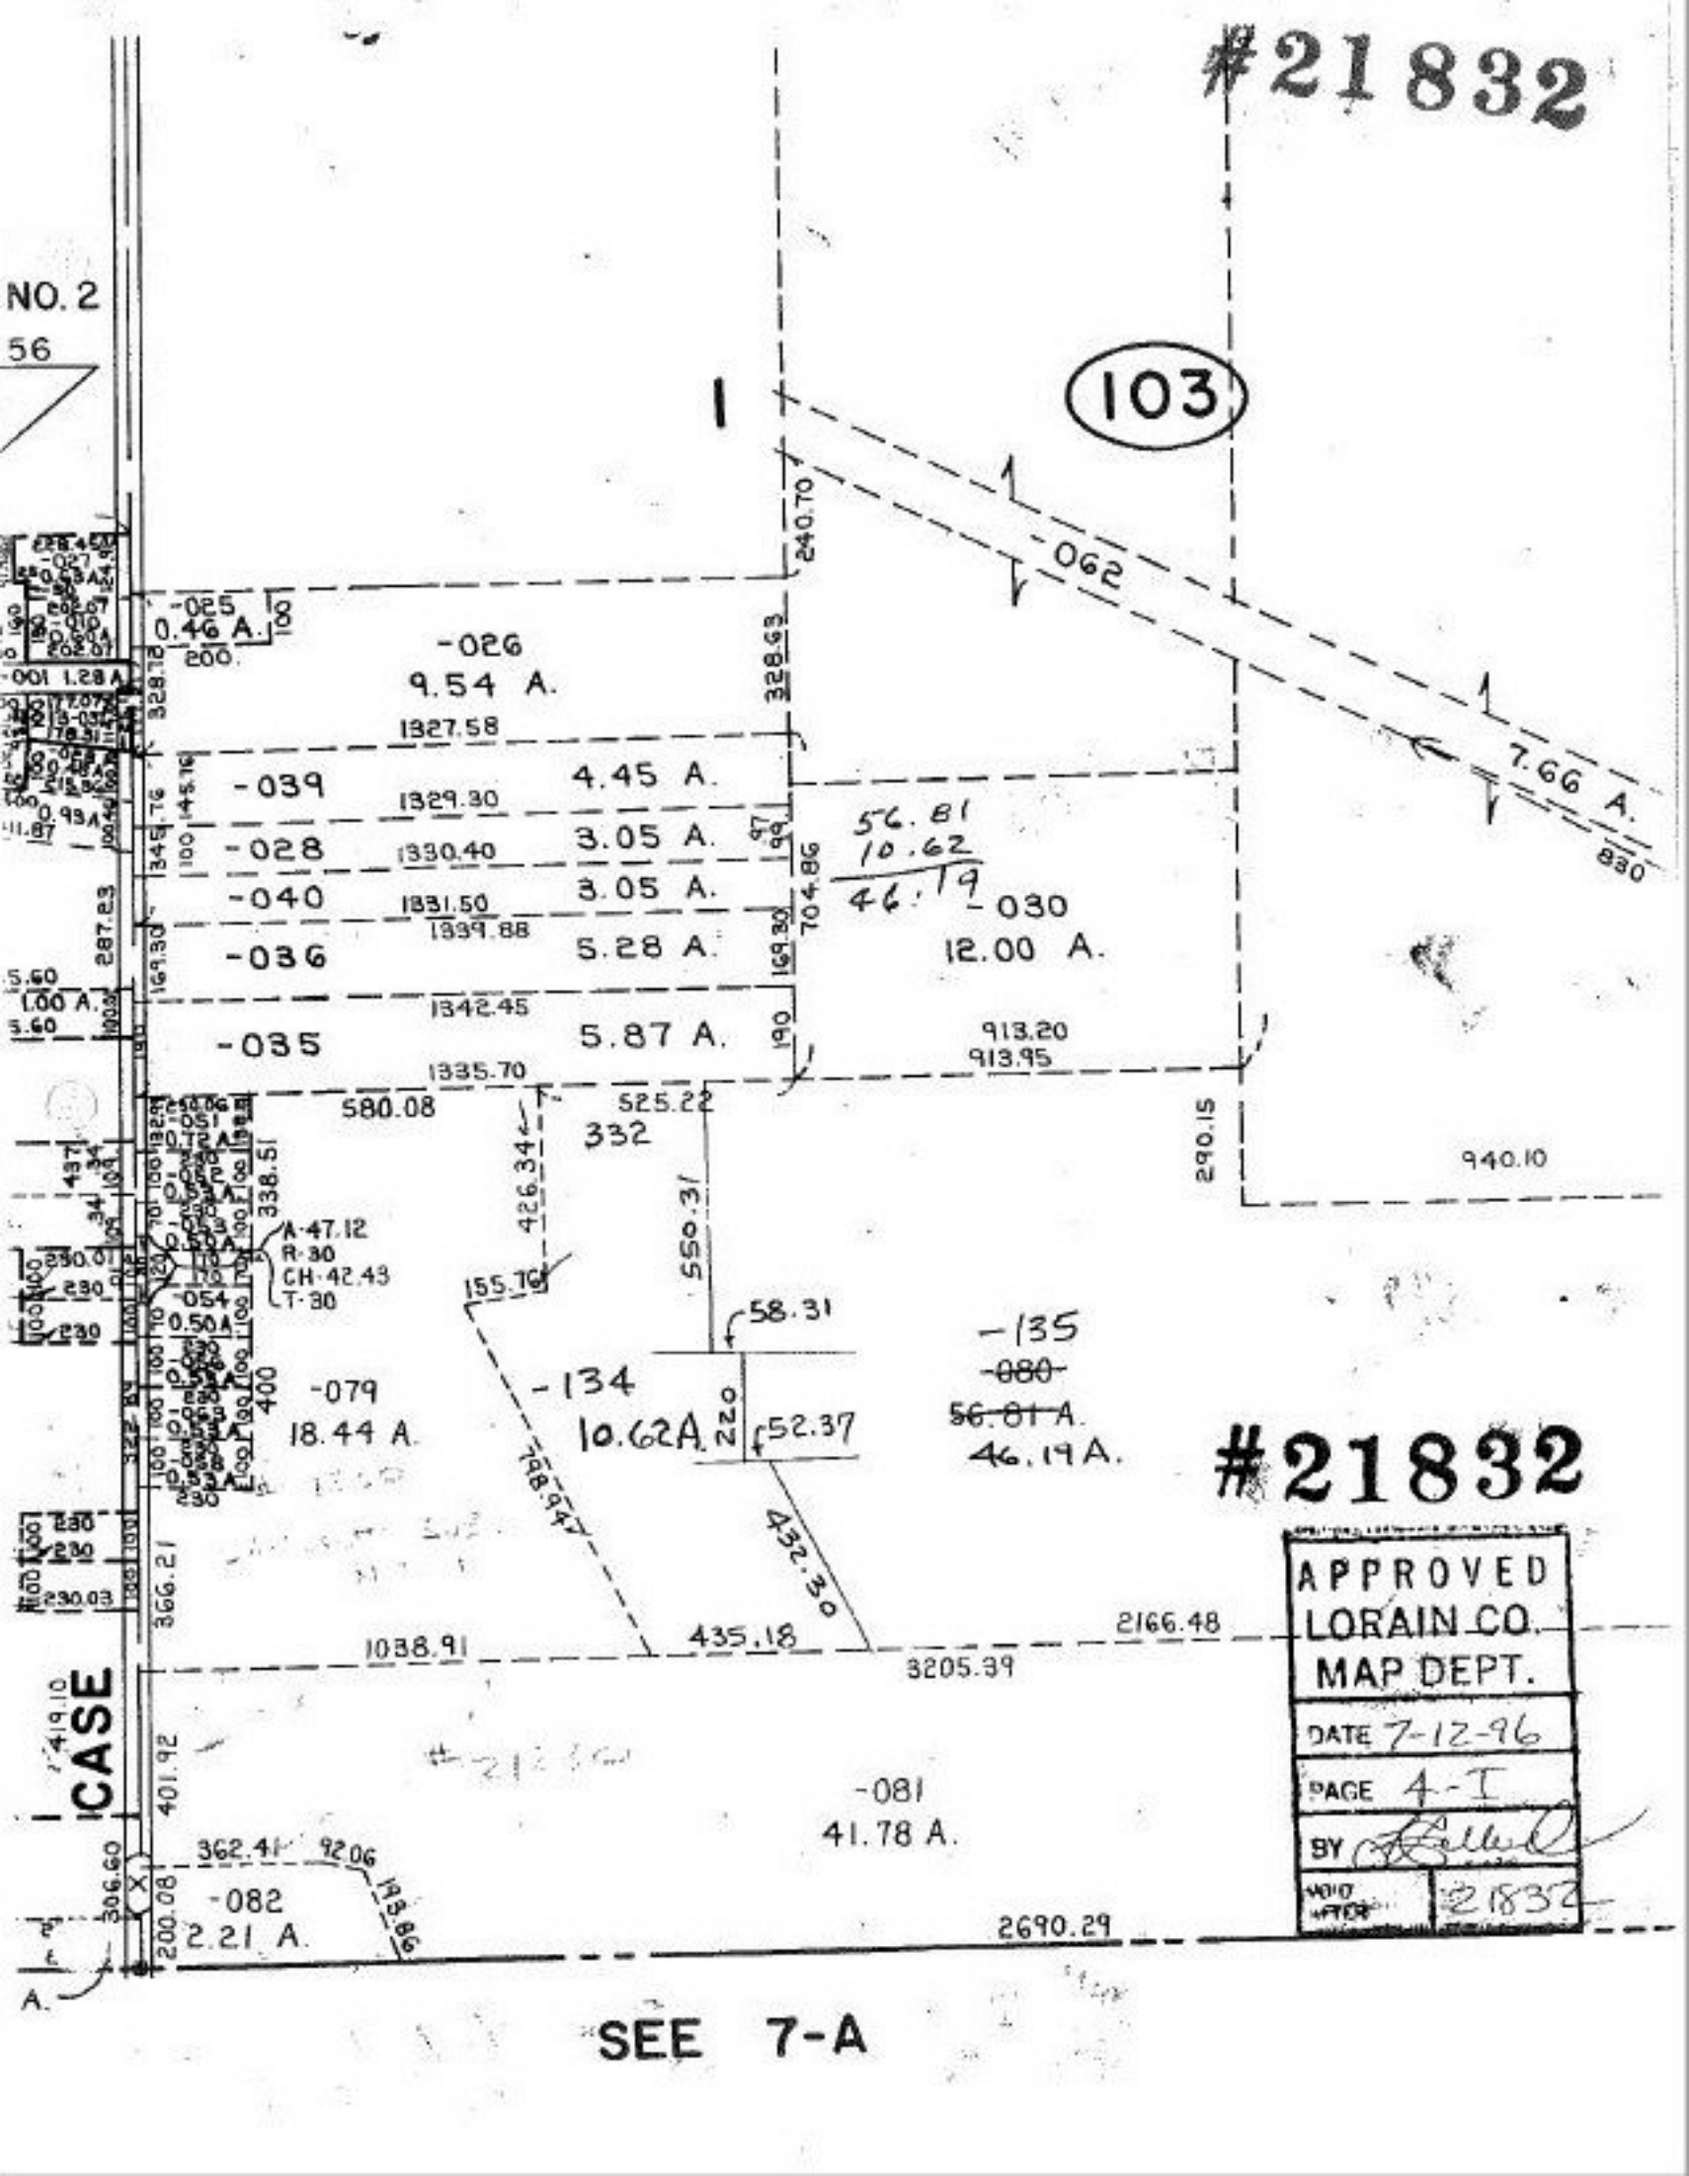
#21832
NO. 2
56
1
103
062
7.66 A.
-025
0.46 A.
-026
9.54 A.
-039
4.45 A.
-028
3.05 A.
-040
3.05 A.
-036
5.28 A.
-035
5.87 A.
-030
12.00 A.
56.81
10.62
46.19
-134
10.62A.
-135
-080-
56.81 A.
46.19A.
-079
18.44 A.
-081
41.78 A.
-082
2.21 A.
-054
0.50A
A-47.12
R-30
CH-42.43
T-30
1327.58
1329.30
1330.40
1331.50
1339.88
1342.45
1335.70
580.08
525.22
332
426.34
550.31
155.76
58.31
52.37
328.63
240.70
704.86
913.20
913.95
290.15
940.10
2166.48
3205.39
1038.91
435.18
2690.29
SEE 7-A
APPROVED
LORAIN CO.
MAP DEPT.
DATE 7-12-96
PAGE 4-I
BY
VOID
#21832