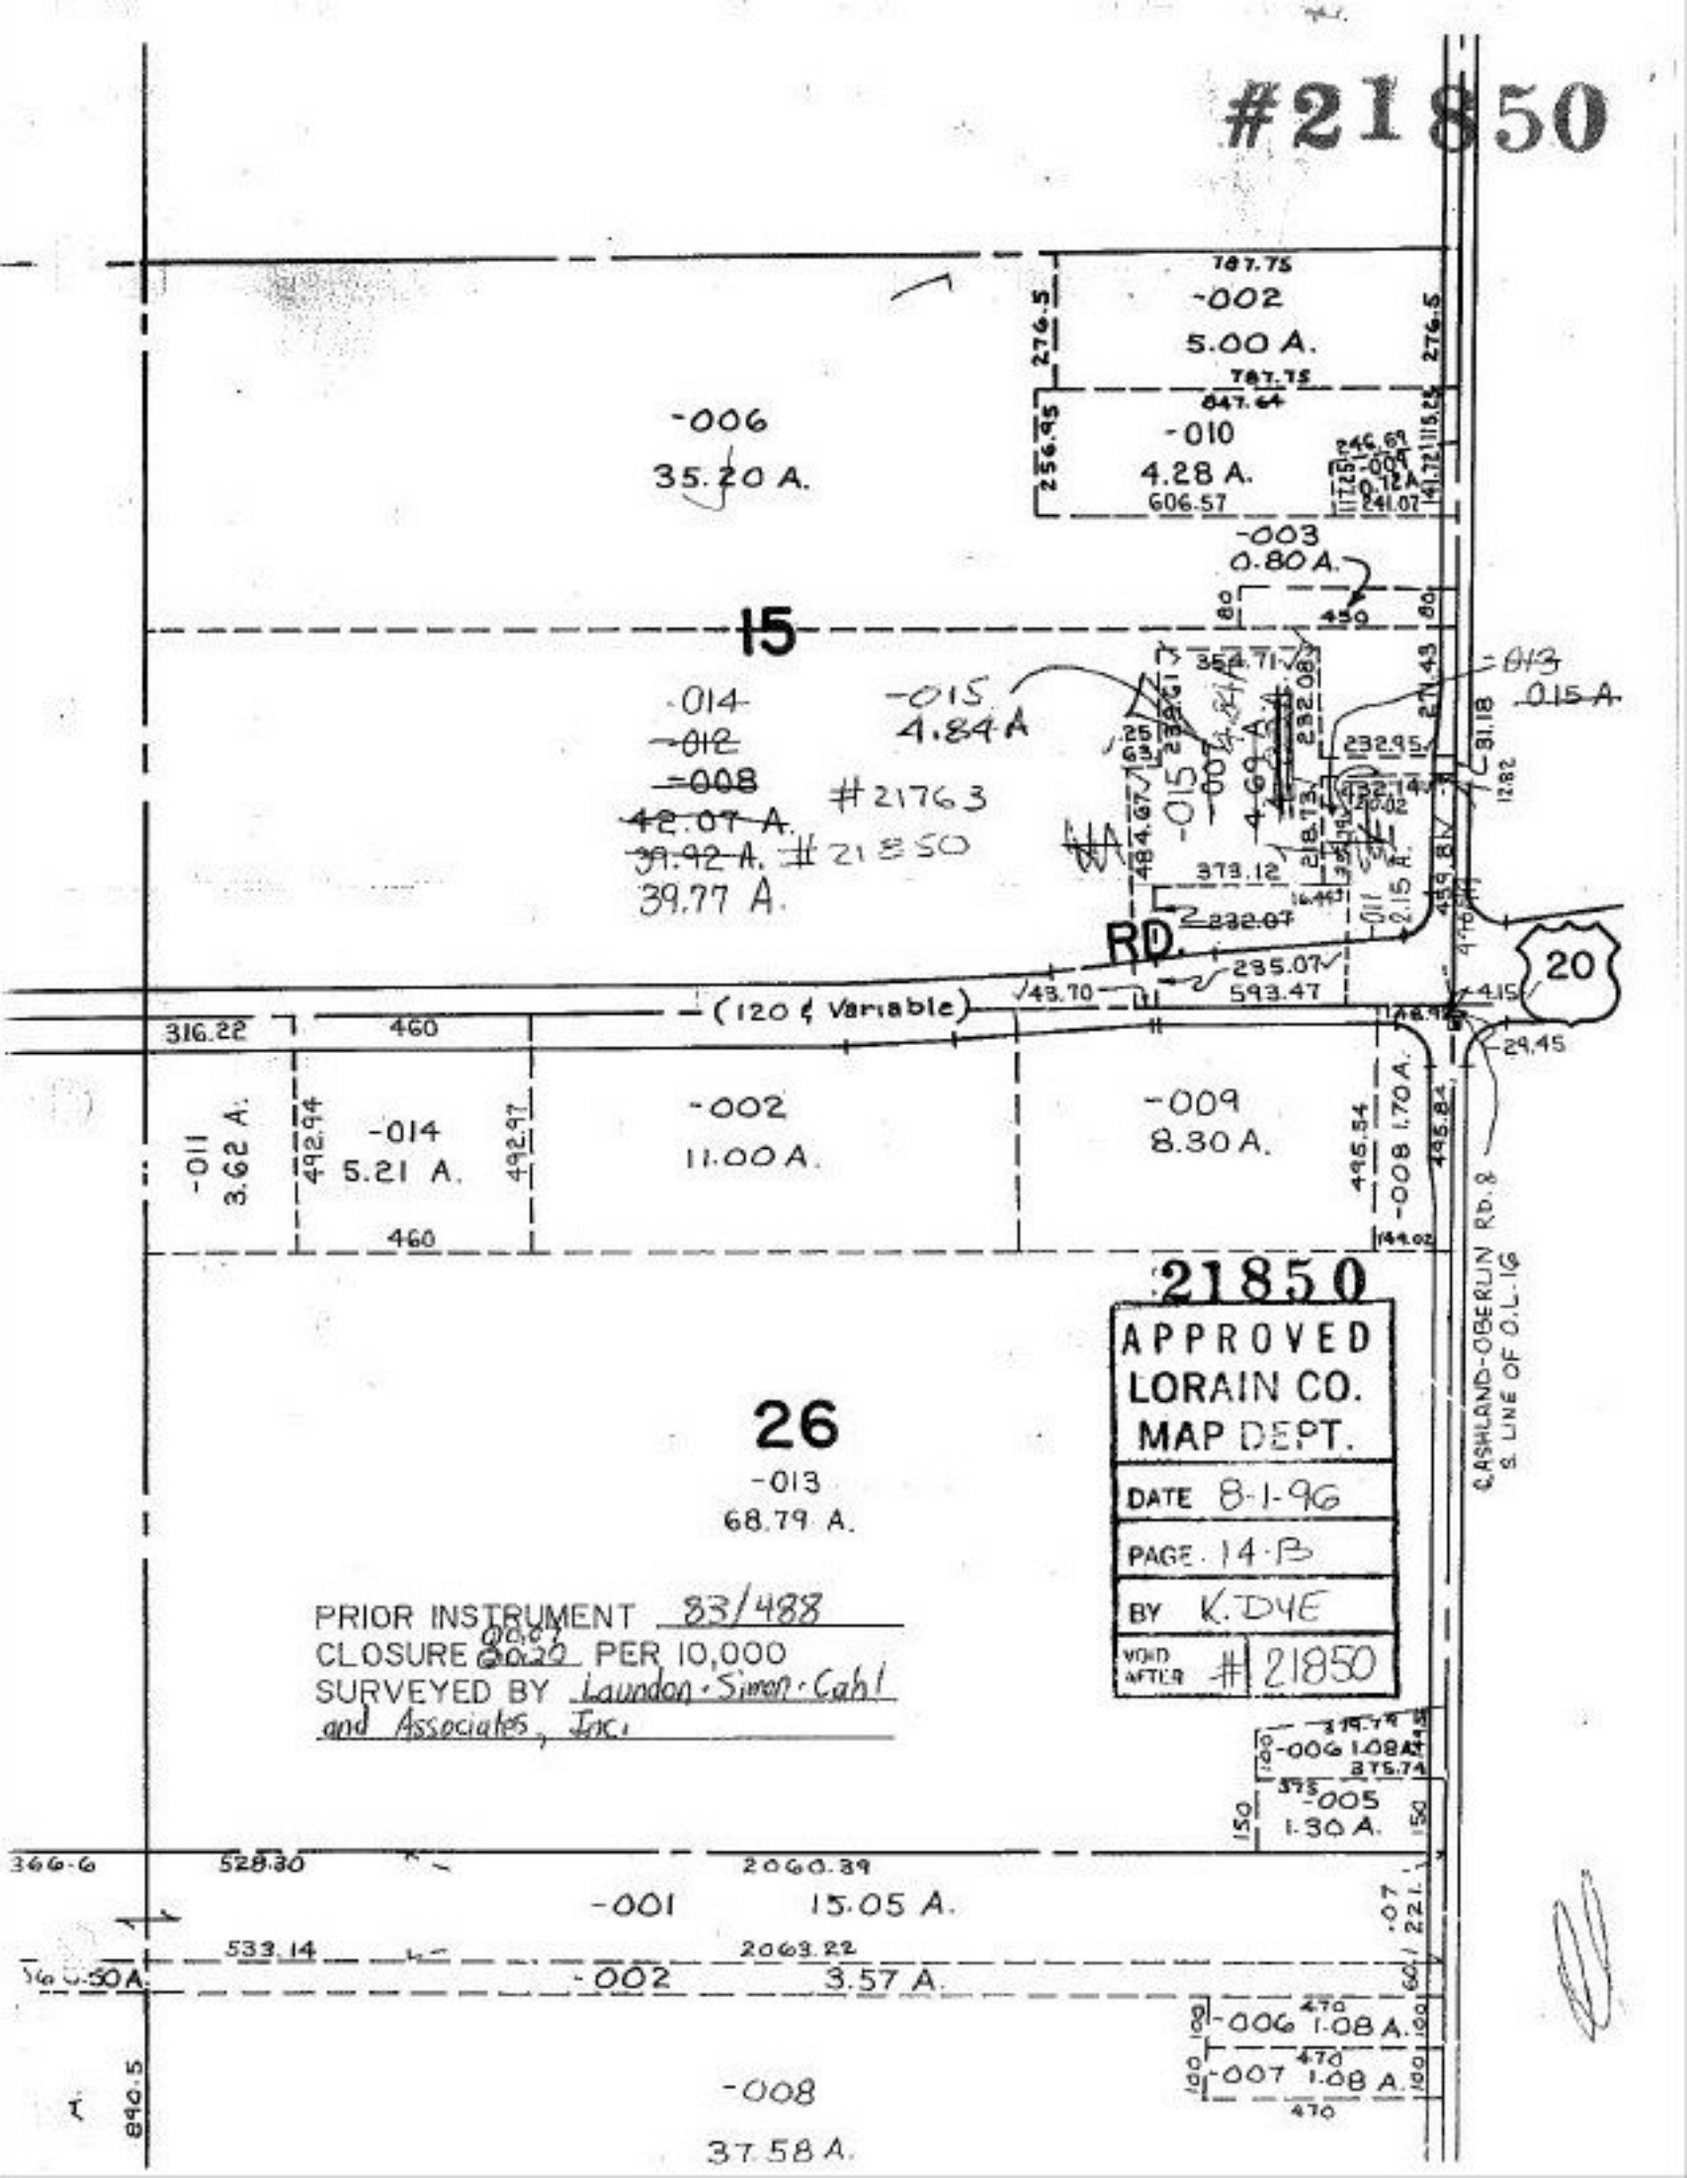
#21850
-002
5.00 A.
-010
4.28 A.
-006
35.20 A.
-003
0.80 A.
15
-014
-012
-008
42.07 A.
39.92 A.
39.77 A.
-015
4.84 A
#21763
#21850
-013
.015 A.
RD.
20
(120 & Variable)
-011
3.62 A.
-014
5.21 A.
-002
11.00 A.
-009
8.30 A.
-008 1.70 A.
CASHLAND-OBERLIN Rd. 8
S. LINE OF O.L. 16
21850
APPROVED
LORAIN CO.
MAP DEPT.
DATE 8-1-96
PAGE 14-B
BY K. DYE
VOID AFTER #21850
26
-013
68.79 A.
PRIOR INSTRUMENT 83/488
CLOSURE 00.07 PER 10,000
SURVEYED BY Laundon-Simon-Cahl and Associates, Inc.
-006 1.08 A.
-005
1.30 A.
-001
15.05 A.
-002
3.57 A.
-006 1.08 A.
-007 1.08 A.
-008
37.58 A.