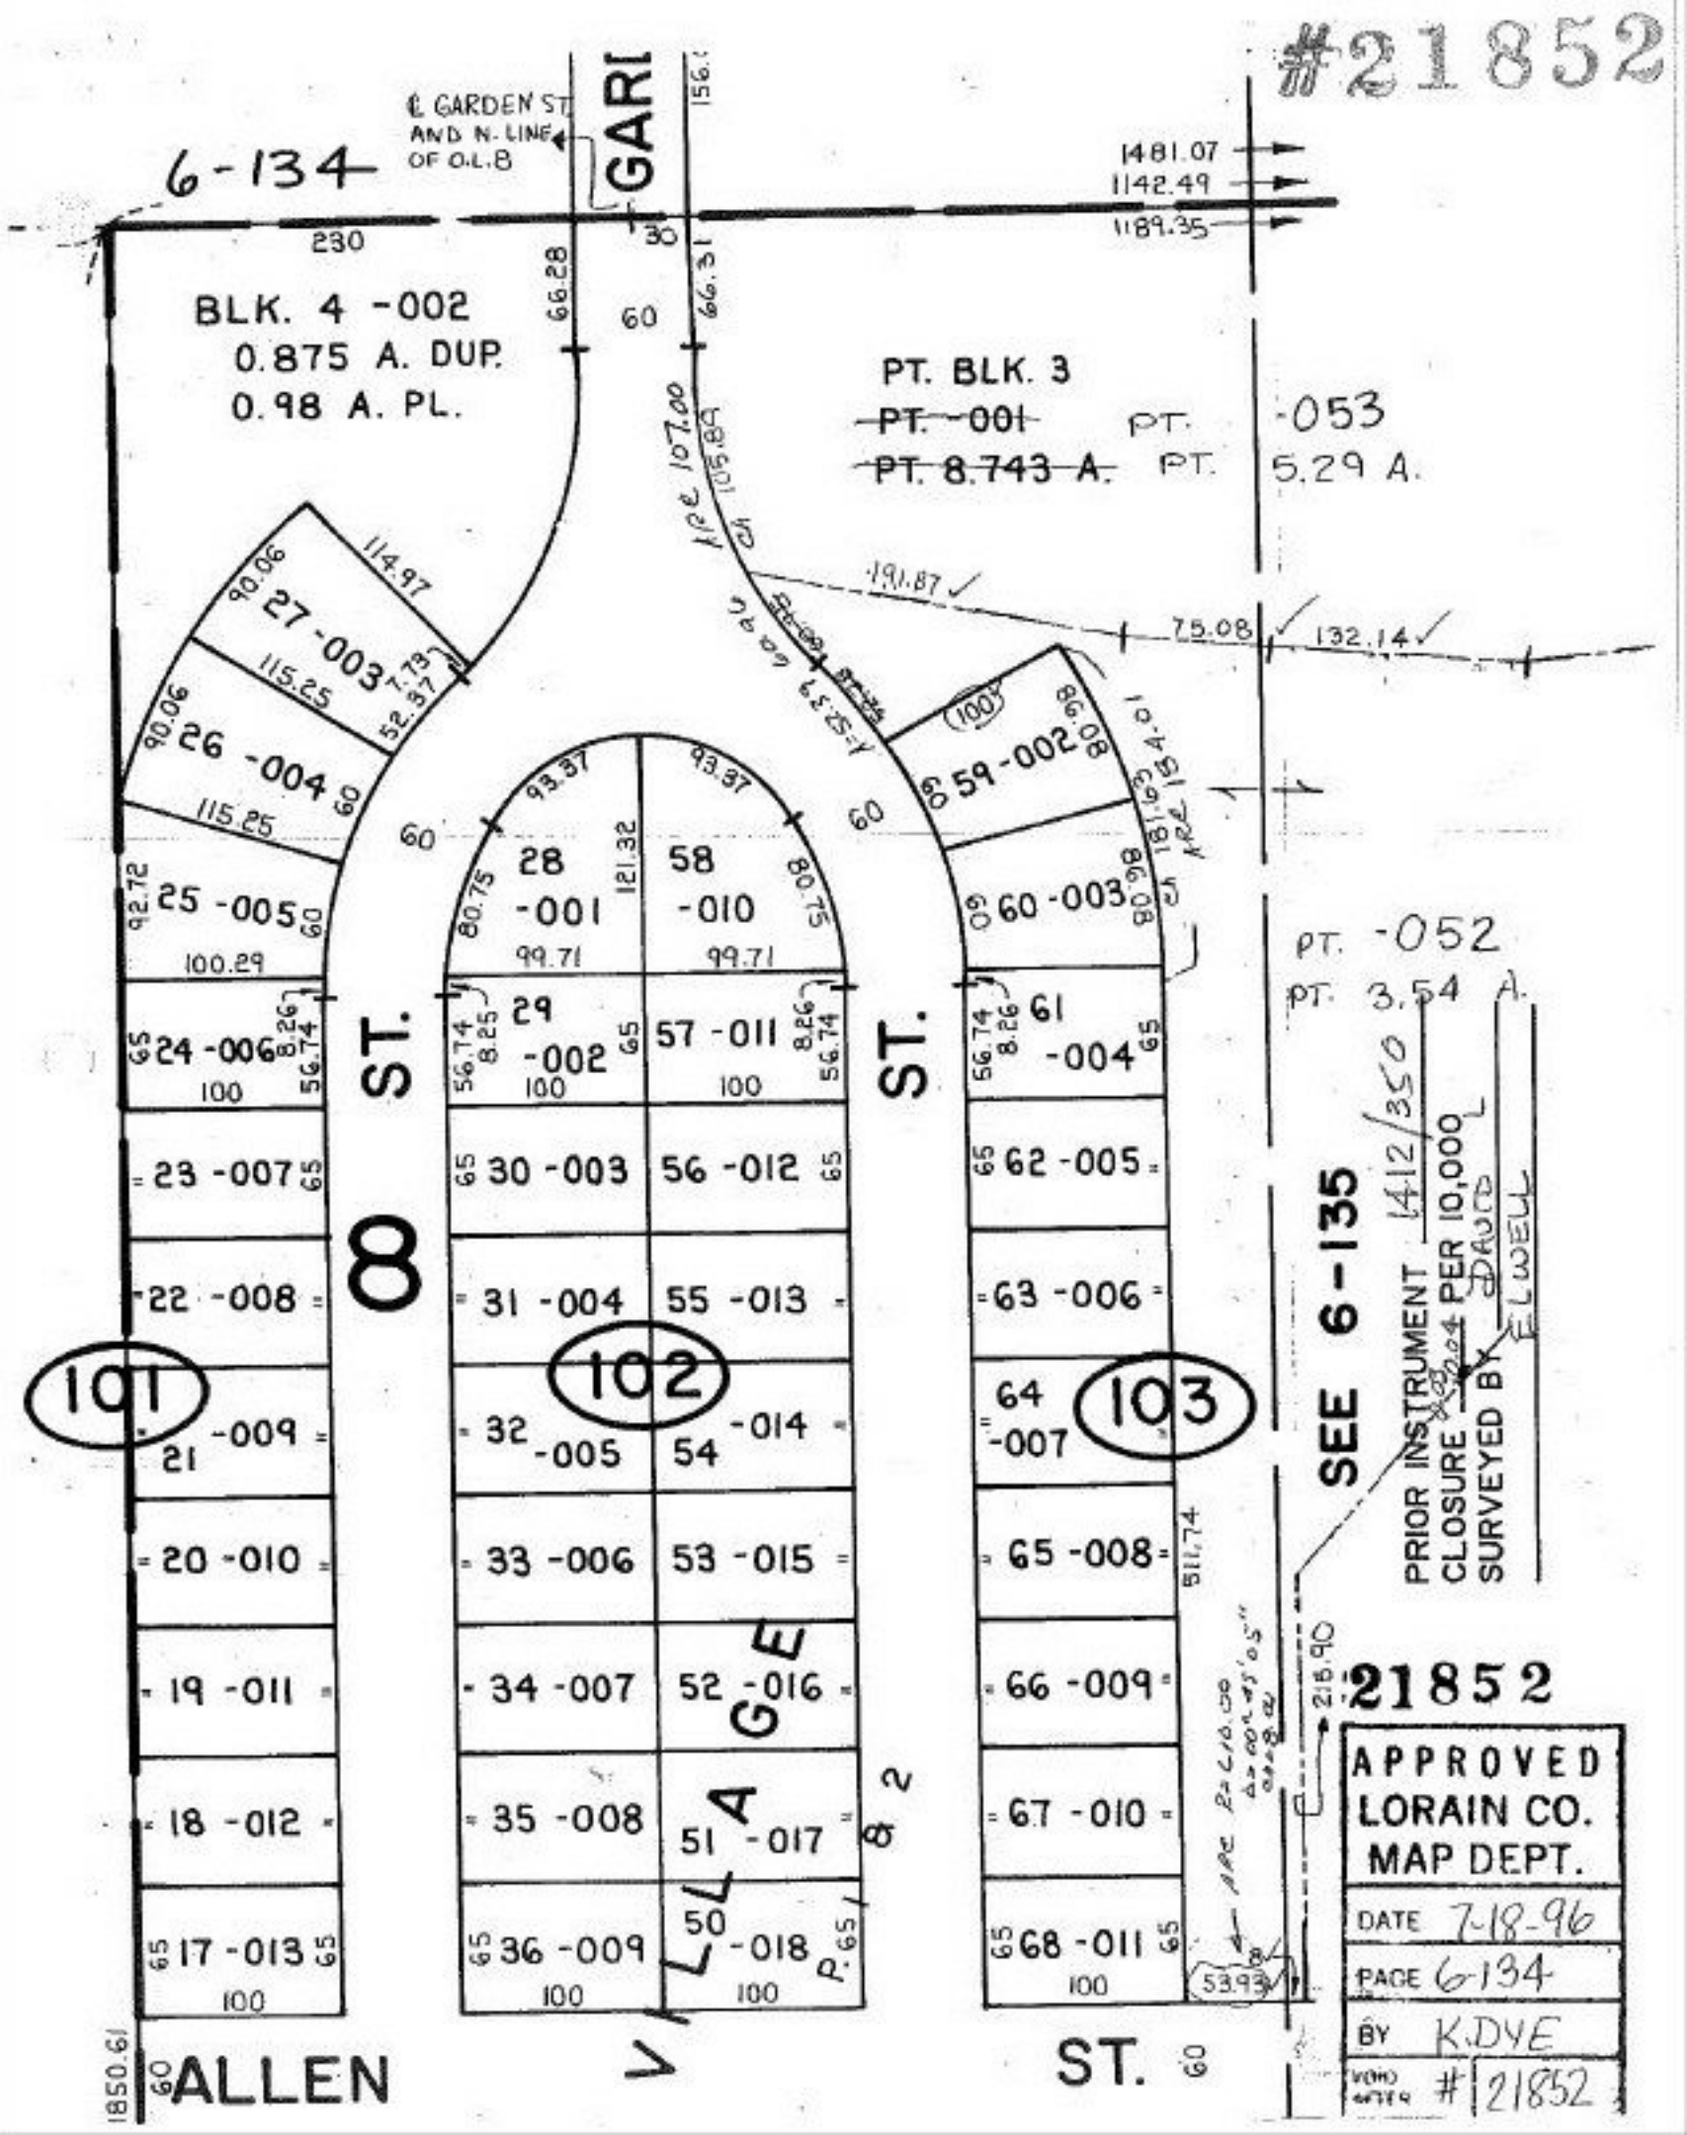
#21852
6-134
℄ GARDEN ST. AND N. LINE OF O.L.8
GARD
1481.07
1142.49
1189.35
230
30
60
66.28
66.31
BLK. 4 -002
0.875 A. DUP.
0.98 A. PL.
PT. BLK. 3
~~PT. -001~~
~~PT. 8.743 A.~~
PT. -053
PT. 5.29 A.
191.87
75.08
132.14
27 -003
26 -004
25 -005
24 -006
23 -007
22 -008
21 -009
20 -010
19 -011
18 -012
17 -013
28 -001
29 -002
30 -003
31 -004
32 -005
33 -006
34 -007
35 -008
36 -009
58 -010
57 -011
56 -012
55 -013
54 -014
53 -015
52 -016
51 -017
50 -018
59 -002
60 -003
61 -004
62 -005
63 -006
64 -007
65 -008
66 -009
67 -010
68 -011
PT. -052
PT. 3.54 A.
8 ST.
ST.
101
102
103
VILLAGE
ALLEN
ST.
SEE 6-135
PRIOR INSTRUMENT 1412/350
CLOSURE 4.00 PER 10,000
SURVEYED BY DAVID L. ELWELL
21852
APPROVED
LORAIN CO.
MAP DEPT.
DATE 7-18-96
PAGE 6-134
BY K.DYE
VOID AFTER # 21852