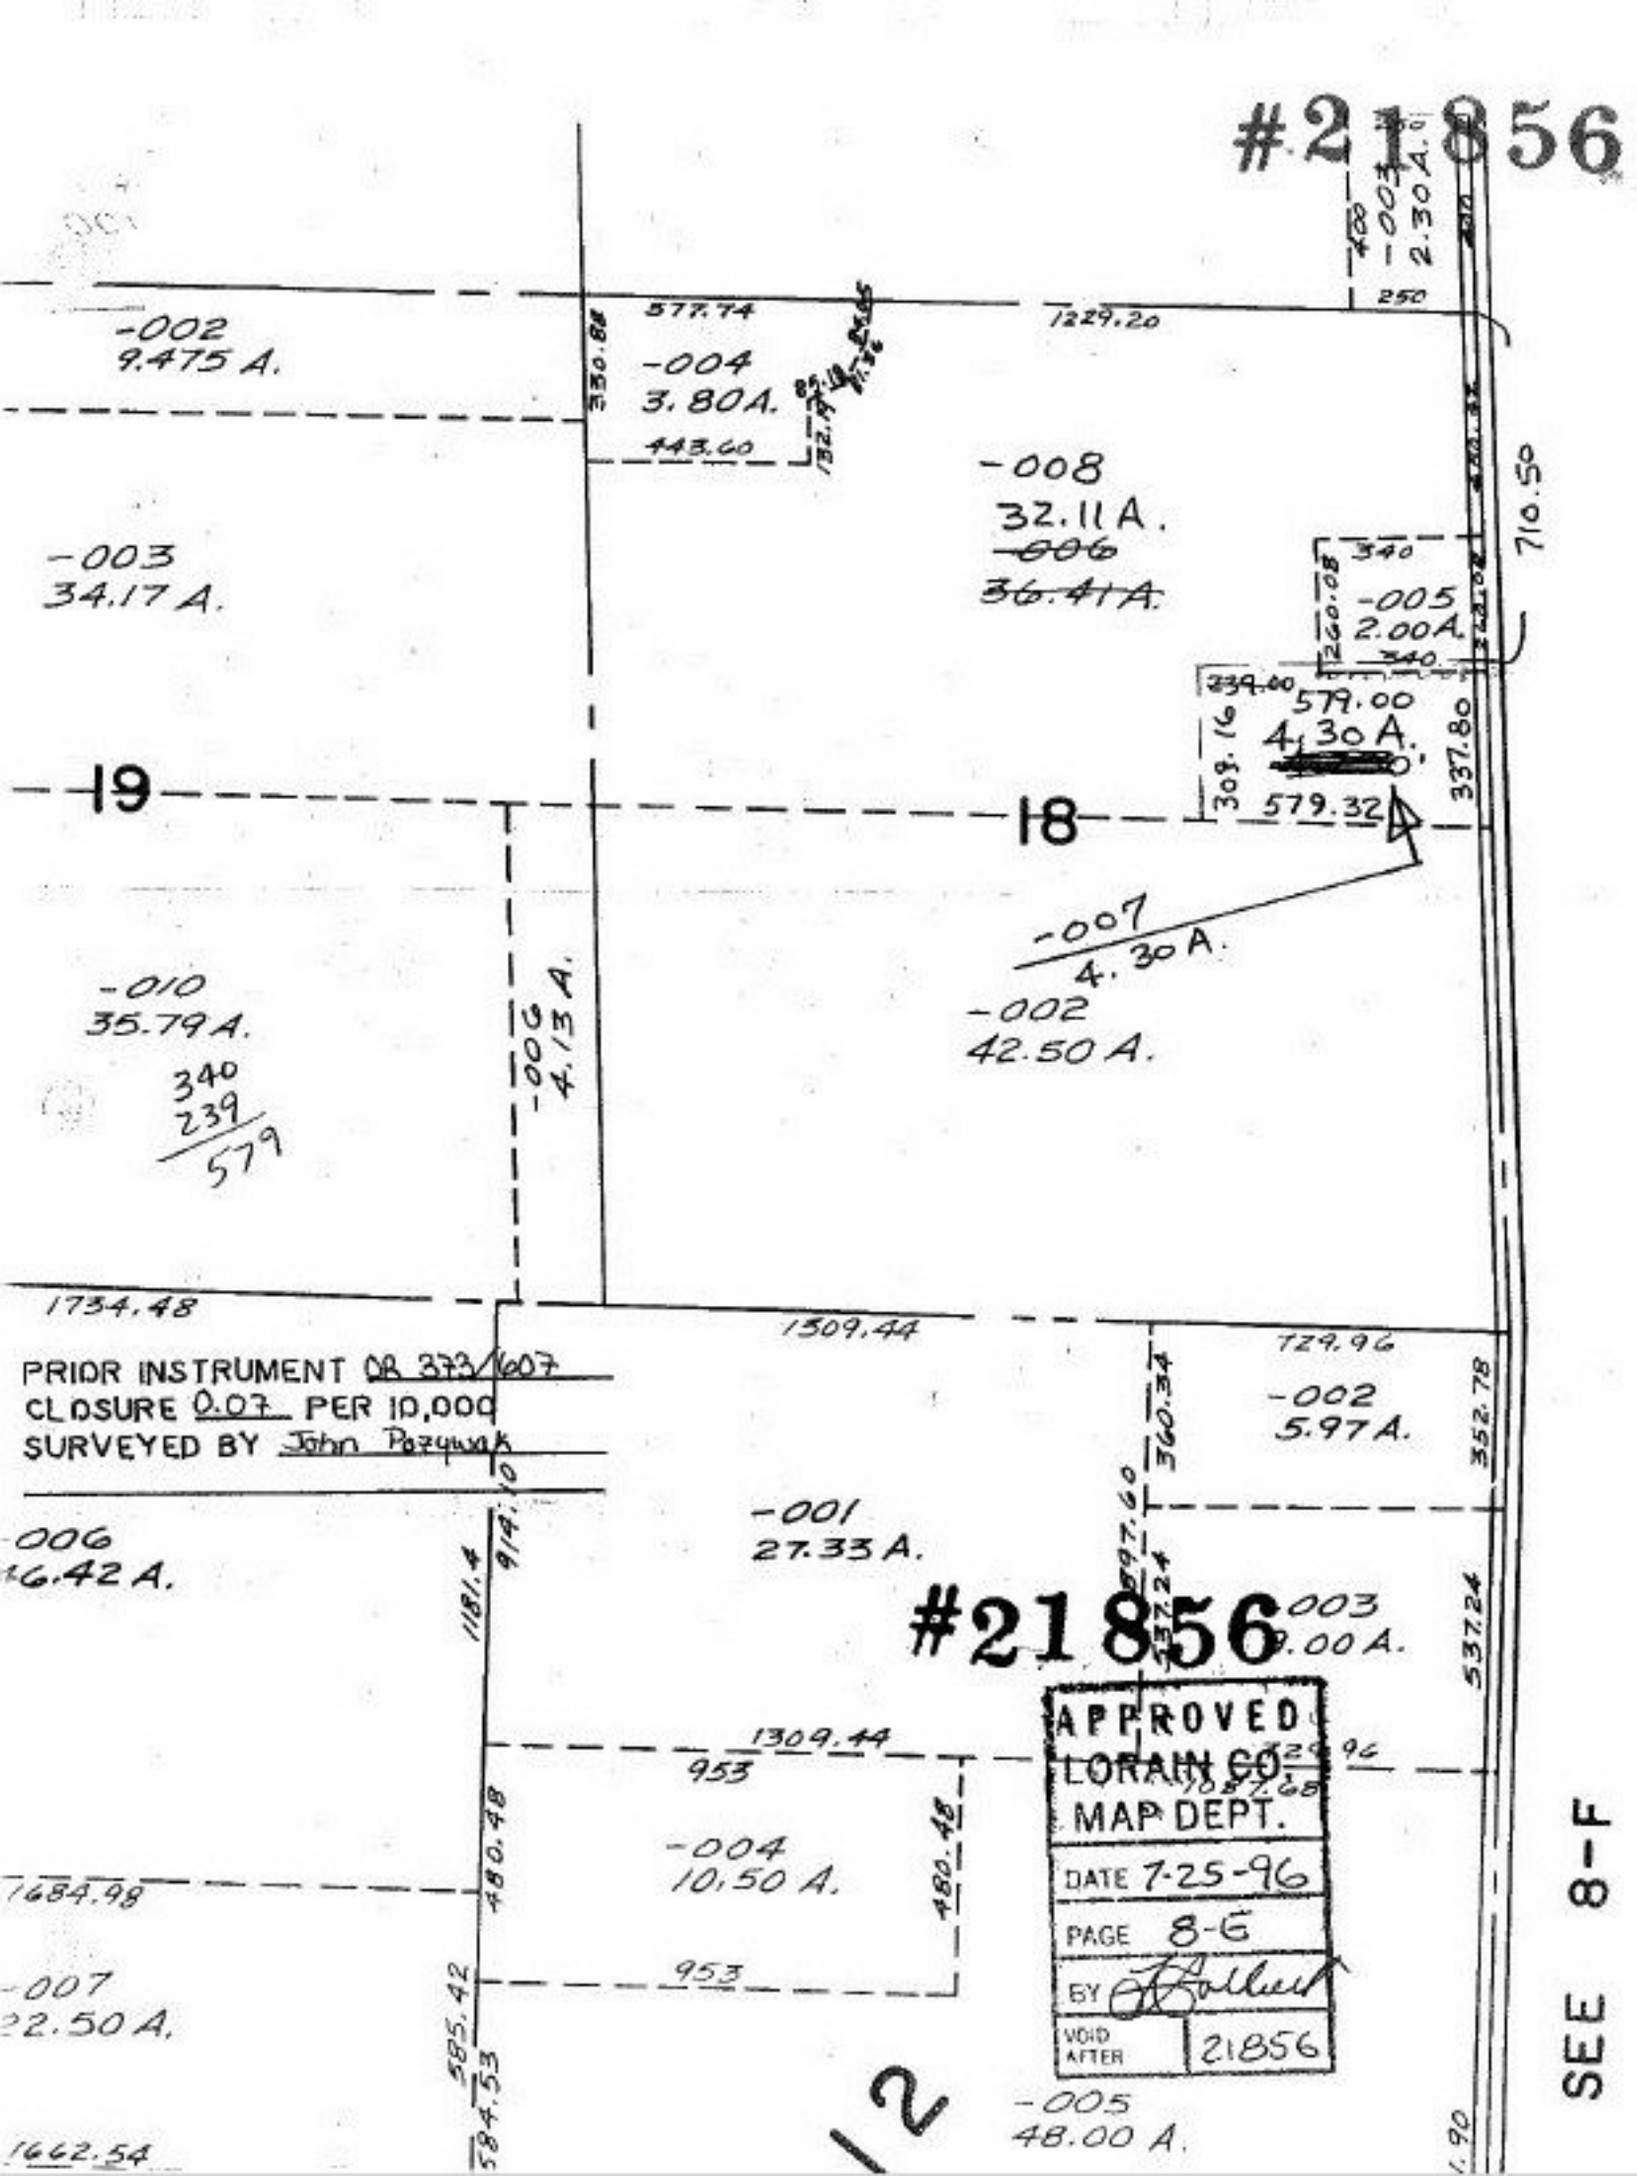
#21856
-002
9.475 A.
577.74
1229.20
330.88
-004
3.80A.
443.60
132.72
-008
32.11A.
-006
36.41A.
-003
34.17 A.
-003
2.30 A.
250
710.50
340
260.08
-005
2.00A.
340
239.00
579.00
4.30 A.
309.16
337.80
579.32
19
18
-007
4.30 A.
-002
42.50 A.
-010
35.79A.
340
239
579
-006
4.13 A.
1734.48
1309.44
729.96
PRIOR INSTRUMENT OR 373/1607
CLOSURE 0.07 PER 10,000
SURVEYED BY John Pozywak
-002
5.97A.
360.34
352.78
-001
27.33 A.
-006
16.42 A.
1181.4
914.10
597.60
537.24
#21856
003
.00 A.
APPROVED
LORAIN CO.
MAP DEPT.
DATE 7-25-96
PAGE 8-E
BY
VOID AFTER 21856
1309.44
953
480.48
480.48
-004
10.50 A.
1684.98
-007
22.50 A.
953
585.42
584.53
-005
48.00 A.
1662.54
12
SEE 8-F