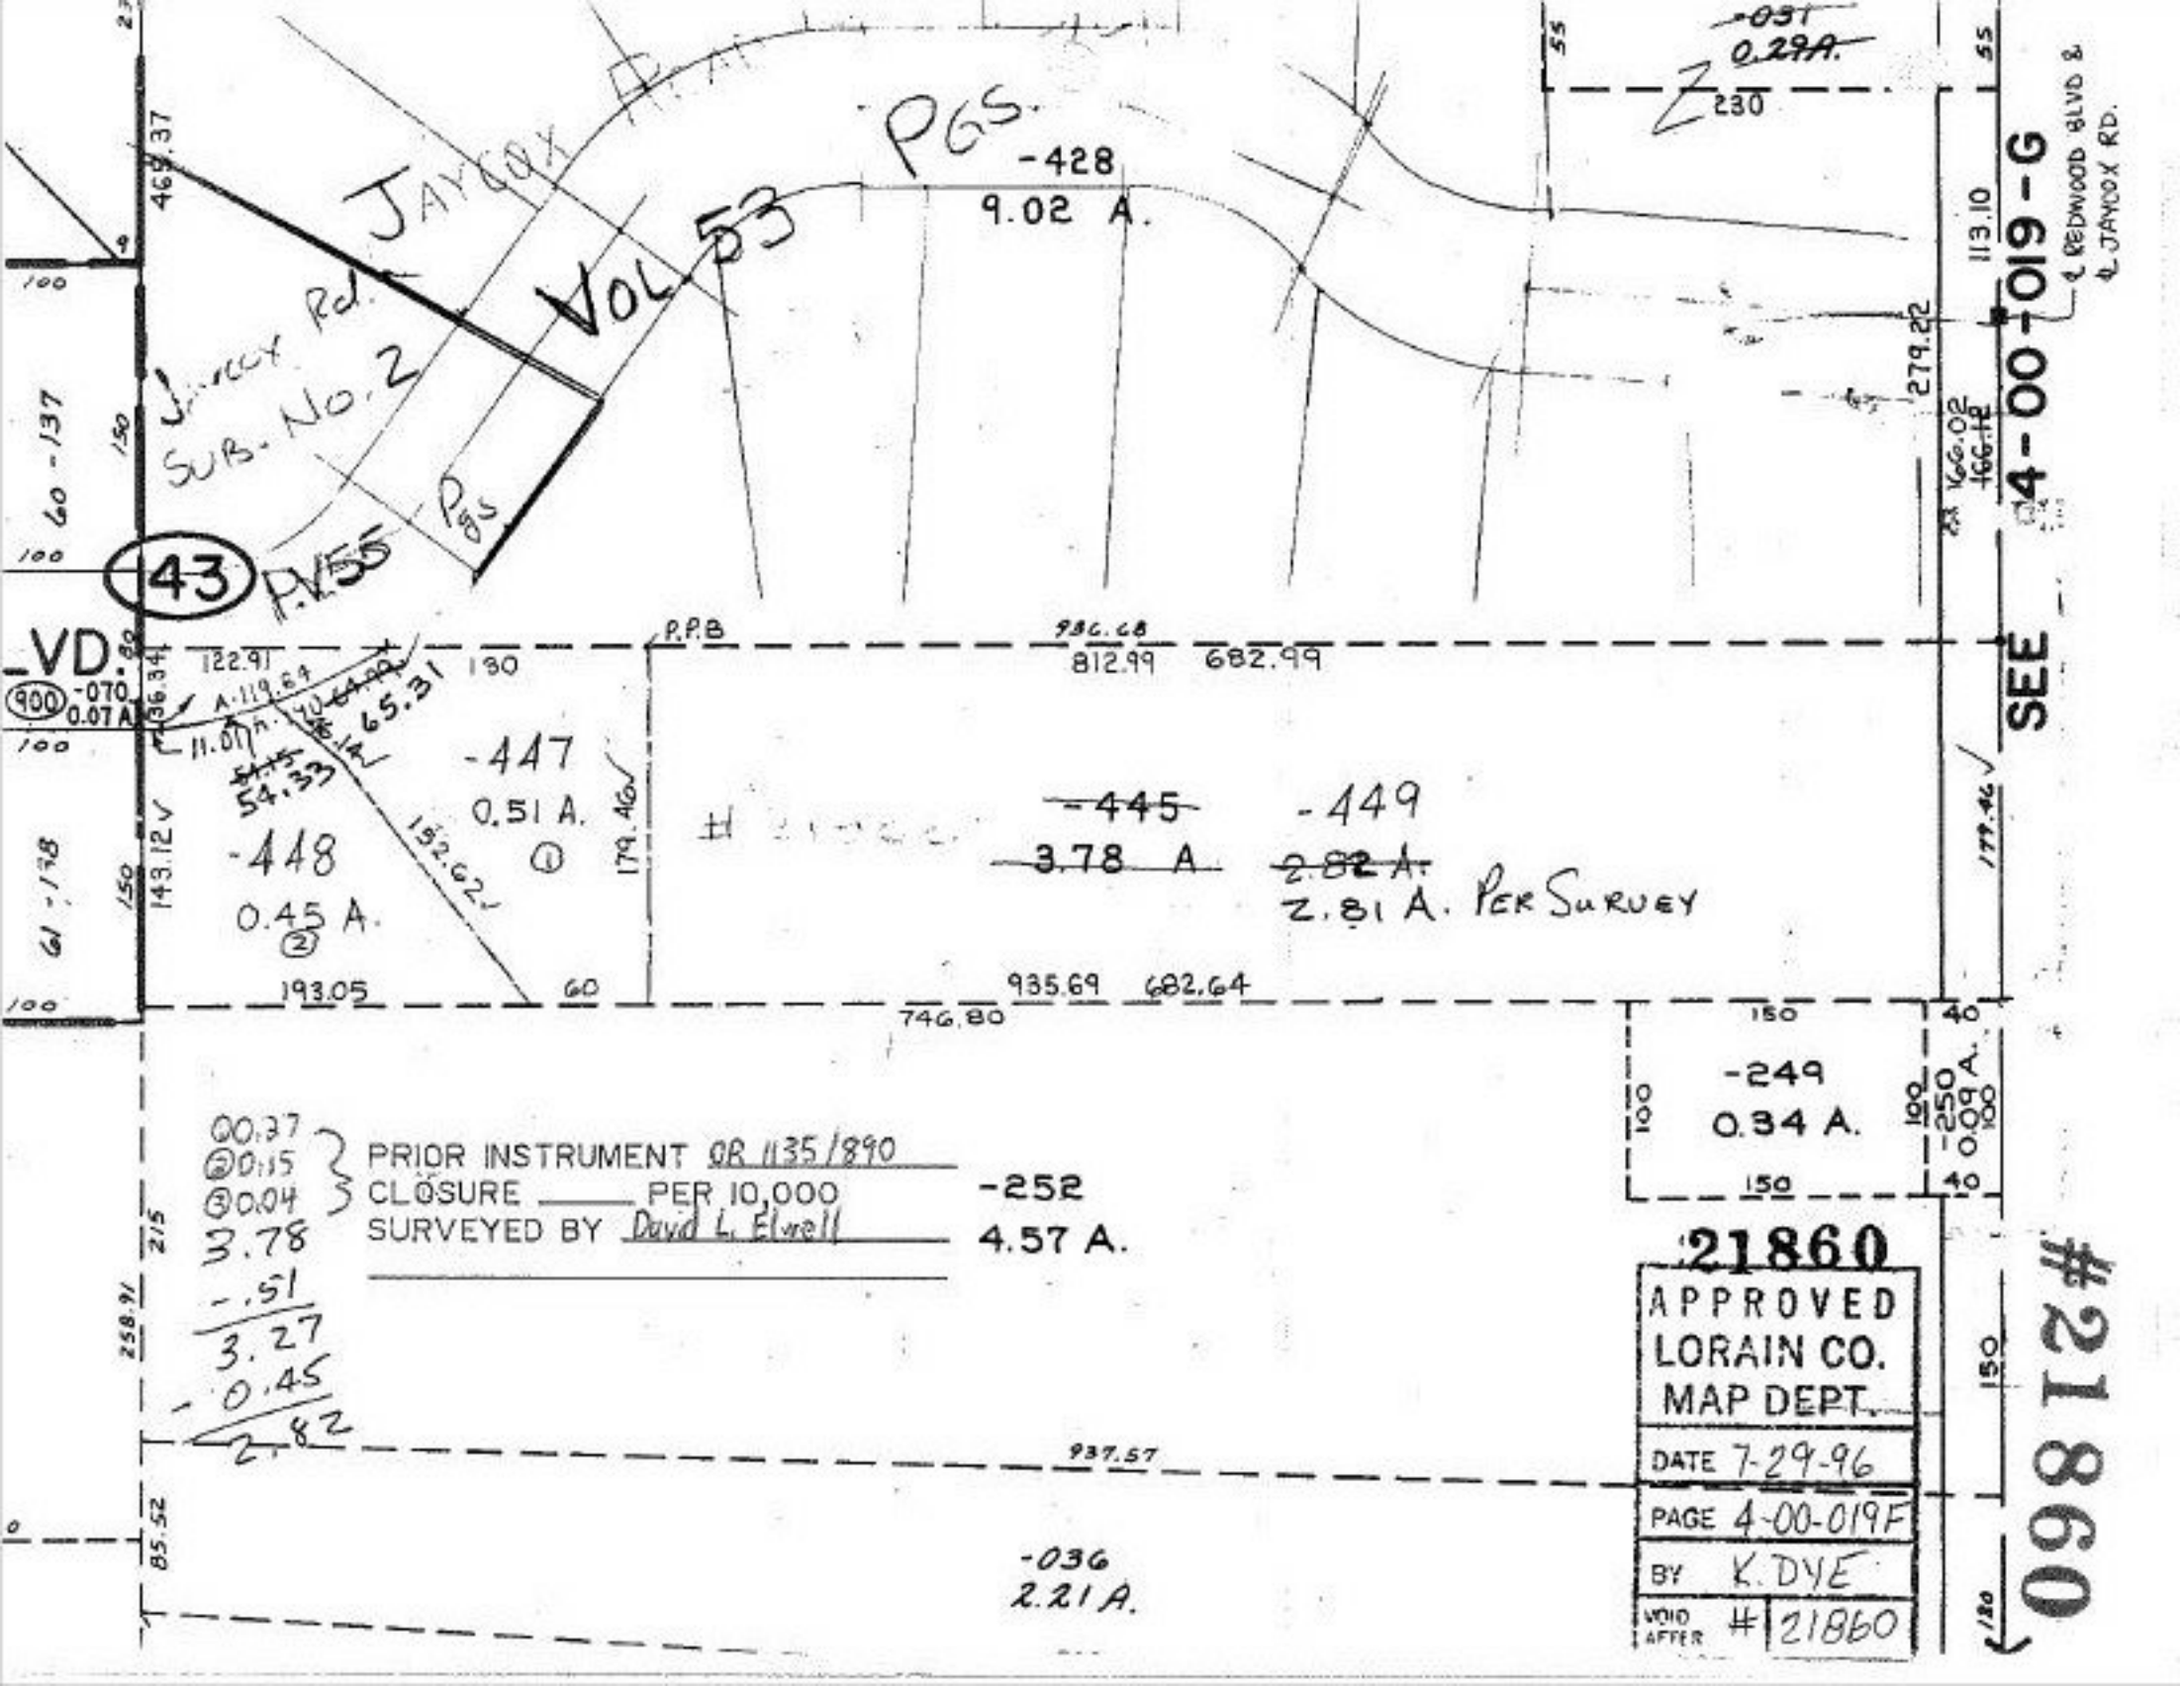
JAYCOX RD.
SUB. NO. 2
VOL 53 PGS.
PVS
PGS
43
-428
9.02 A.
-VD
-070
0.07 A.
-447
0.51 A.
-448
0.45 A.
-445
3.78 A
-449
2.82 A.
2.81 A. PER SURVEY
-249
0.34 A.
-250
0.09 A.
-252
4.57 A.
-036
2.21 A.
P.P.B
SEE 4-00-019-G
REDWOOD BLVD & JAYCOX RD.
PRIOR INSTRUMENT OR 1135/890
CLOSURE ____ PER 10,000
SURVEYED BY David L. Elwell
00.37
@0.15
@0.04
3.78
-.51
3.27
-0.45
2.82
21860
APPROVED
LORAIN CO.
MAP DEPT.
DATE 7-29-96
PAGE 4-00-019F
BY K. DYE
VOID AFTER # 21860
#21860