#21869

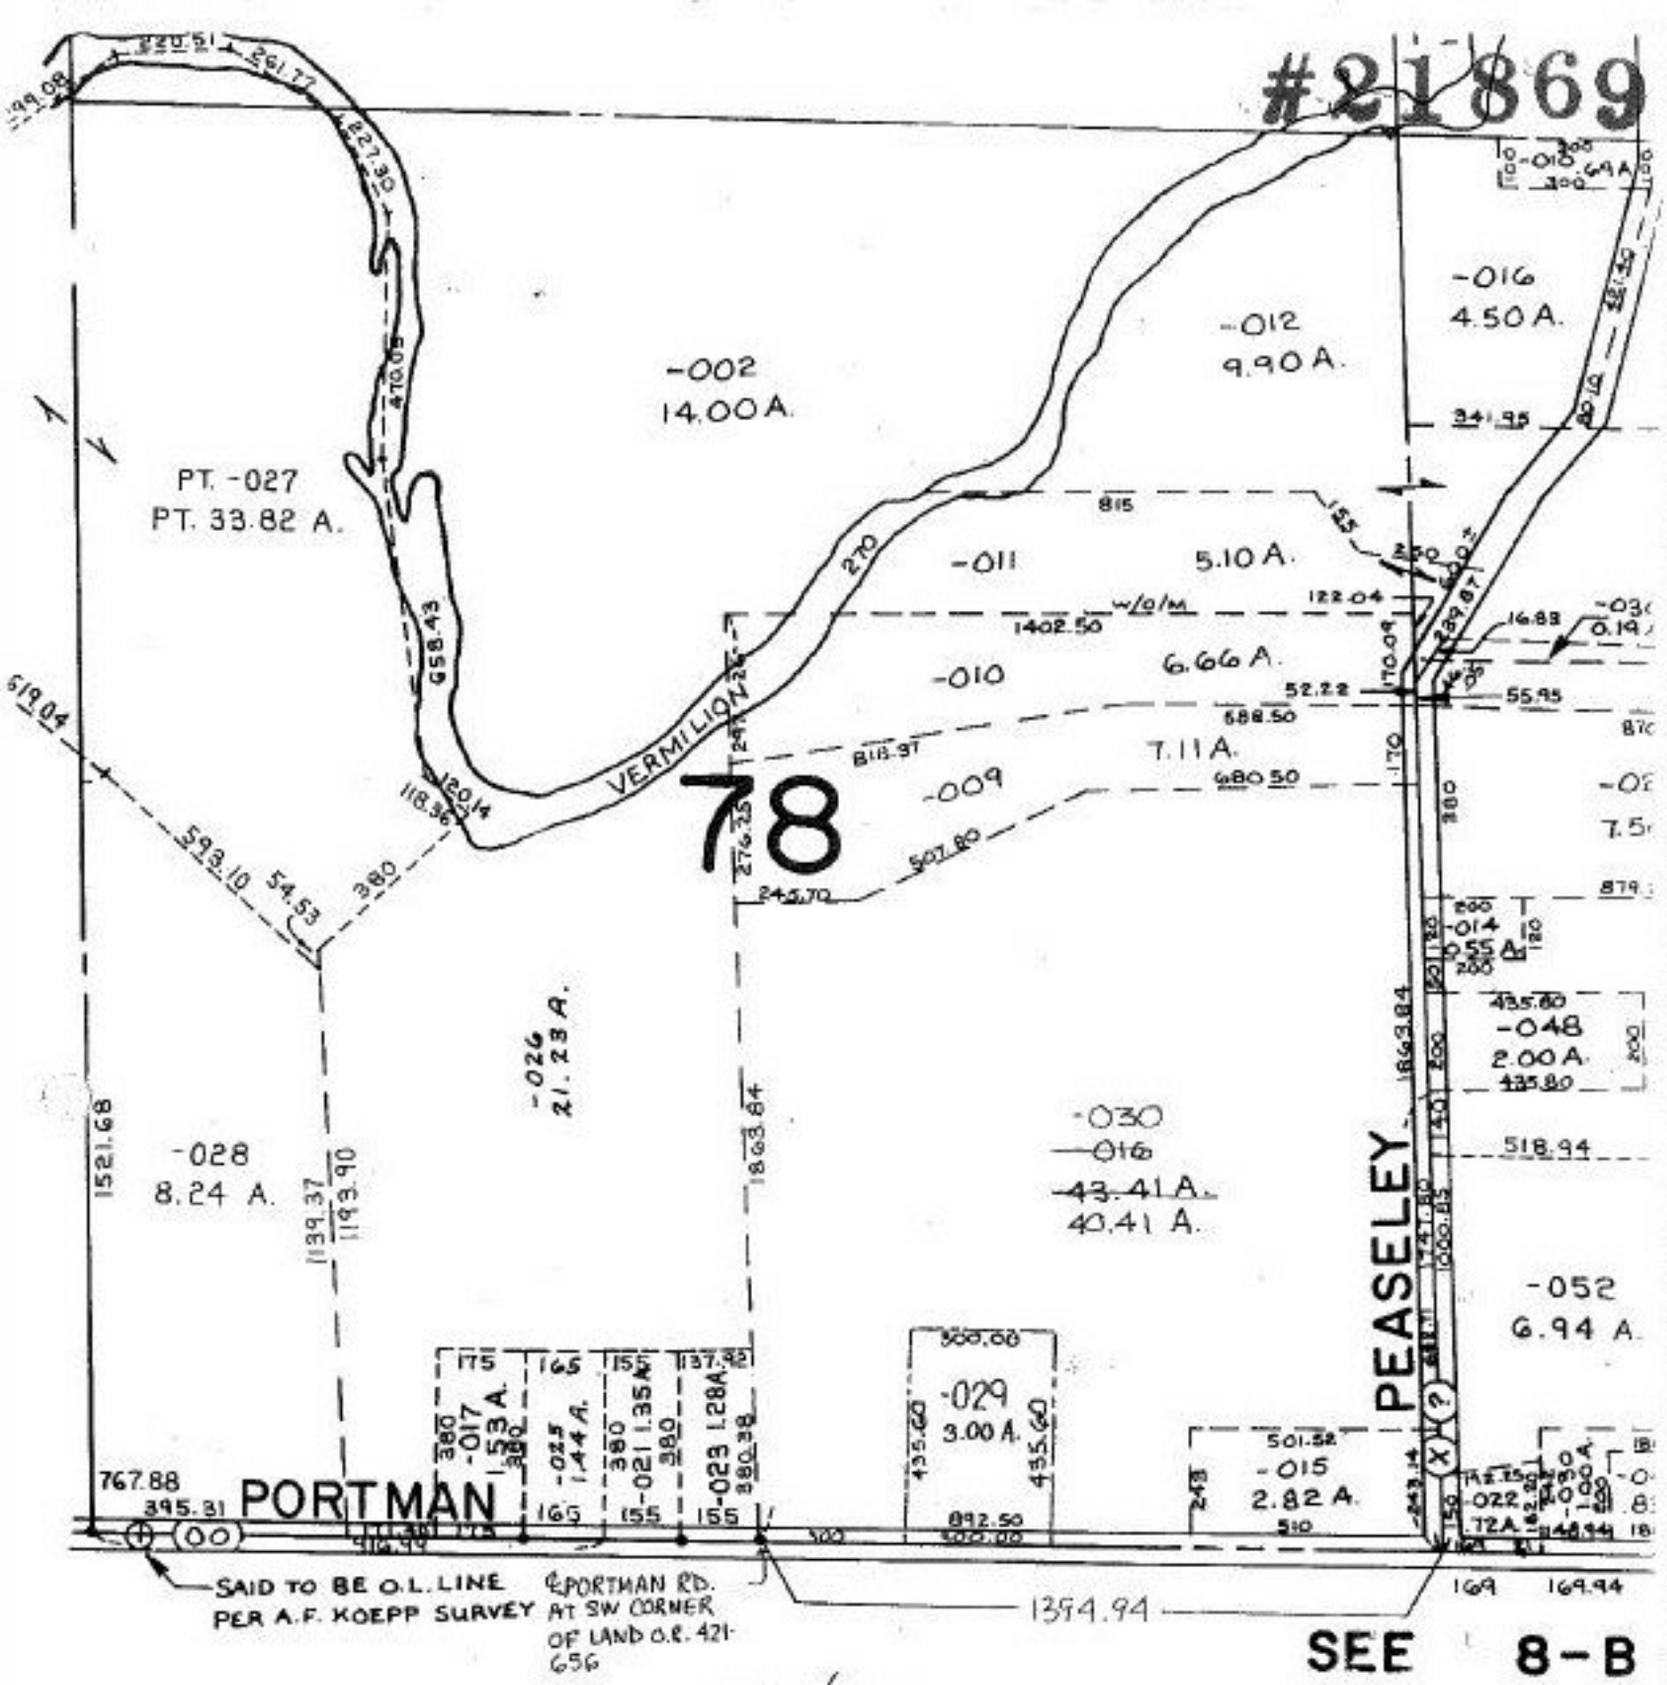

SEE 8-B

PRIOR INSTRUMENT 995/471
CLOSURE 0.00 PER 10,000
SURVEYED BY K.E. McCARTNEY & ASSOC.

21869

APPROVED
LORAIN CO.
MAP DEPT.
DATE 8-12-96
PAGE 1-J
BY K. DYE
VOL. #21869