#21872

REVISED
12-20-95

PITTSFIELD TWP.

SCALE 1" = 400'

14-G

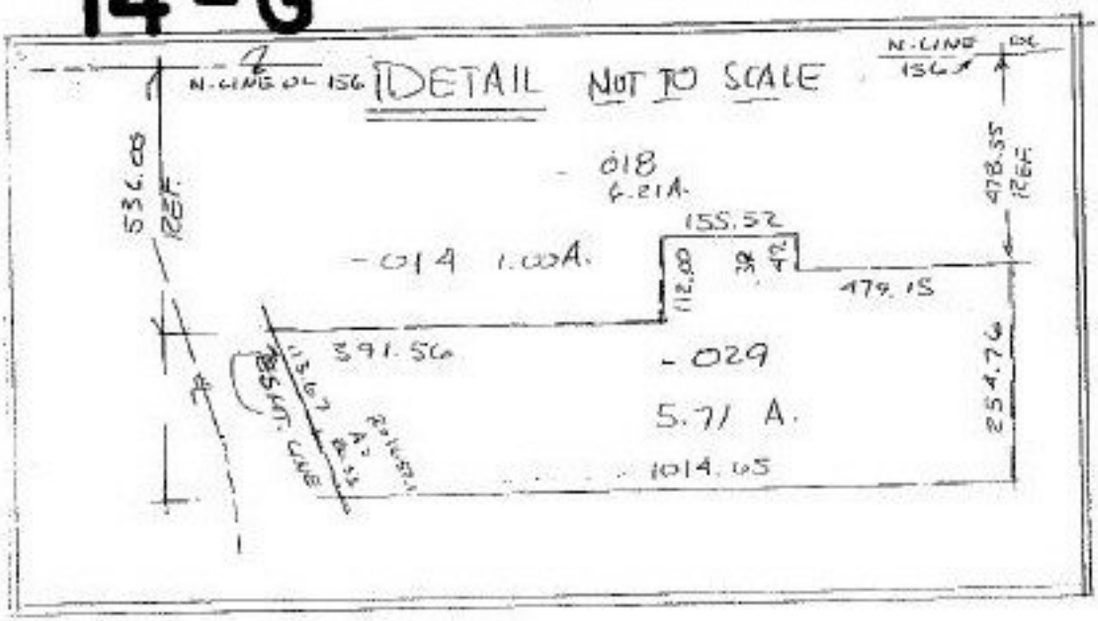

#21872

APPROVED
LORAIN CO.
MAP DEPT.

DATE 8-1-96
PAGE 14-G
BY K.DYE
VOID AFTER # 21872