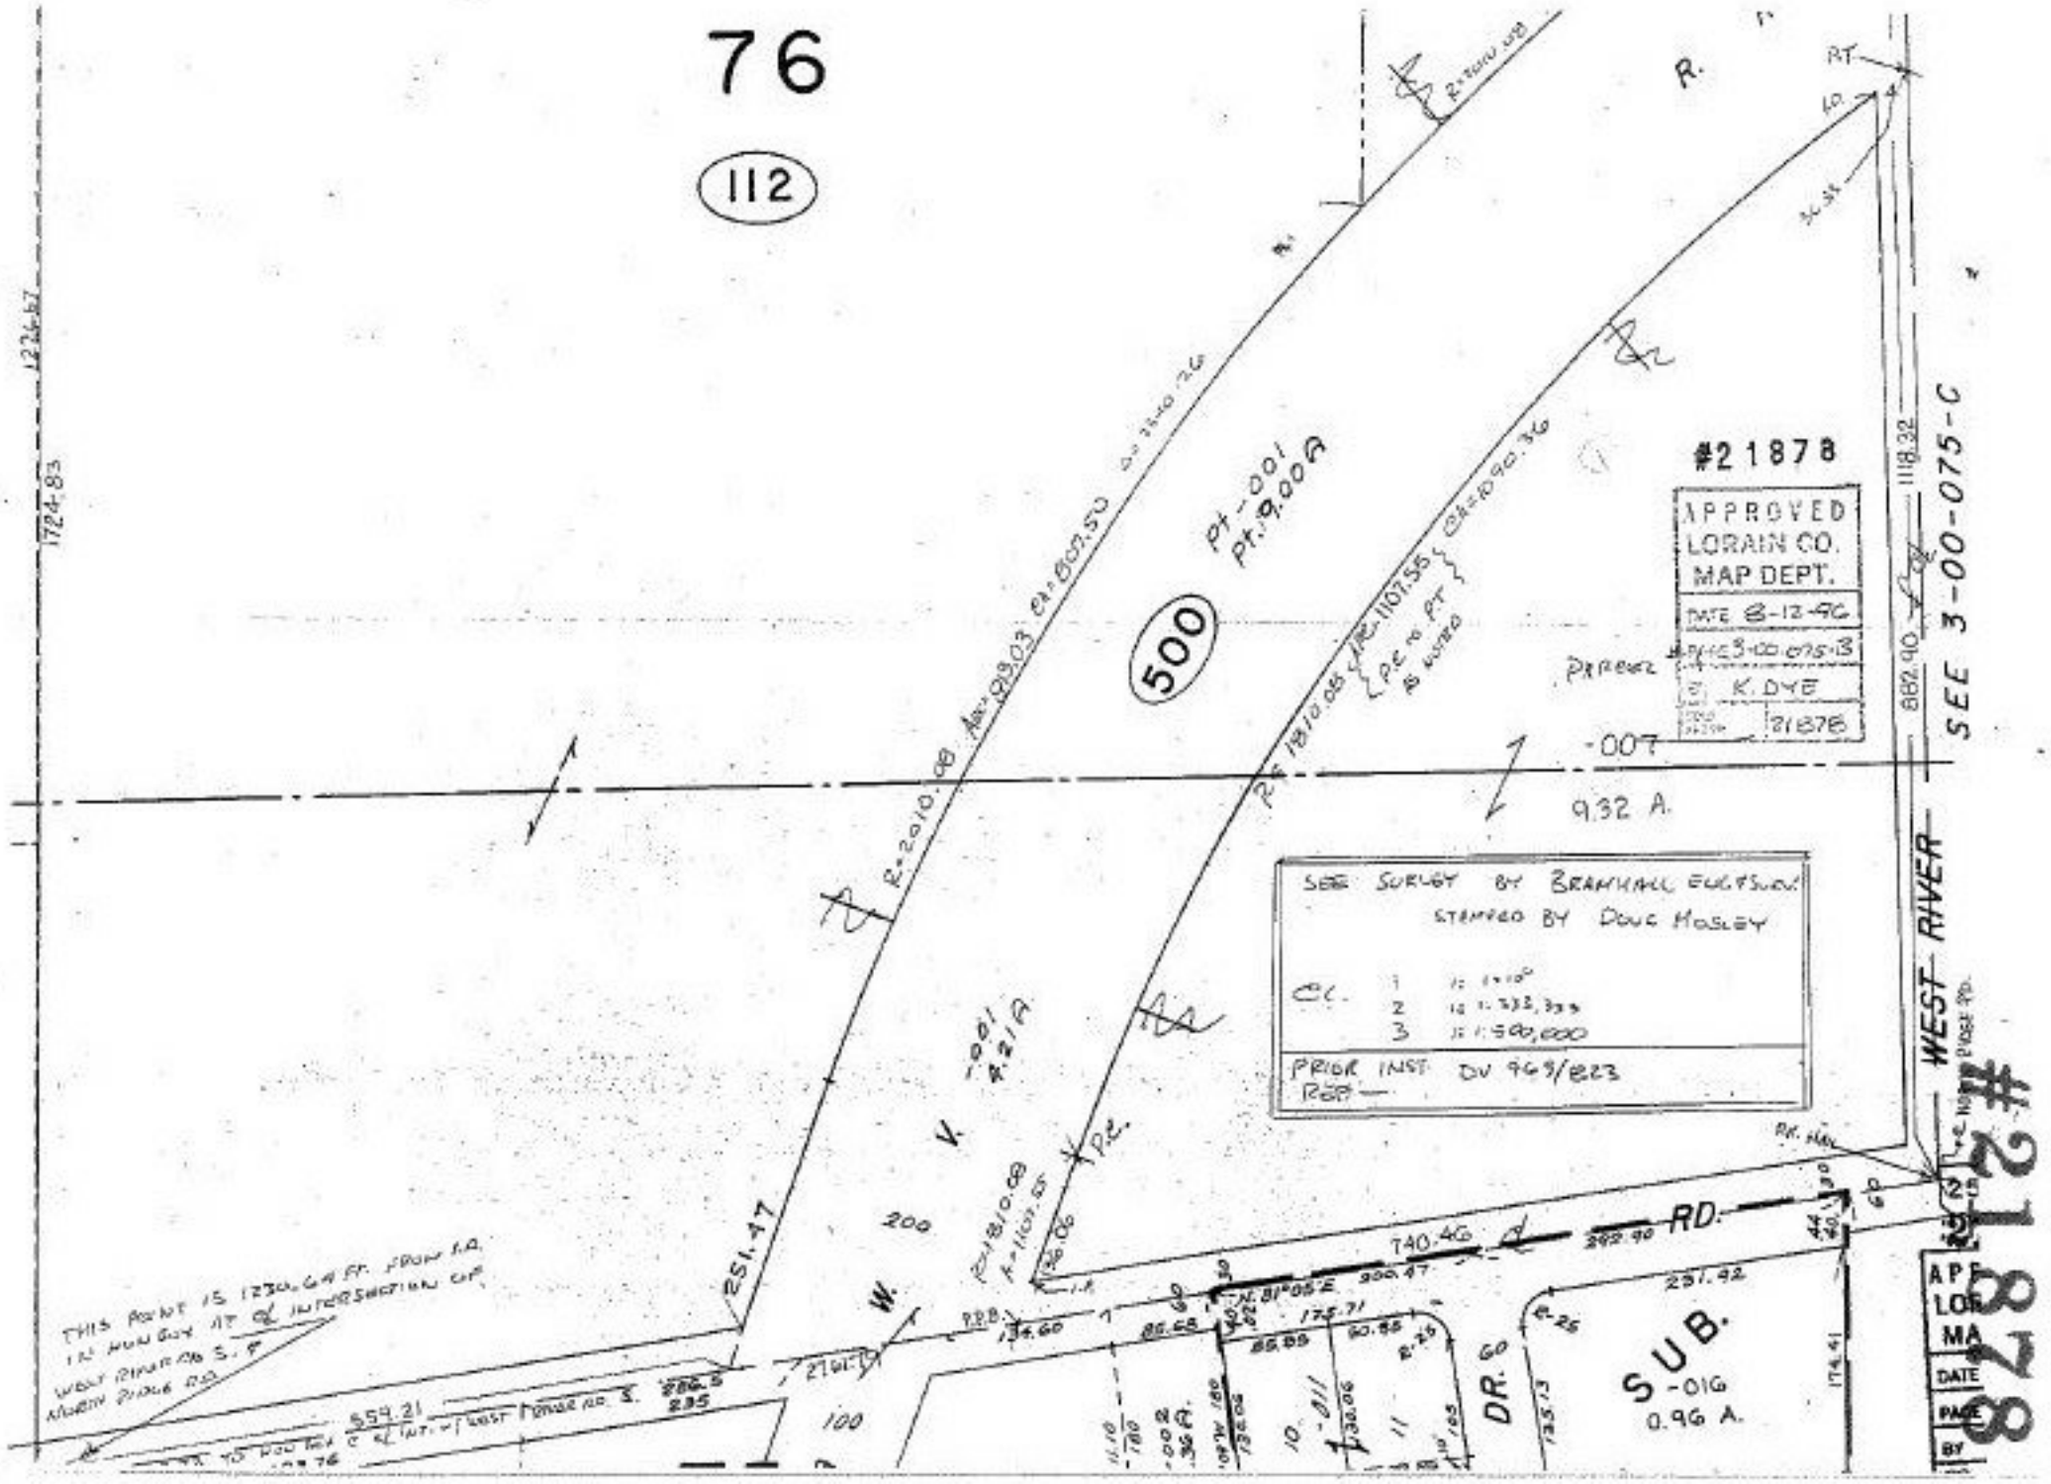
76
112
500
#21878
APPROVED
LORAIN CO.
MAP DEPT.
DATE 8-12-96
3-00 075-13
K. DYE
21878
SEE 3-00-075-C
WEST RIVER RD.
-007
9.32 A.
-001
4.21 A.
-002
.36 A.
SUB.
-016
0.96 A.
SEE SURVEY BY BRAINHALL EVERSON
STAMPED BY DOUG MOSLEY
PRIOR INST. REF. — DV 969/823
P.O.B.
P.O.C.
P.T.
P.C.
R=2010.08
R=1810.08
R=1107.55
DR. 60
RD. 60
251.47
740.46
882.90
1118.32
1724.83
1234.67
559.21
134.60
175.71
200.47
251.42
135.13
174.41
APPROVED
LORAIN CO.
MAP DEPT.
DATE
PAGE
BY
8212 #