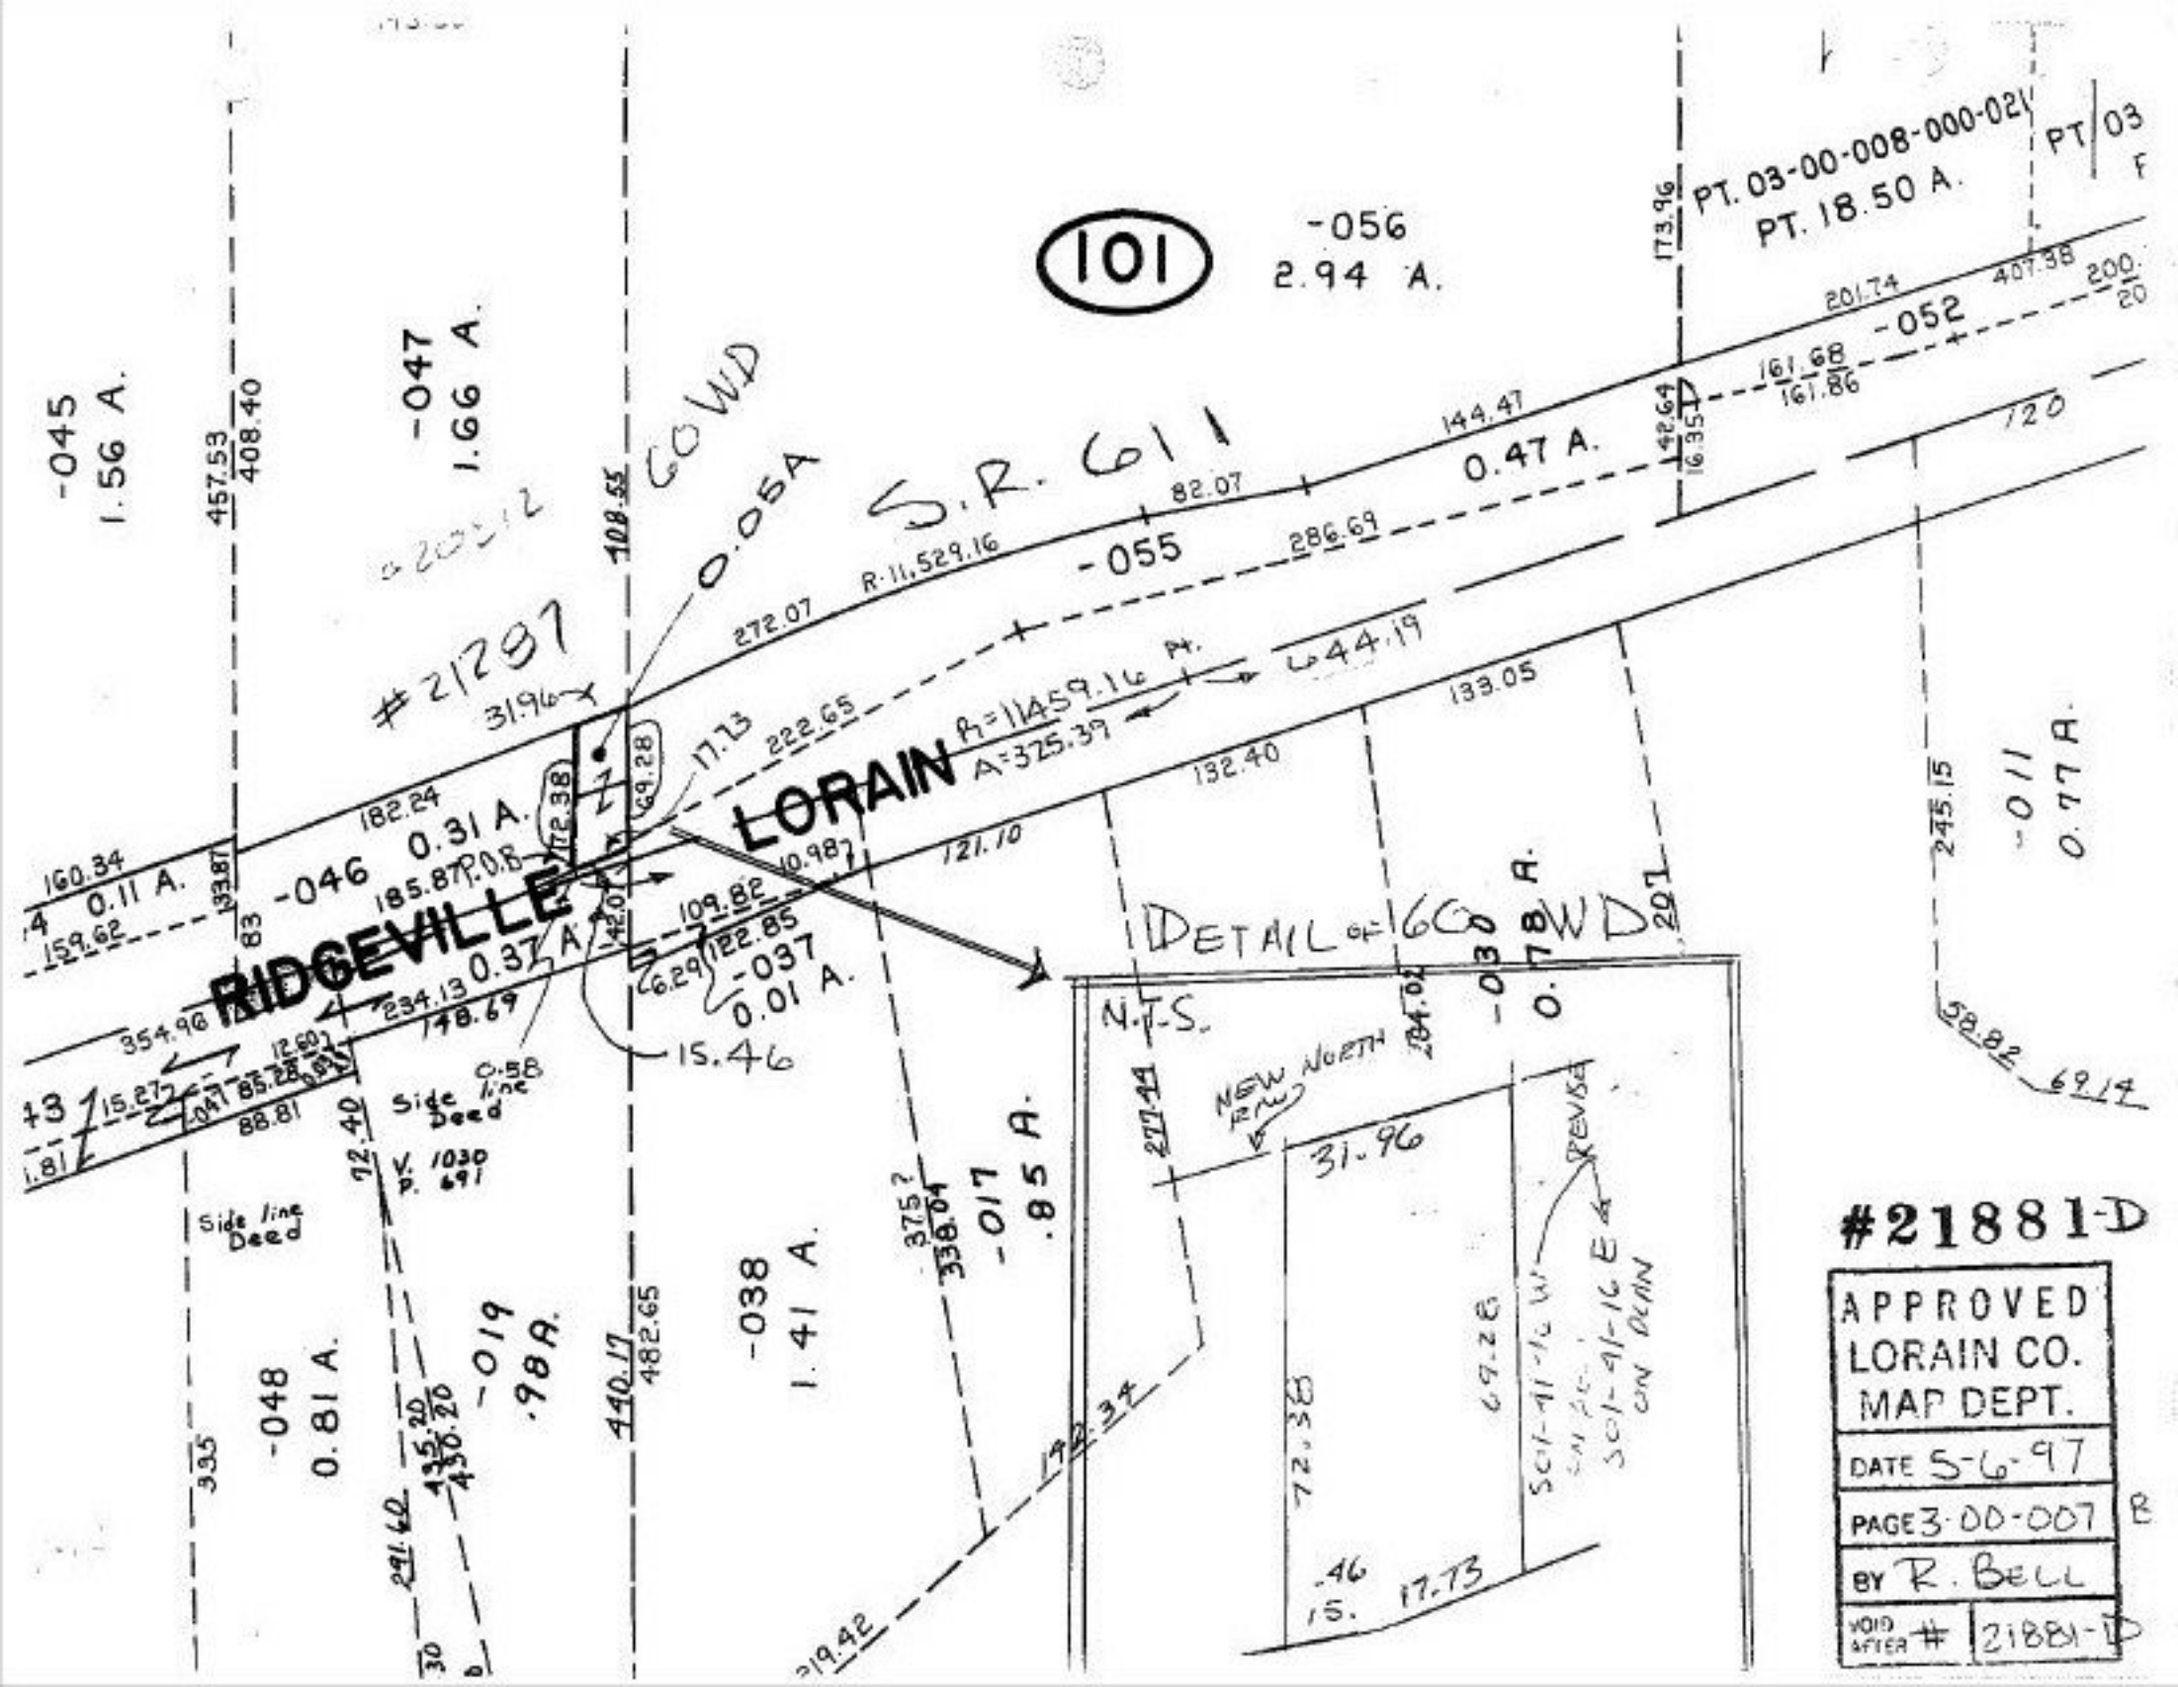
101
-056
2.94 A.
PT. 03-00-008-000-021
PT. 18.50 A.
PT 03
F
-045
1.56 A.
-047
1.66 A.
#21297
0.05A
CO WD
S.R. 611
-055
0.47 A.
-052
-046
0.11 A.
0.31 A.
RIDGEVILLE
LORAIN
R=11459.16
A=325.39
-037
0.01 A.
0.37 A.
15.46
DETAIL OF 160 WD
N.T.S.
-030
0.78 A.
-011
0.77 A.
-038
1.41 A.
-017
.85 A.
-048
0.81 A.
-019
.98A.
NEW NORTH
REVISED
#21881-D
APPROVED
LORAIN CO.
MAP DEPT.
DATE 5-6-97
PAGE 3-00-007
BY R. BELL
VOID AFTER # 21881-D