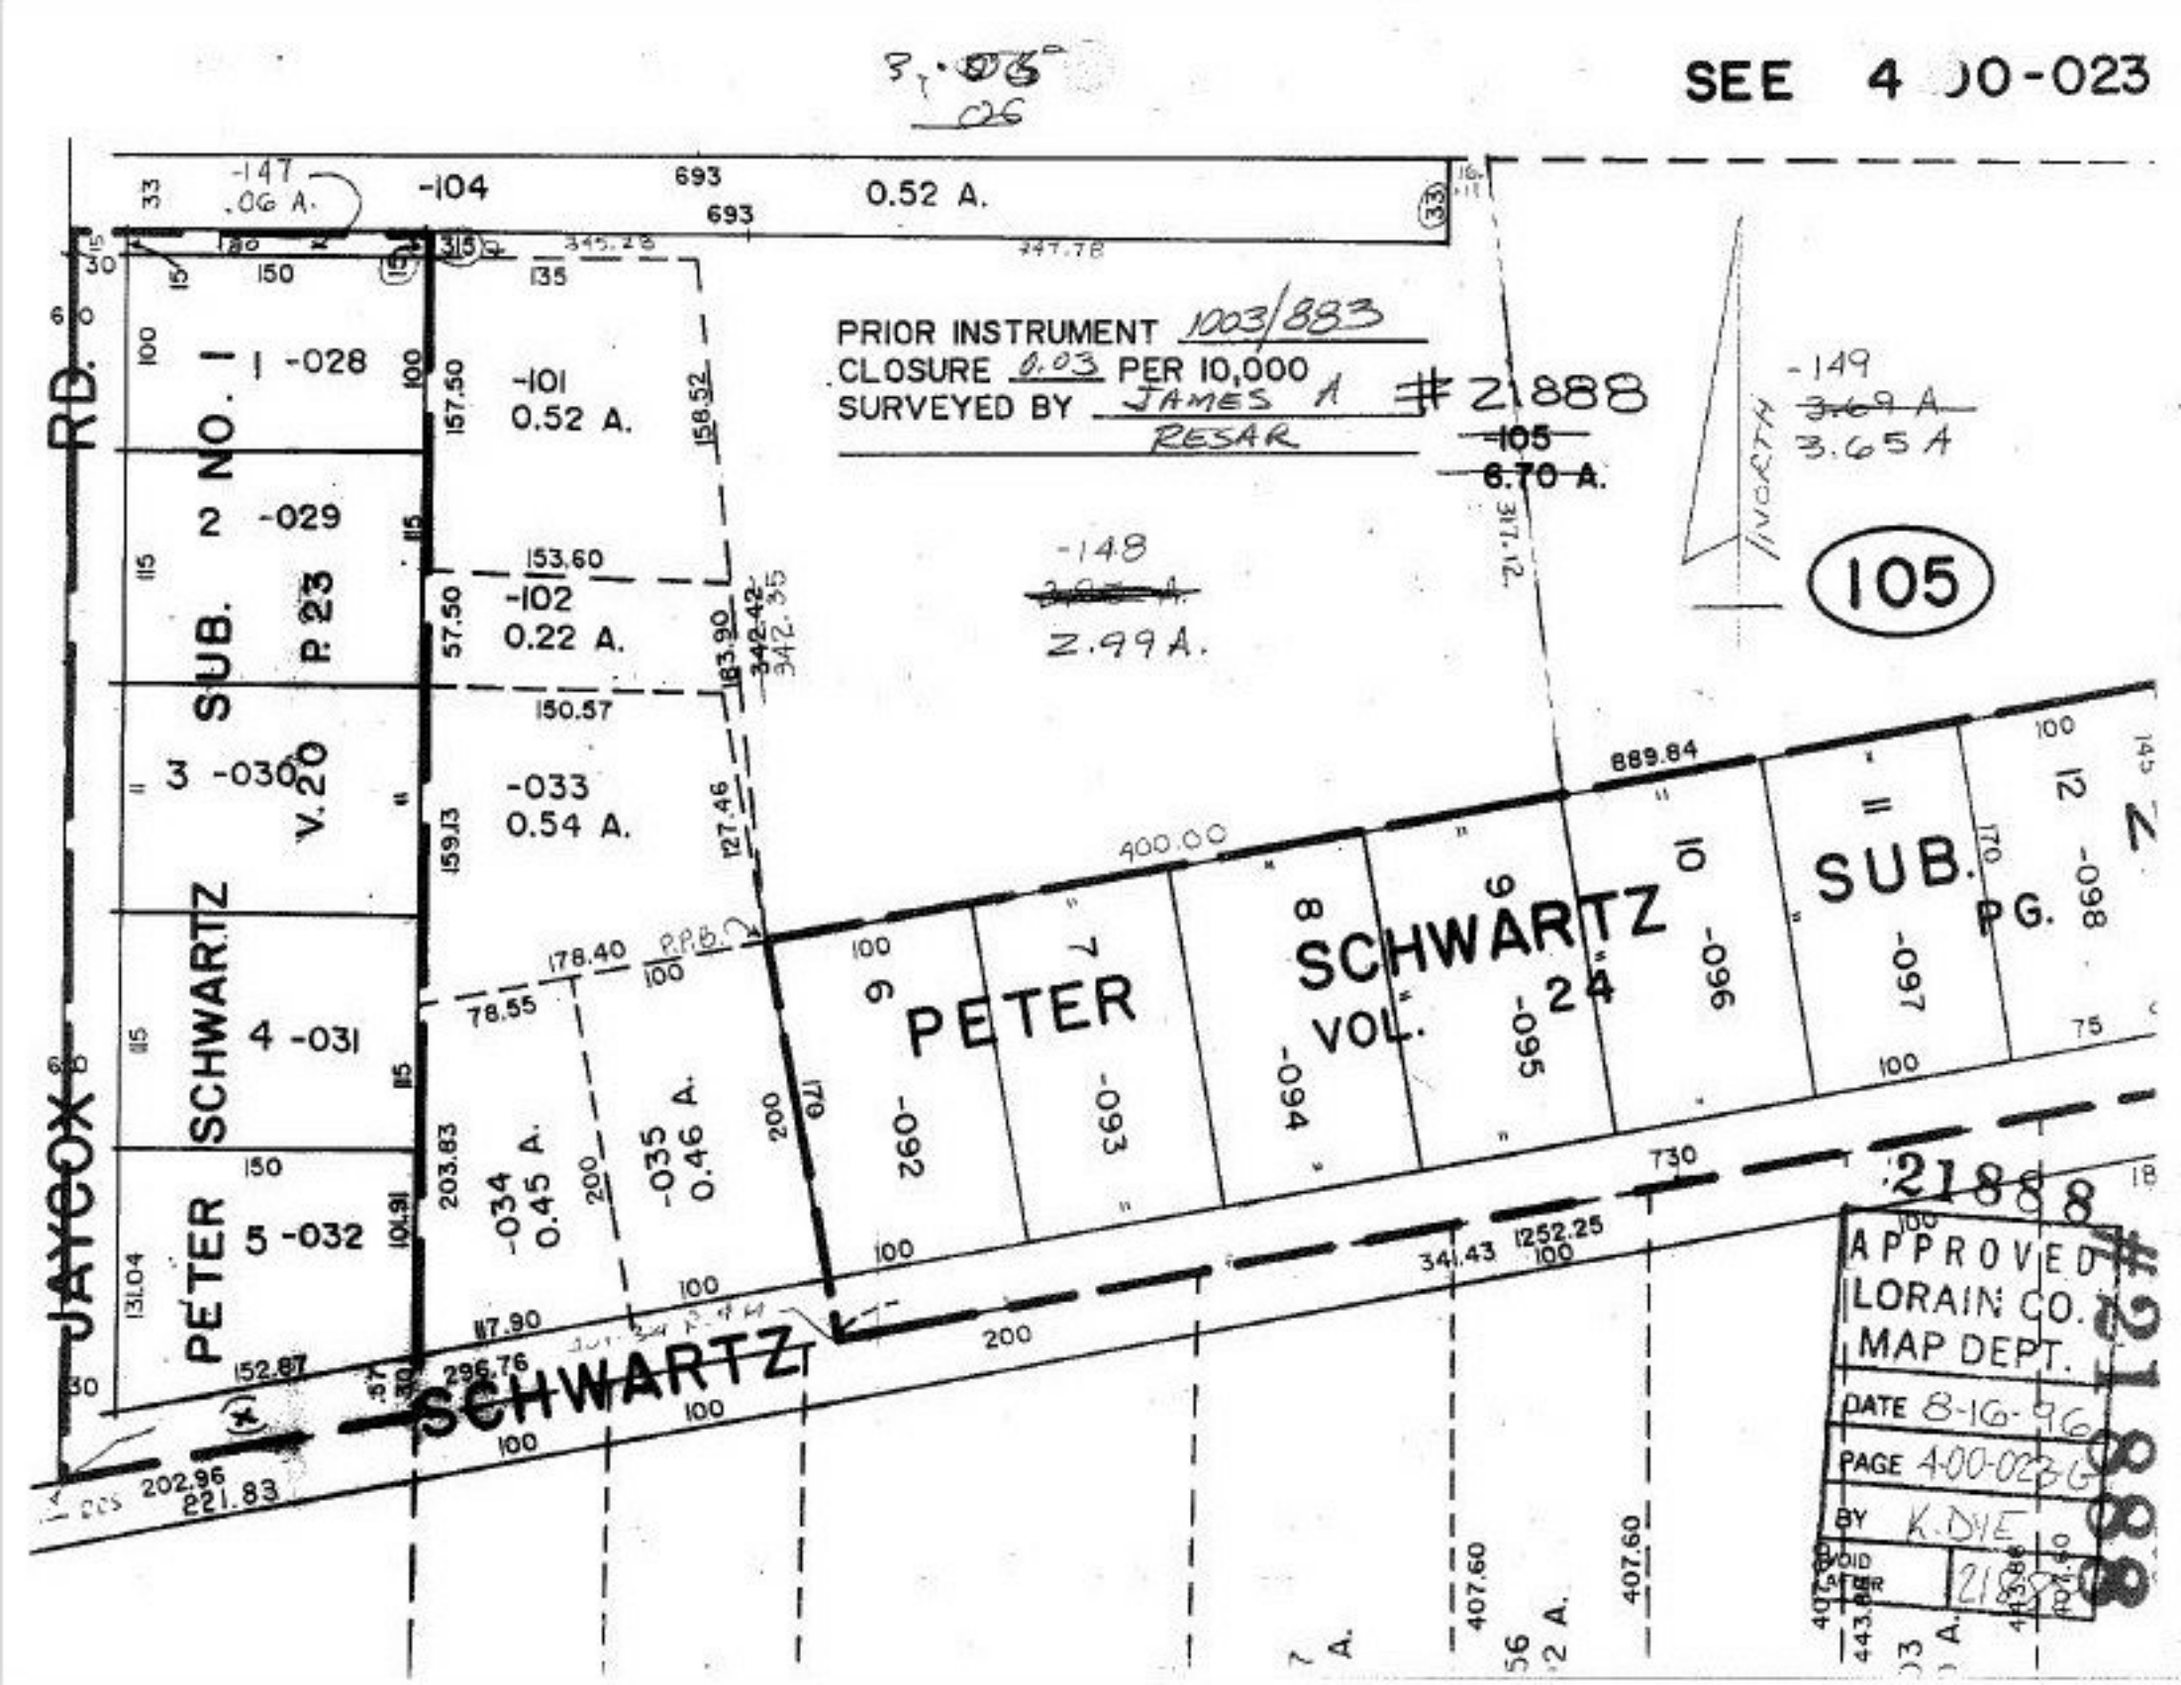
SEE 4 00-023
PRIOR INSTRUMENT 1003/883
CLOSURE 0.03 PER 10,000
SURVEYED BY JAMES A RESAR
#21888
105
6.70 A.
-149
3.65 A
-148
2.99 A.
-147
.06 A.
-104
0.52 A.
-101
0.52 A.
-102
0.22 A.
-033
0.54 A.
-034
0.45 A.
-035
0.46 A.
-028
-029
-030
-031
-032
SUB. NO. 1
SUB. P. 23
V. 20
PETER SCHWARTZ
PETER SCHWARTZ VOL. 24
SUB. P. G.
JAYCOX RD.
SCHWARTZ
NORTH
693
693
0.52 A.
345.28
347.78
150
135
180
315
100
157.50
158.52
153.60
57.50
342.42
342.35
183.90
150.57
159.13
127.46
178.40
78.55
P.O.B.
203.83
200
178
889.84
400.00
100
730
341.43
1252.25
407.60
APPROVED
LORAIN CO.
MAP DEPT.
DATE 8-16-96
PAGE 4-00-023 G
BY K.DYE
VOID AFTER
21888
#21888