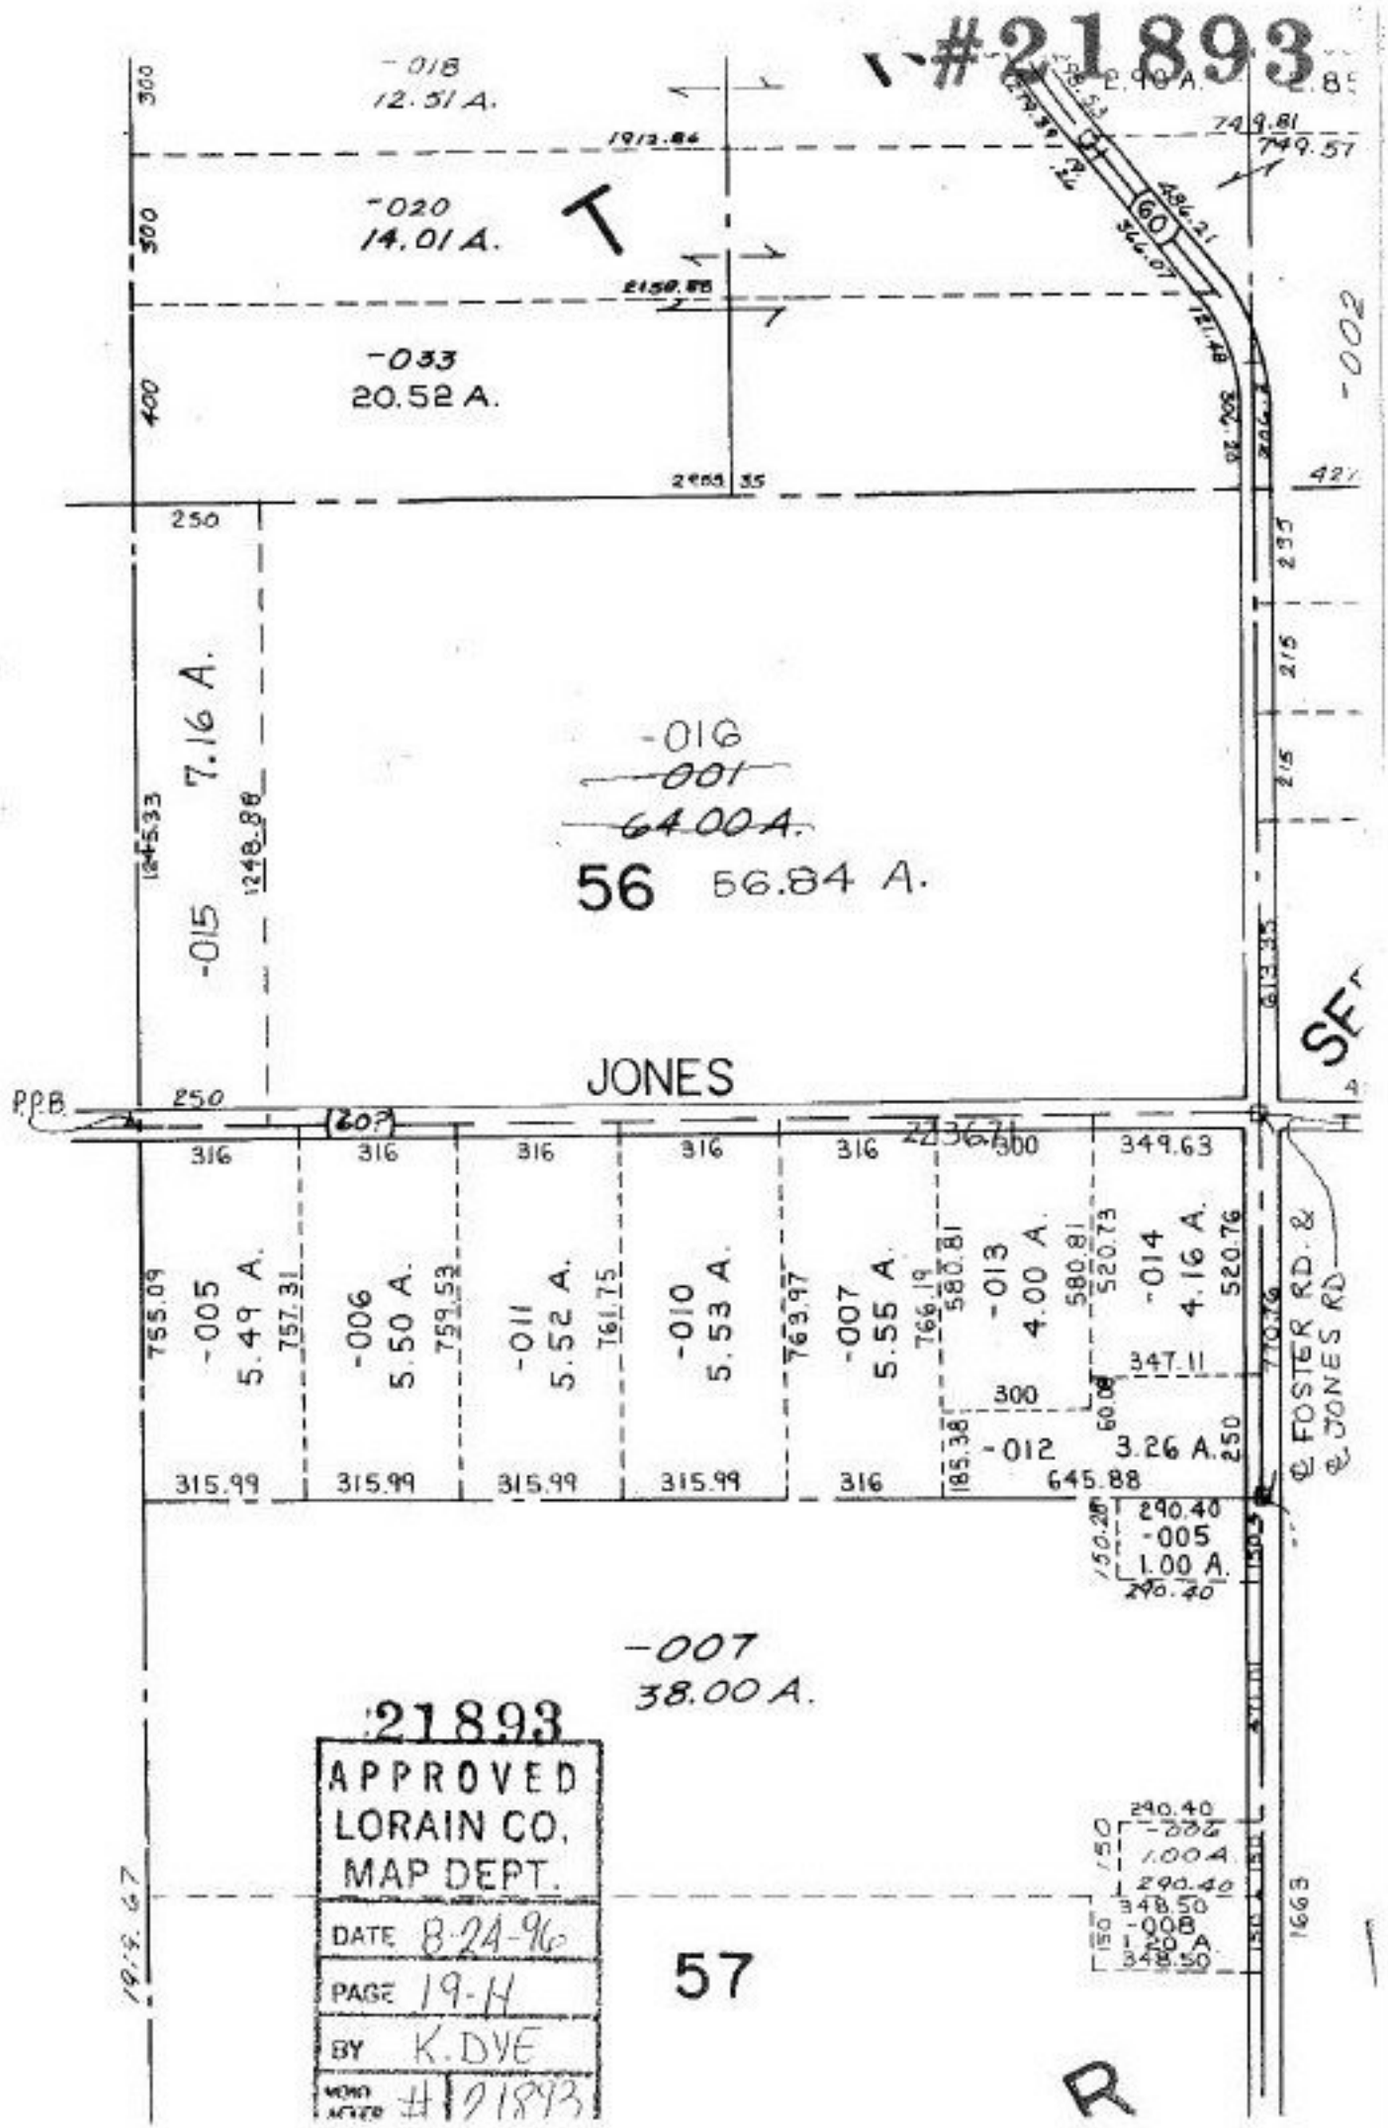
#21893
-018
12.51 A.
-020
14.01 A.
-033
20.52 A.
-002
-016
-001
64.00 A.
56 56.84 A.
-015
7.16 A.
JONES
PPB
-005
5.49 A.
-006
5.50 A.
-011
5.52 A.
-010
5.53 A.
-007
5.55 A.
-013
4.00 A.
-014
4.16 A.
-012
3.26 A.
-005
1.00 A.
-007
38.00 A.
-008
1.00 A.
57
FOSTER RD. & JONES RD
21893
APPROVED
LORAIN CO.
MAP DEPT.
DATE 8-24-96
PAGE 19-H
BY K.DYE
MAP SHEET # 21893