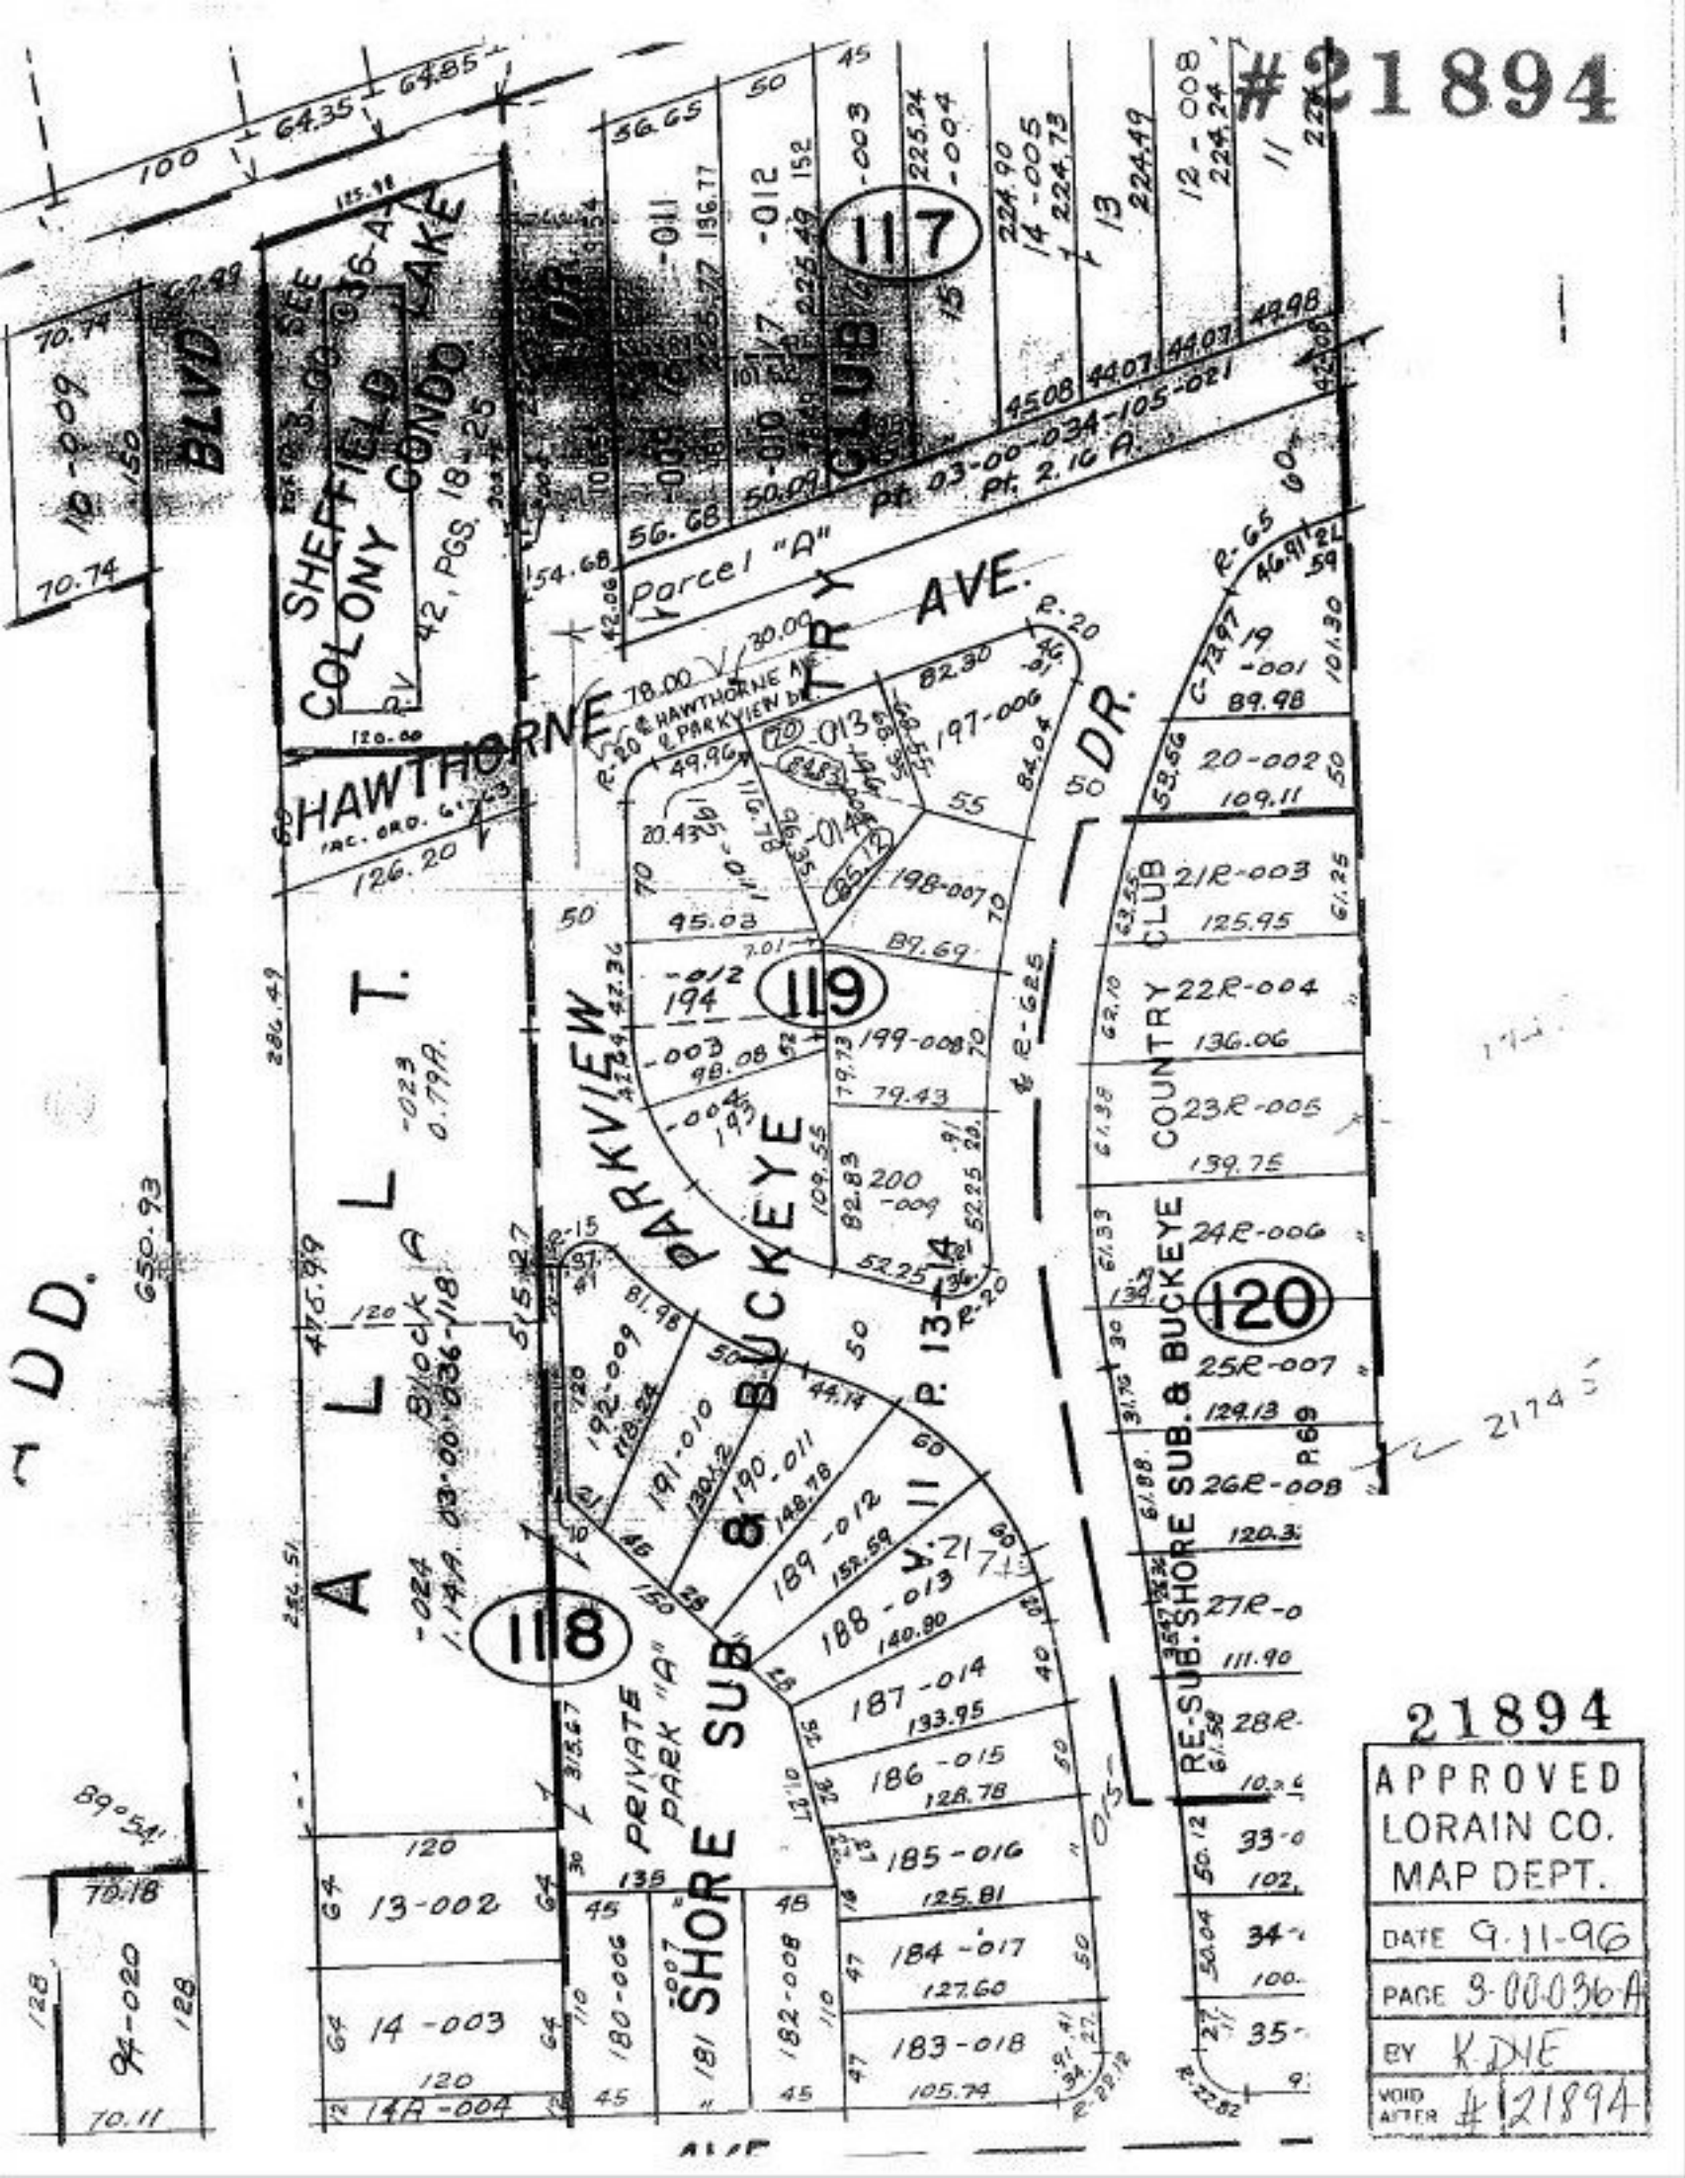
#21894
SHEFFIELD COLONY CONDO
42, PGS. 18-25
BLVD.
HAWTHORNE
IRC. ORD. 61-73
Parcel "A"
pt. 03-00-034-105-021
pt. 2.16 A.
PARKVIEW DR.
BUCKEYE COUNTRY CLUB
RE-SUB. SHORE SUB. & BUCKEYE
SHORE SUB. 8
PRIVATE PARK "A"
ALLOTT
Block A
03-00-036-118
1.149 A.
0.799 A.
117
118
119
120
APPROVED
LORAIN CO.
MAP DEPT.
DATE 9-11-96
PAGE 3-00036A
BY K.DHE
VOID AFTER #21894