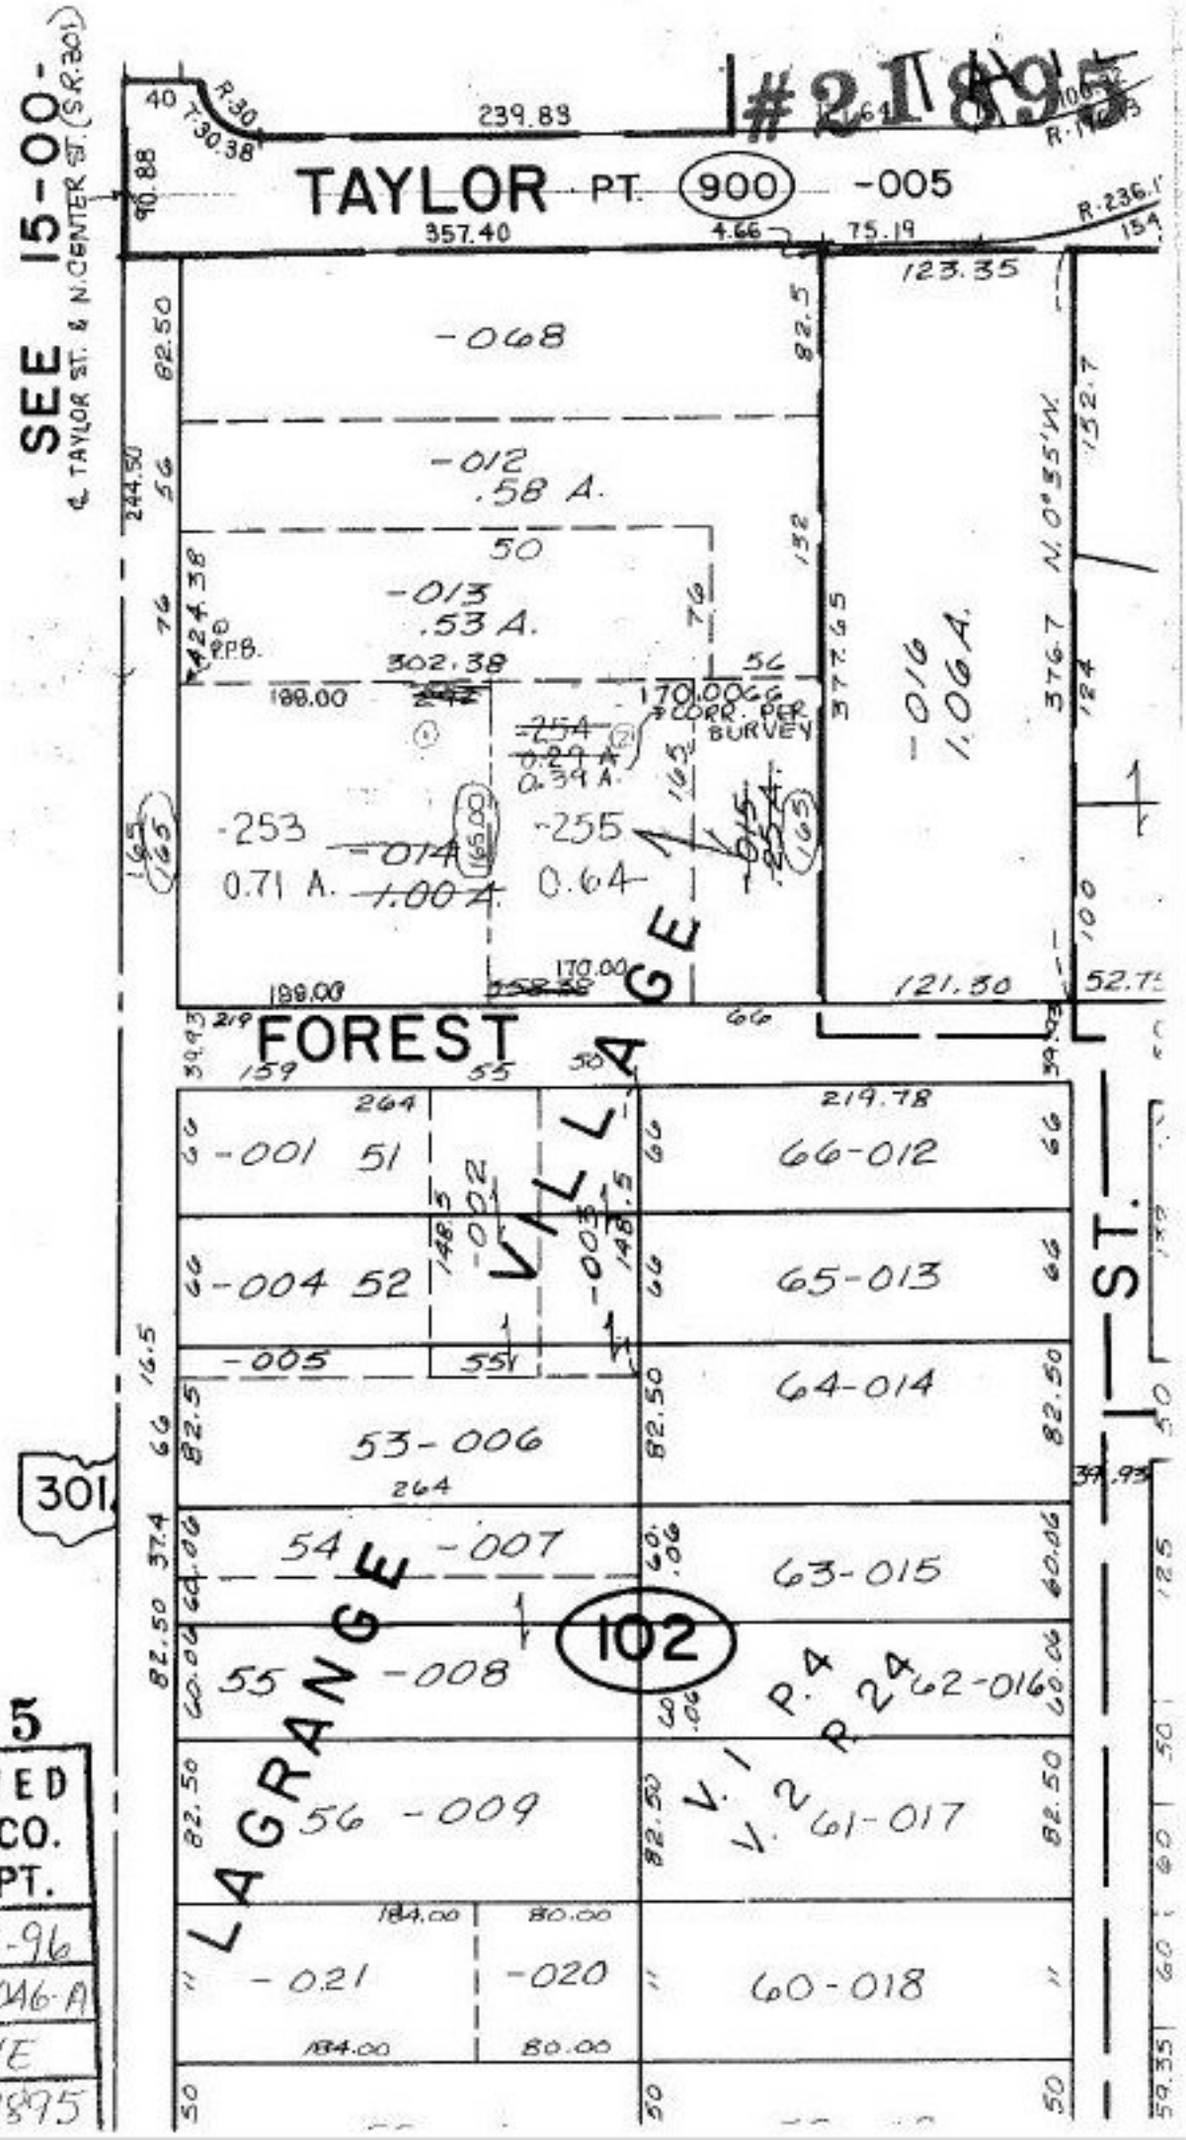

21895

APPROVED
LORAIN CO.
MAP DEPT.

DATE 8-23-96

PAGE 15-00-046-A

BY K. DYE

VOID AFTER # 21895