


2191

SEE 3-00-014-B

ABBE RD

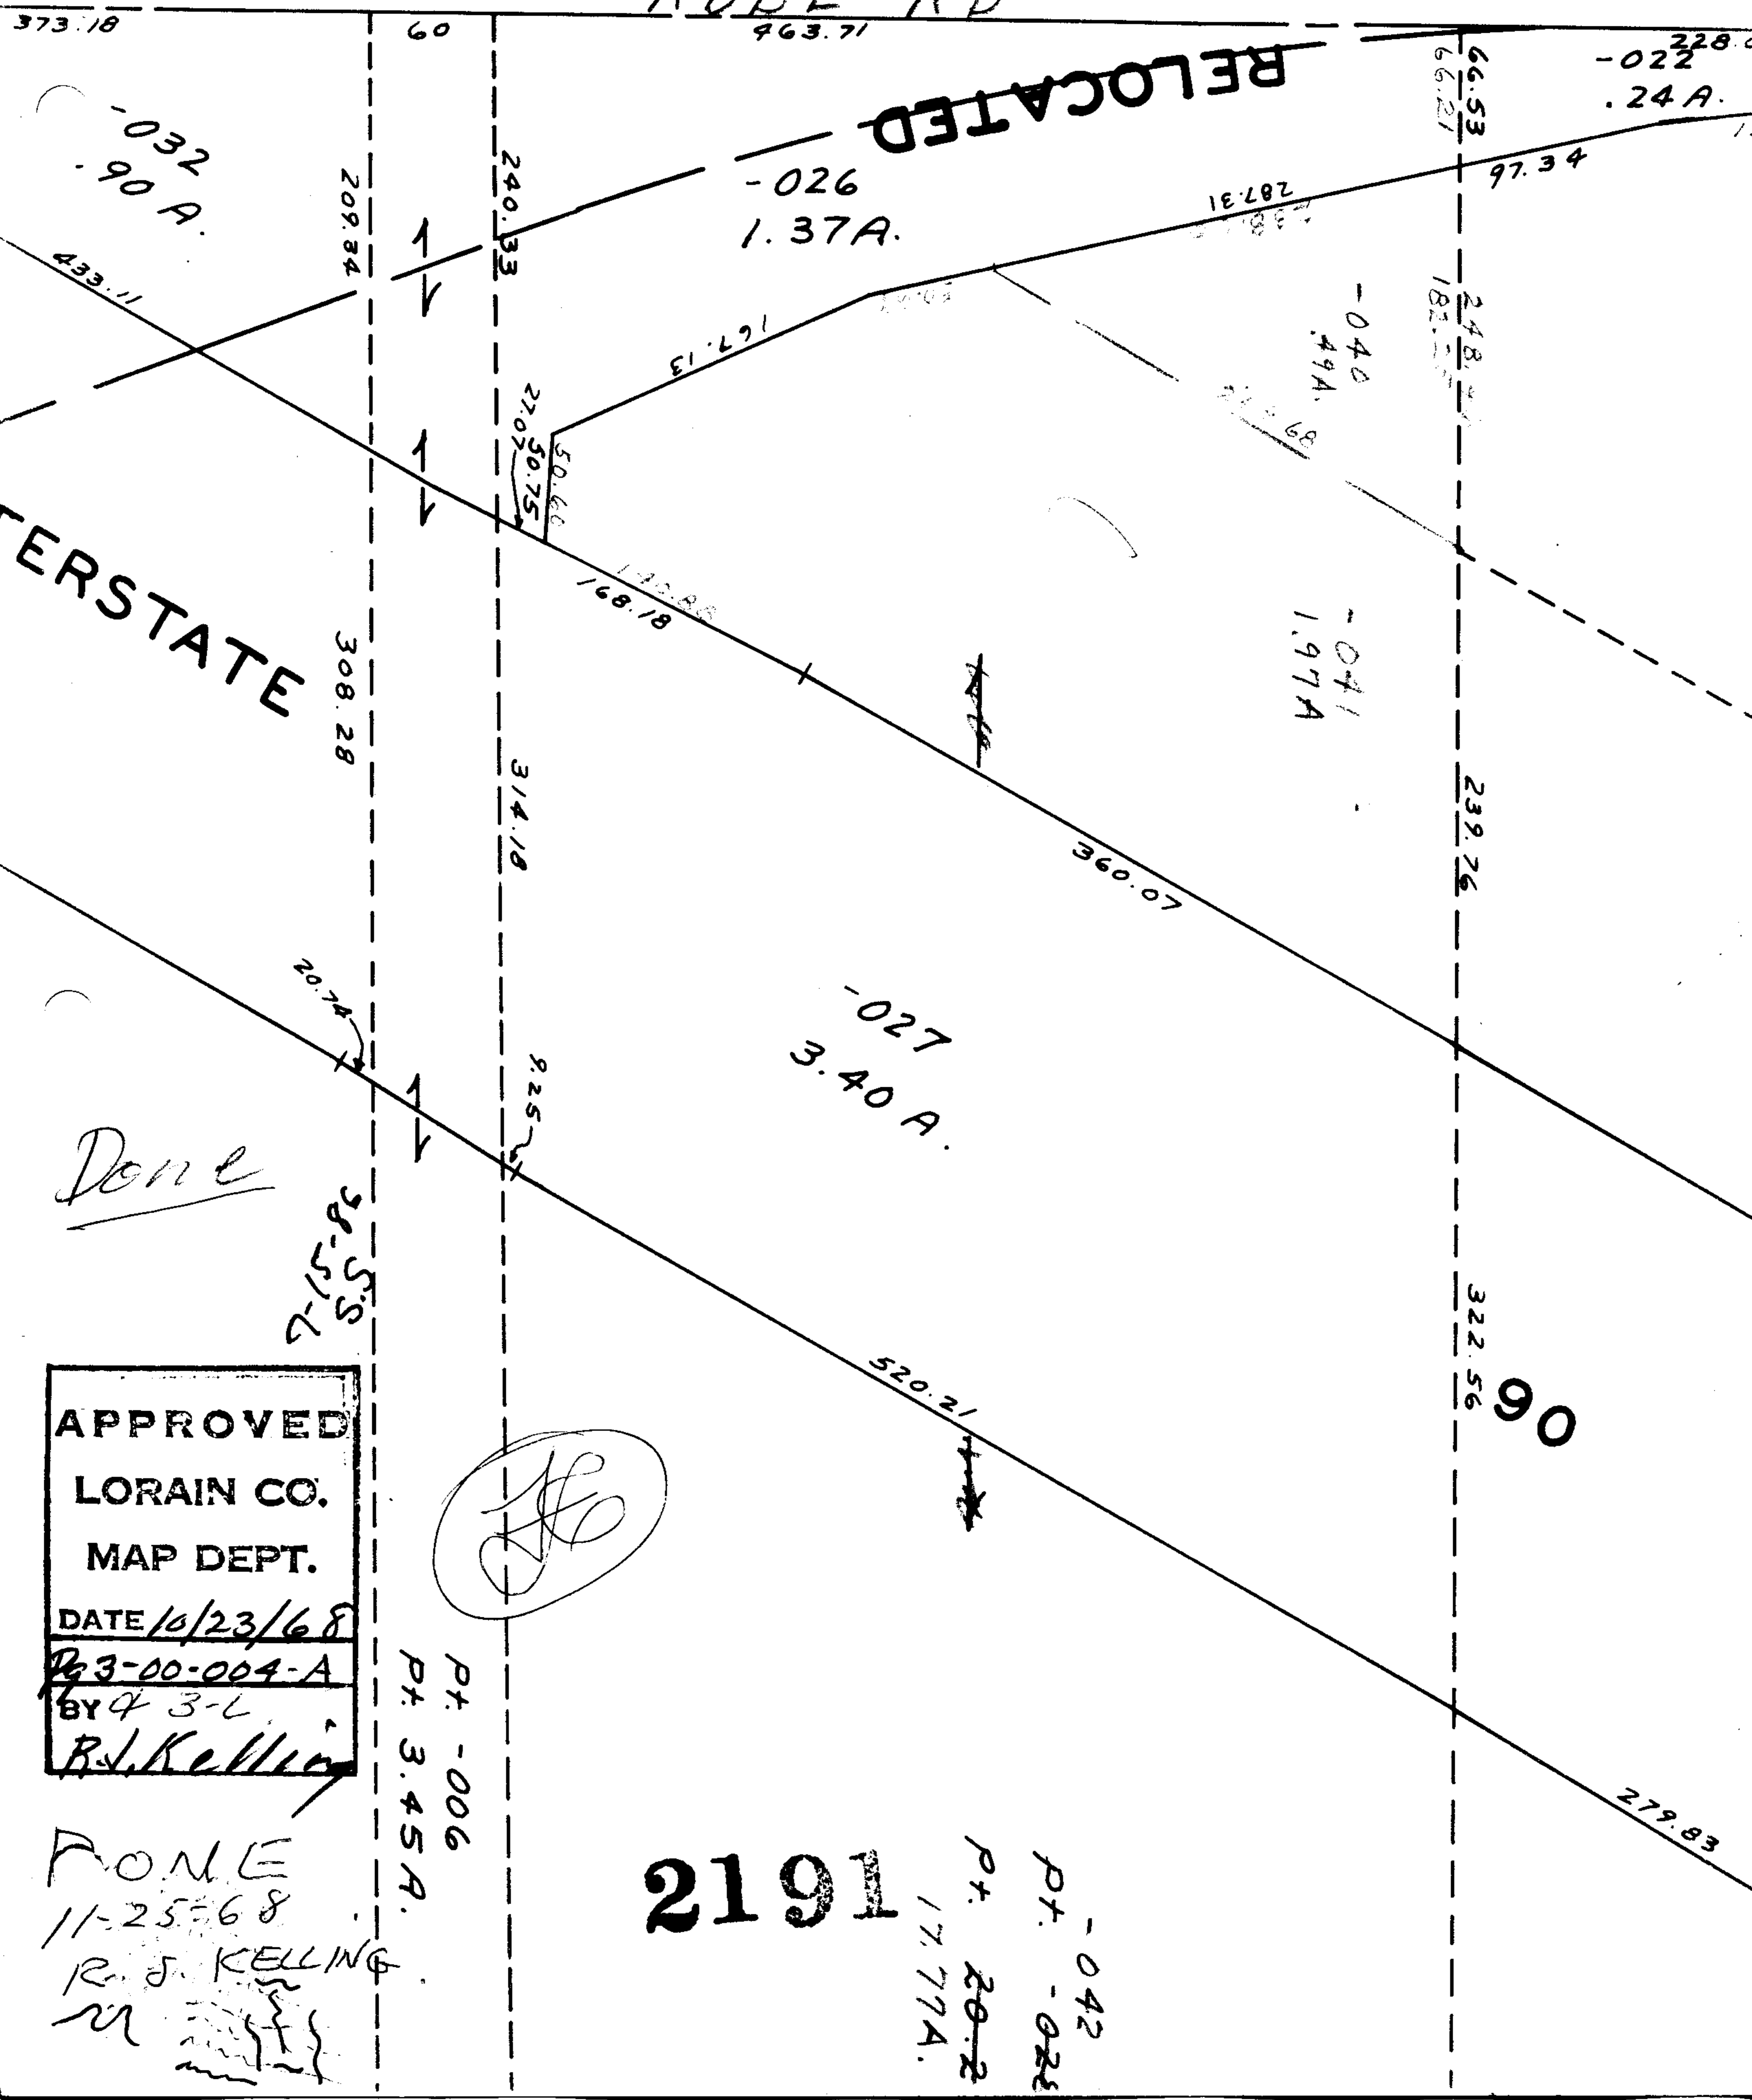

RELOCATED

-026  
1.37A.

-027  
3.40 A.

-040  
.49A.

-041  
1.97A

PT. -042

PT. ~~20.2~~  
17.77A.

PT. -006  
PT. 3.45A.

*[Signature]*

2191

INTERSTATE

*Done*

APPROVED  
LORAIN CO.  
MAP DEPT.  
DATE 10/23/68  
3-00-004-A  
BY 4 3-L  
R.J. Kelling

Done  
11-25-68  
R. J. KELLING  
*[Signature]*

38-5'S  
20.7A

60

279.83

322.56

239.76

248.21

66.53

228.0  
-022  
.24A.

97.34

287.31

360.07

520.21

142.88  
168.18

50.66  
27.05  
50.75

314.18

9.25

308.28

209.84

963.71

60

373.18