#21914

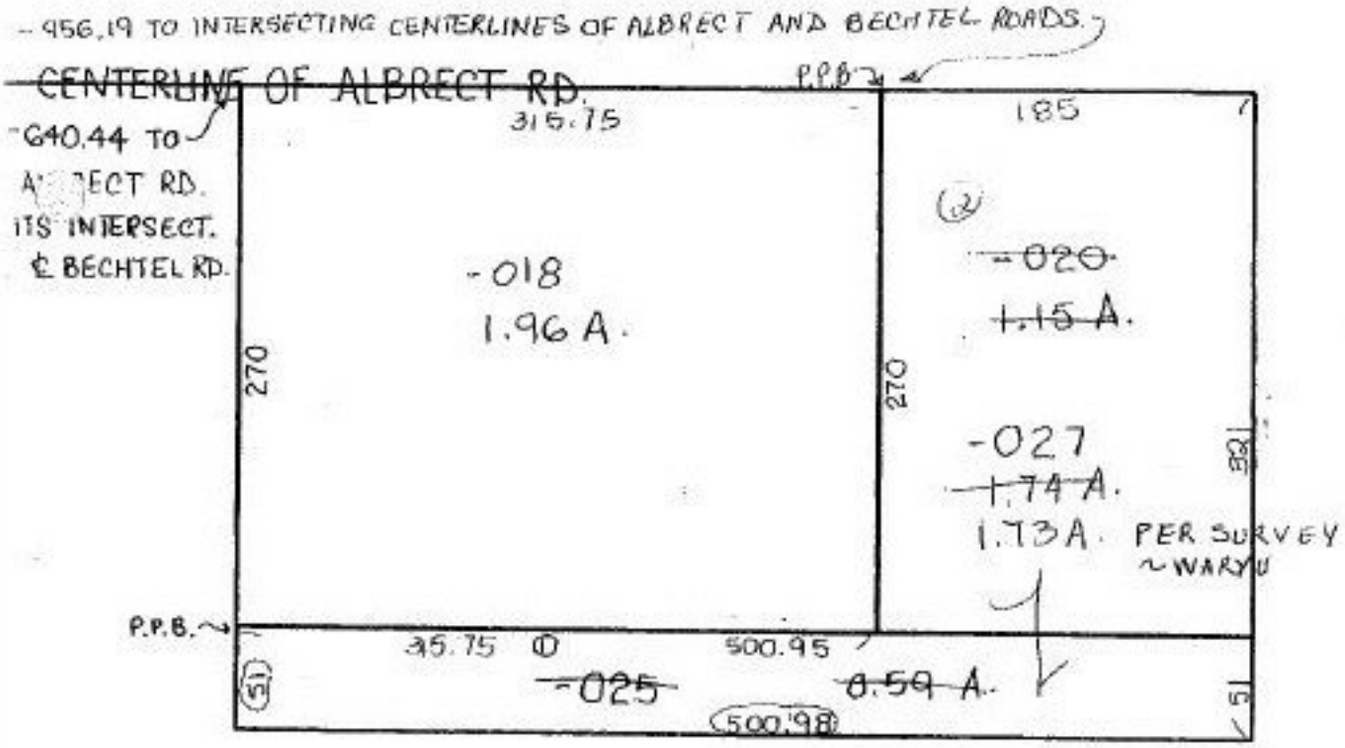
-956.19 TO INTERSECTING CENTERLINES OF ALBRECT AND BECHTEL ROADS.
CENTERLINE OF ALBRECT RD.
P.P.B.
-640.44 TO ALBRECT RD. ITS INTERSECT. ℄ BECHTEL RD.
315.75
185
(2)
-018
1.96 A.
~~-020~~
~~1.15 A.~~
270
270
-027
~~1.74 A.~~
1.73 A. PER SURVEY ~WARYU
P.P.B.
35.75
(1)
500.95
(51)
~~-025~~
~~0.59 A.~~
(500.98)