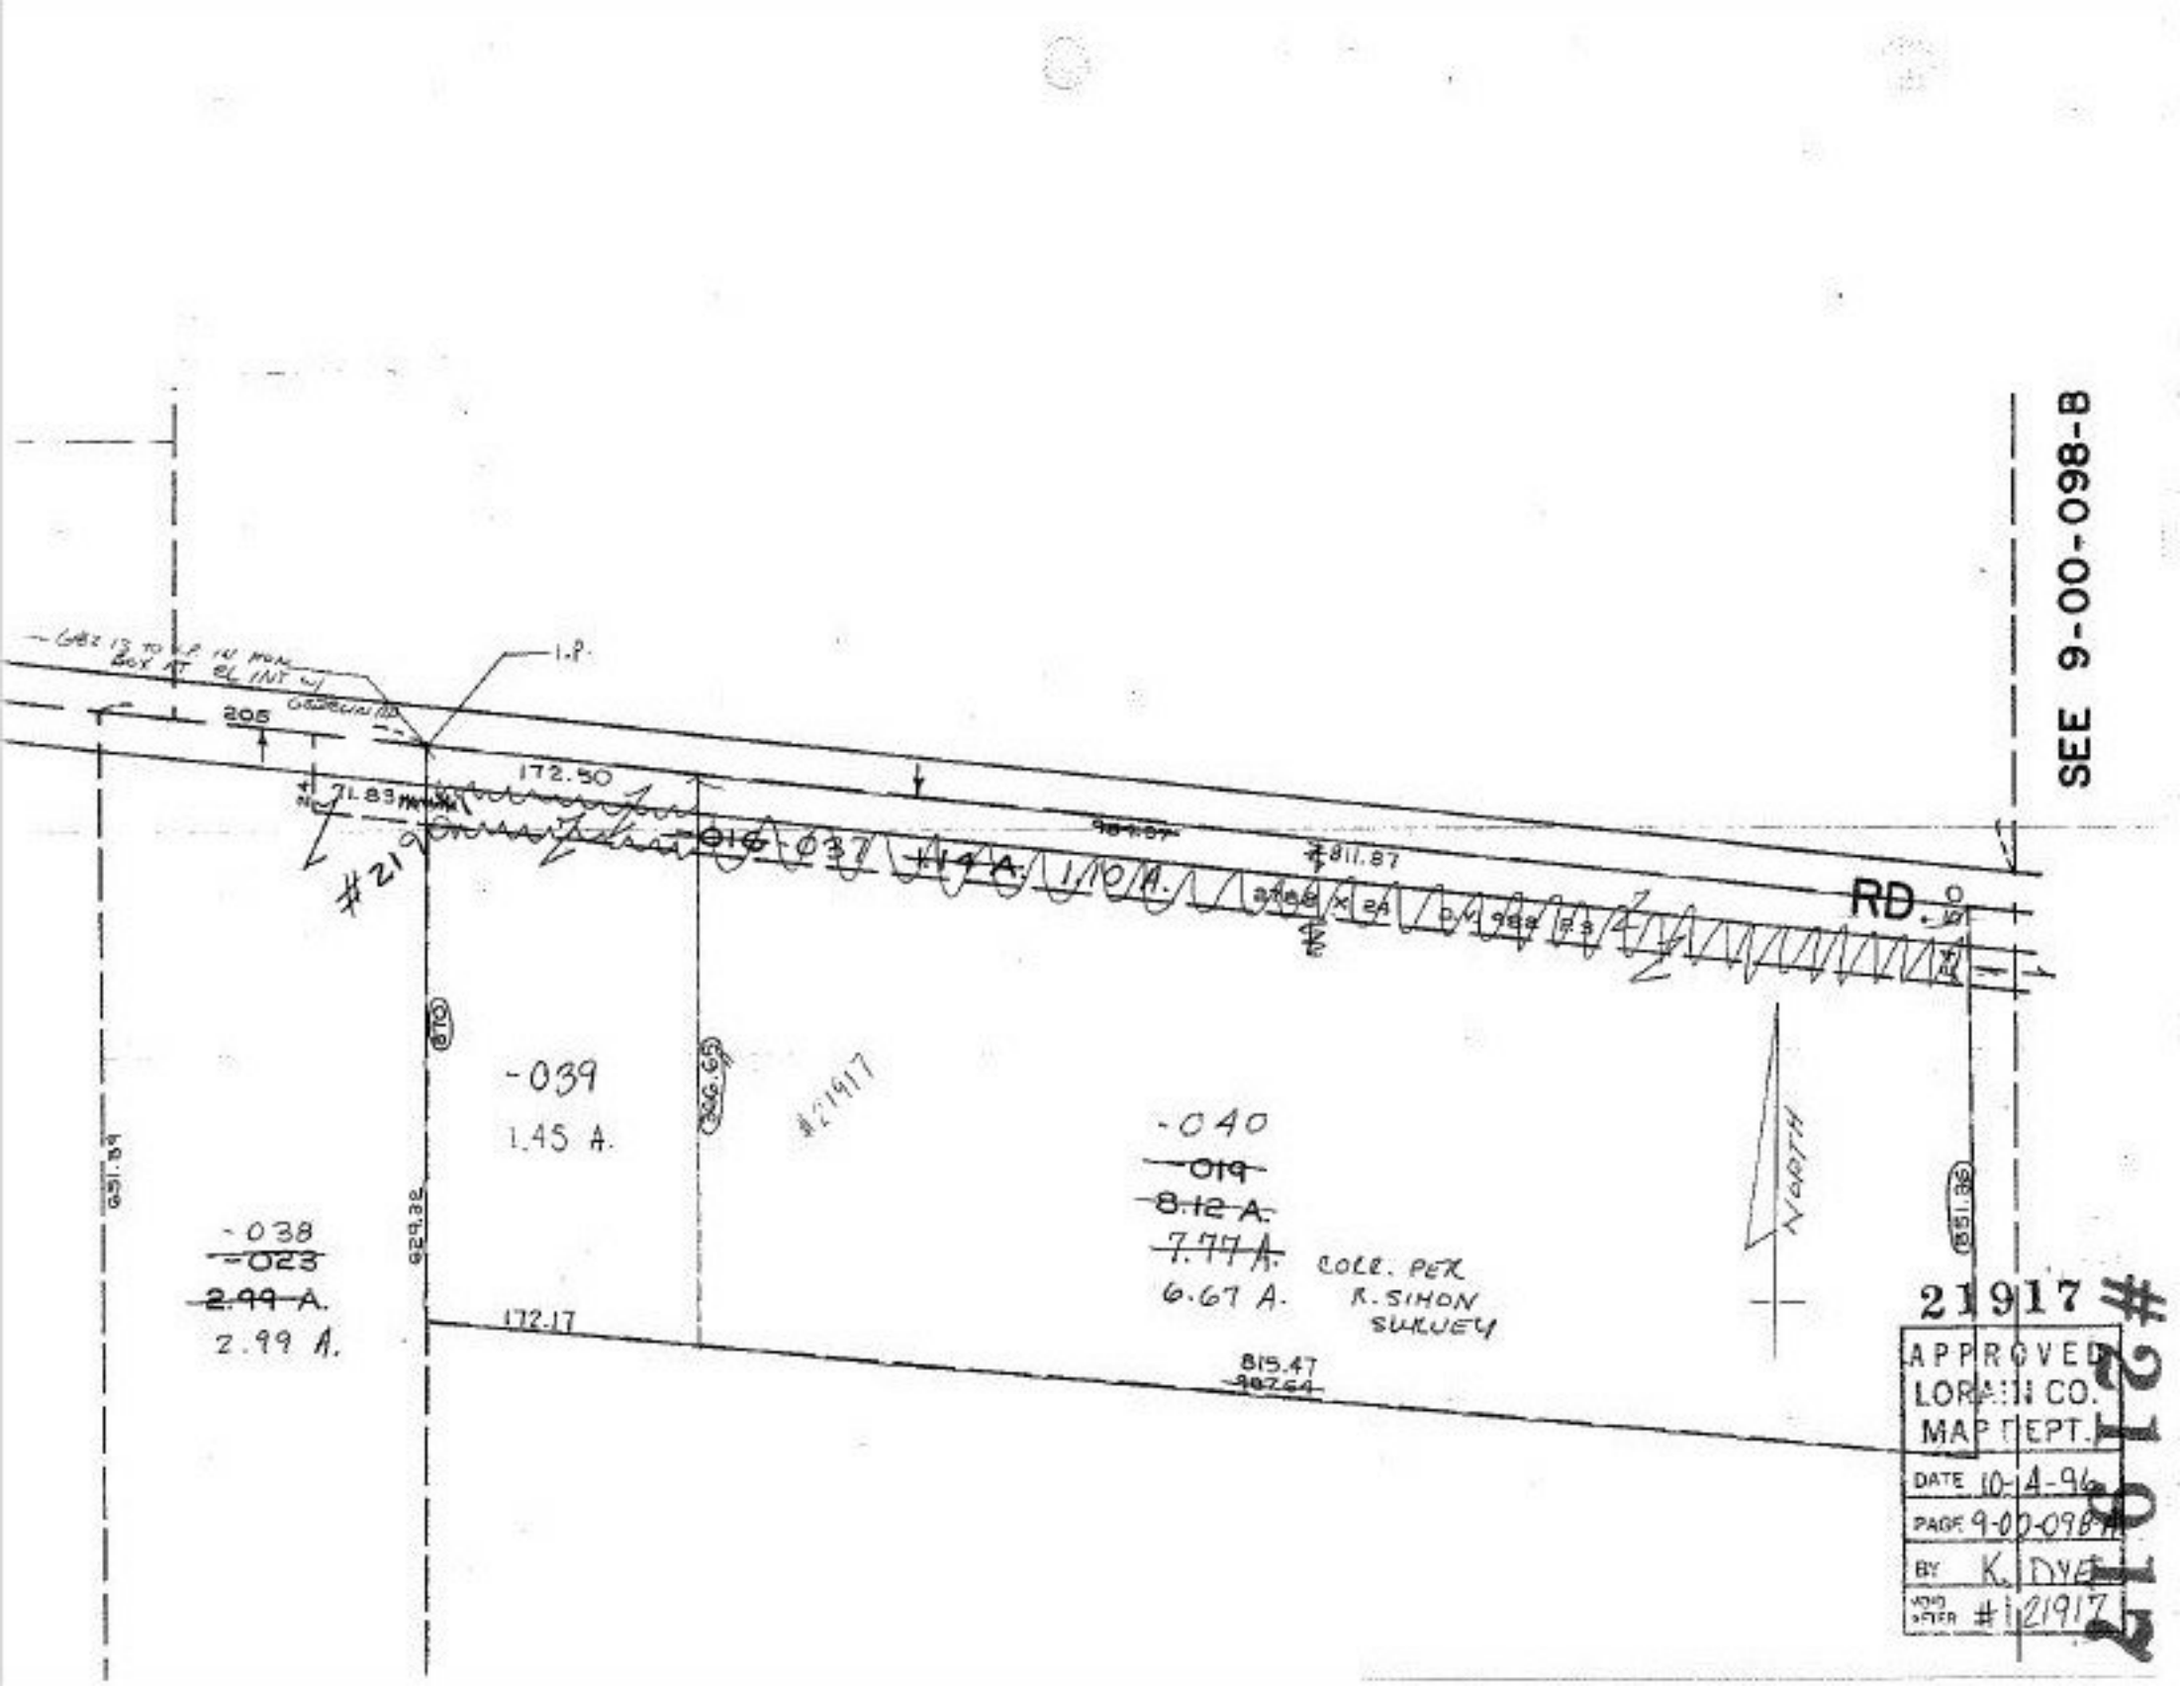
SEE 9-00-098-B
RD.
I.P.
205
172.50
811.87
#21
-016
-037
1.10 A.
-039
1.45 A.
-040
-019
8.12 A.
7.77 A.
6.67 A.
COLE. PER
R. SIHON
SURVEY
-038
-023
2.99 A.
2.99 A.
172.17
815.47
851.39
929.32
851.36
NORTH
#21917
APPROVED
LORAIN CO.
MAP DEPT.
DATE 10-4-96
PAGE 9-00-098A
BY K. DYE
VOID AFTER #121917
#21917